


BEGINNING AT THE INTERSECTION OF U.S. ROUTE # 5
AND STATE AID ROUTE #1 AND EXTENDING IN AN
EASTERLY DIRECTION 1,342.5 FEET TO THE VERMONT-
NEW HAMPSHIRE STATE LINE.

LENGTH OF PROJECT: 1,342.5 FEET = 0.254 MILE

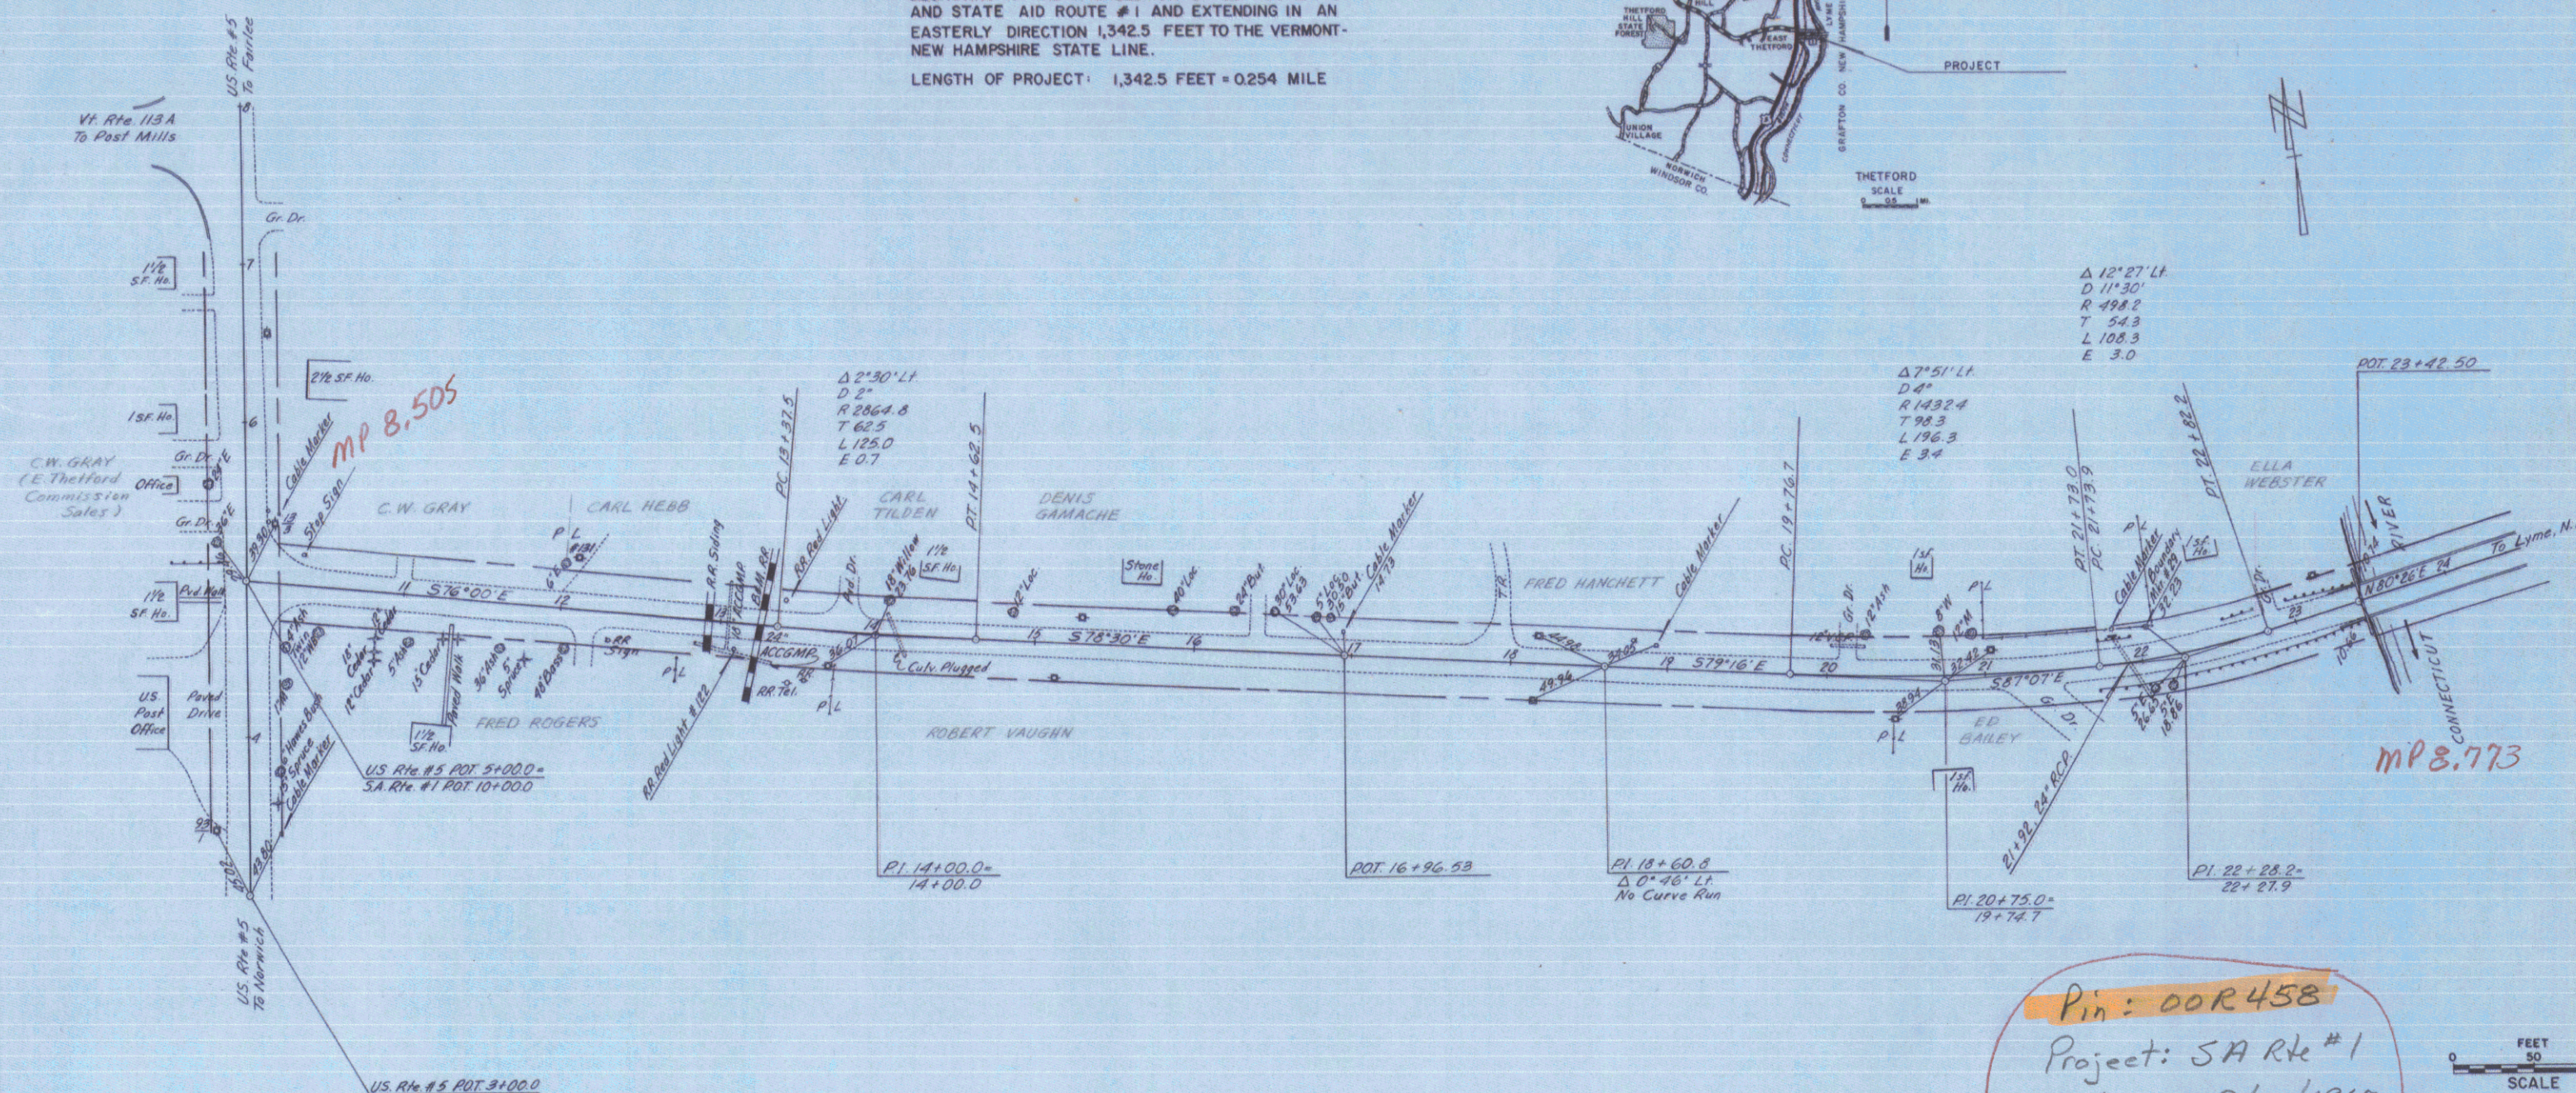

Pin: 00R458
Project: 5A Rte #1
Date: 09/01/1967
Town: Thetford
Route: VT 113

SURVEYED BY Fantoni DATE Sept 67
DRAWN BY A. Gagnon DATE Sept 67
TRACED BY A. Gagnon DATE Sept 67

THETFORD

PROJ. SA. Rte. #1

SHEET (1) OF 1

D-7