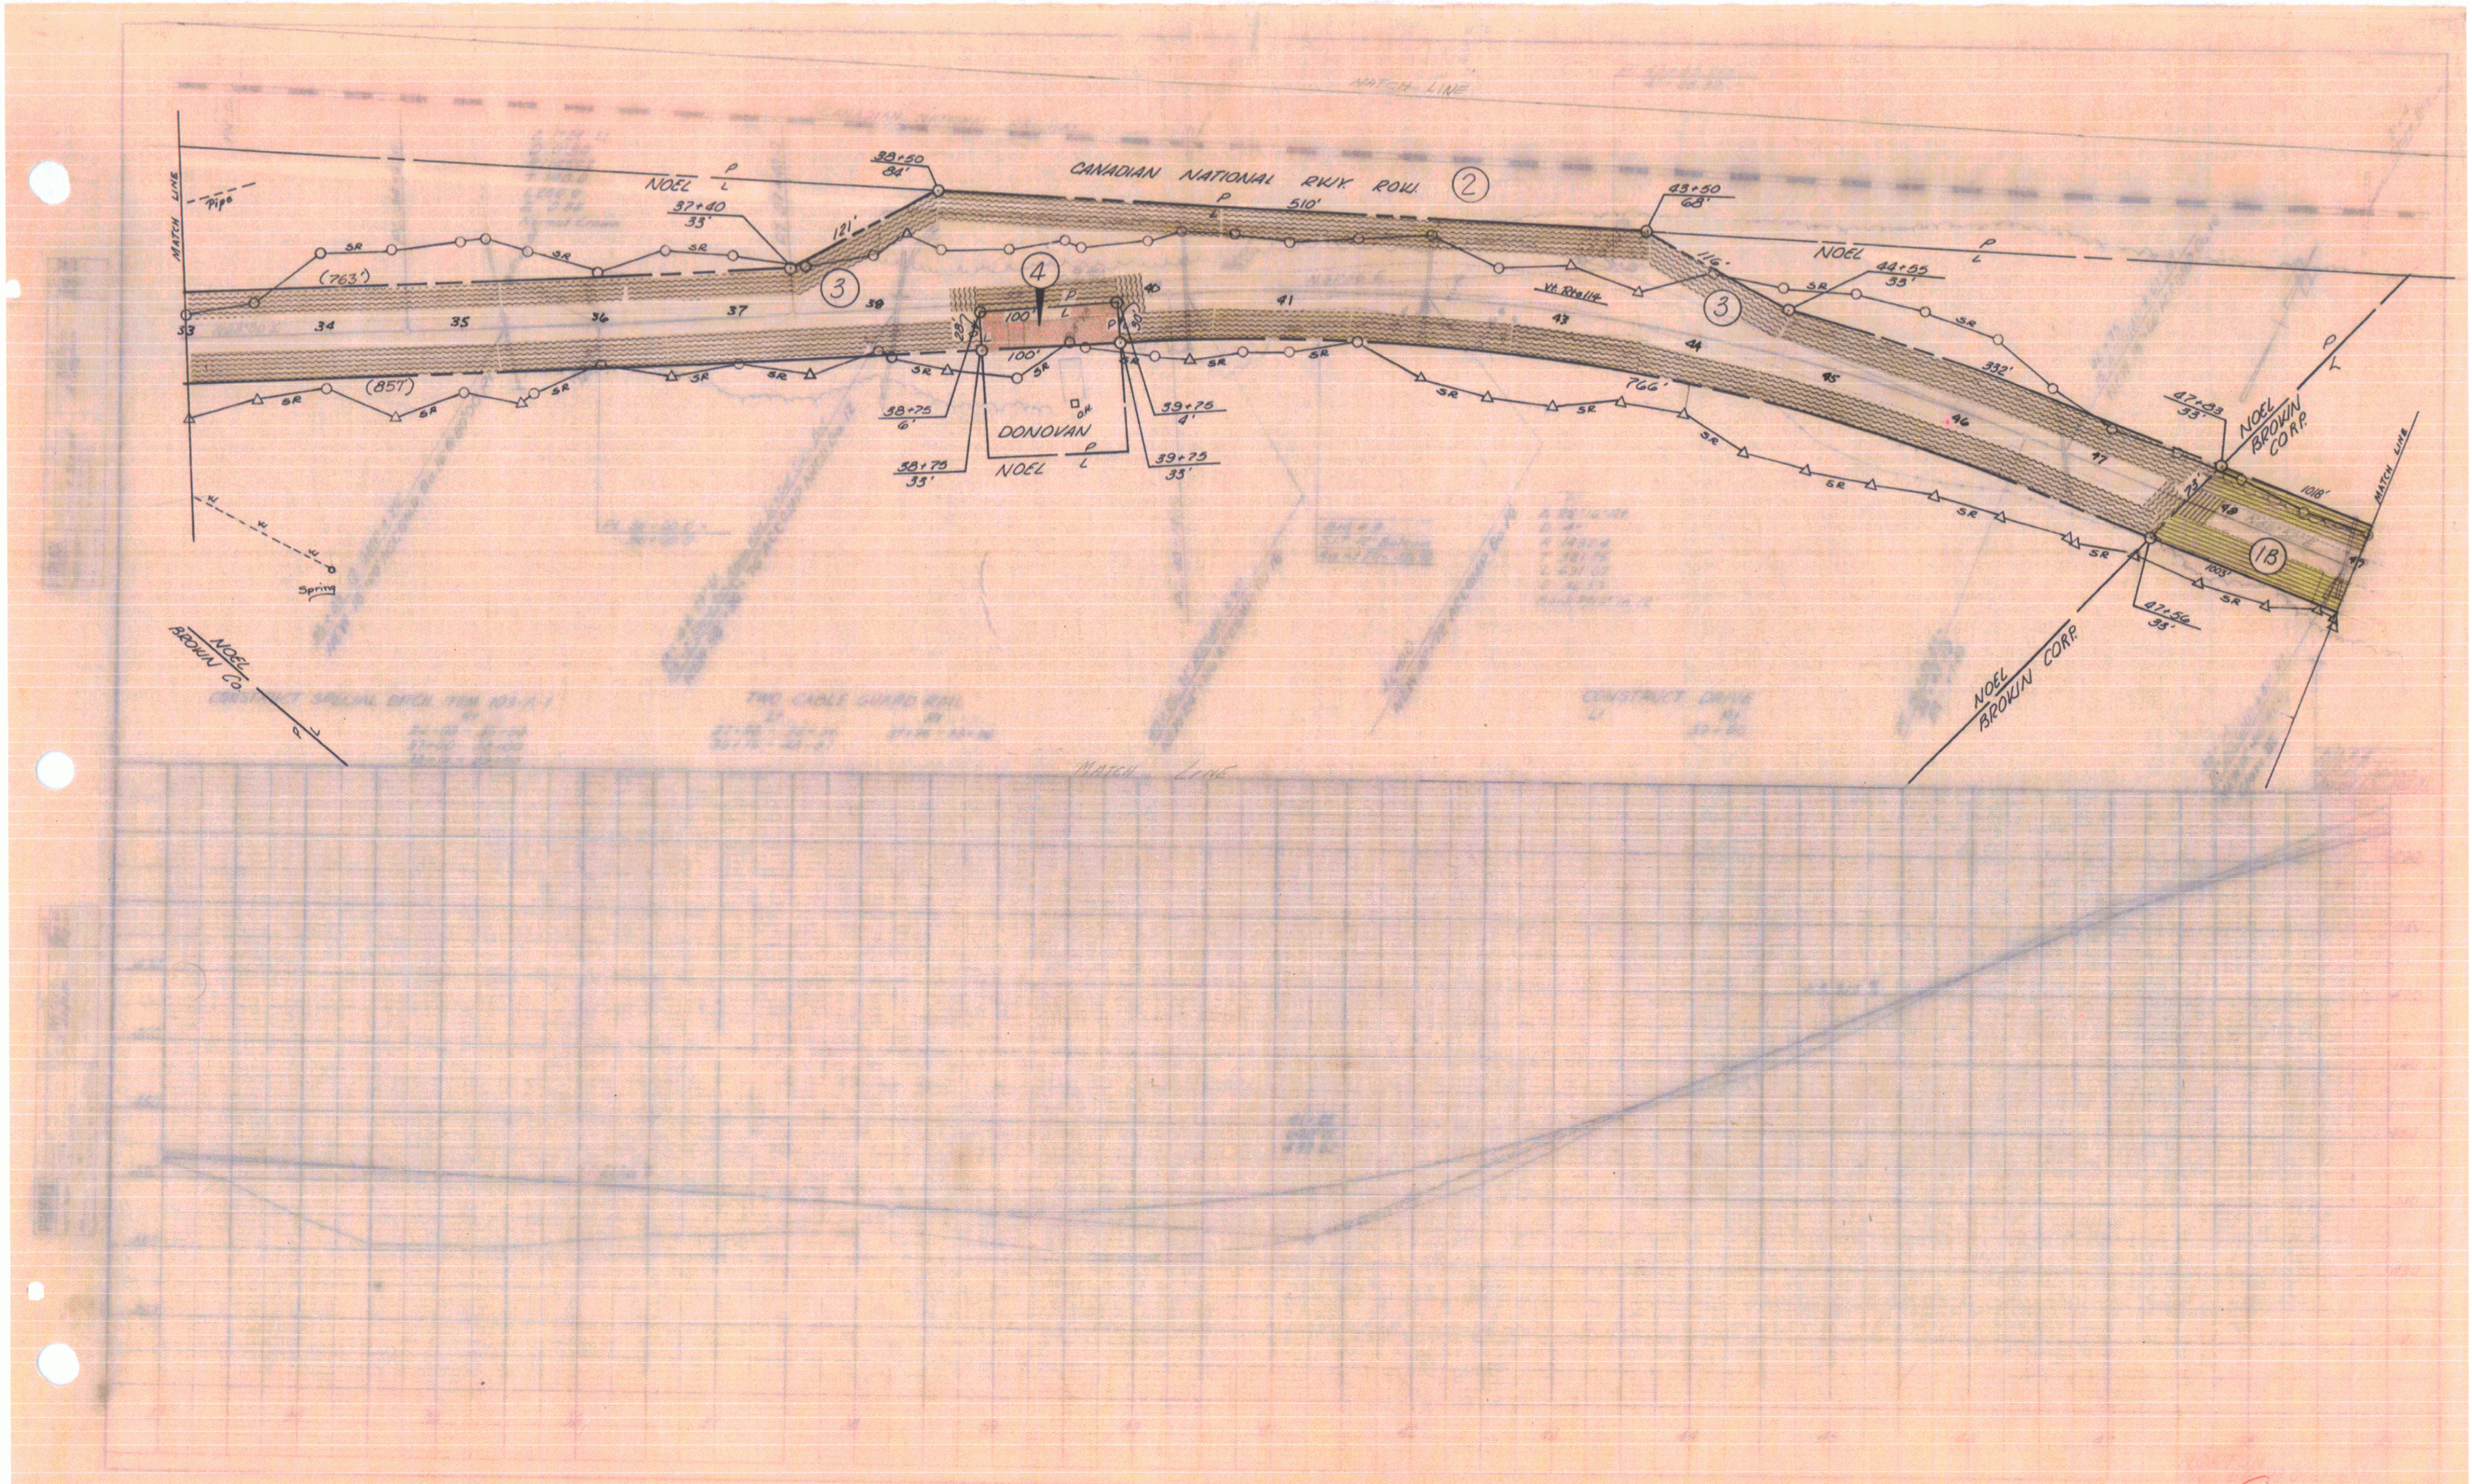
MATCH LINE
Pipe
NOEL P/L
38+50
84'
37+40
33'
121'
CANADIAN NATIONAL RWY. ROW.
②
P/L
510'
43+50
68'
116'
NOEL P/L
44+55
33'
Vt. Rte 114
(763')
(857')
SR
33
34
35
36
37
38
39
40
41
43
44
45
46
47
48
49
③
④
100'
P/L
28'
30'
38+75
6'
39+75
4'
O.H.
DONOVAN
38+75
33'
NOEL P/L
39+75
33'
766'
332'
47+83
33'
NOEL
BROWN CORP.
P/L
1018'
1003'
23'
1B
47+56
33'
NOEL
BROWN CORP.
MATCH LINE
Spring
NOEL
BROWN Co
MATCH LINE
CONSTRUCT DRIVE

⑪ 15