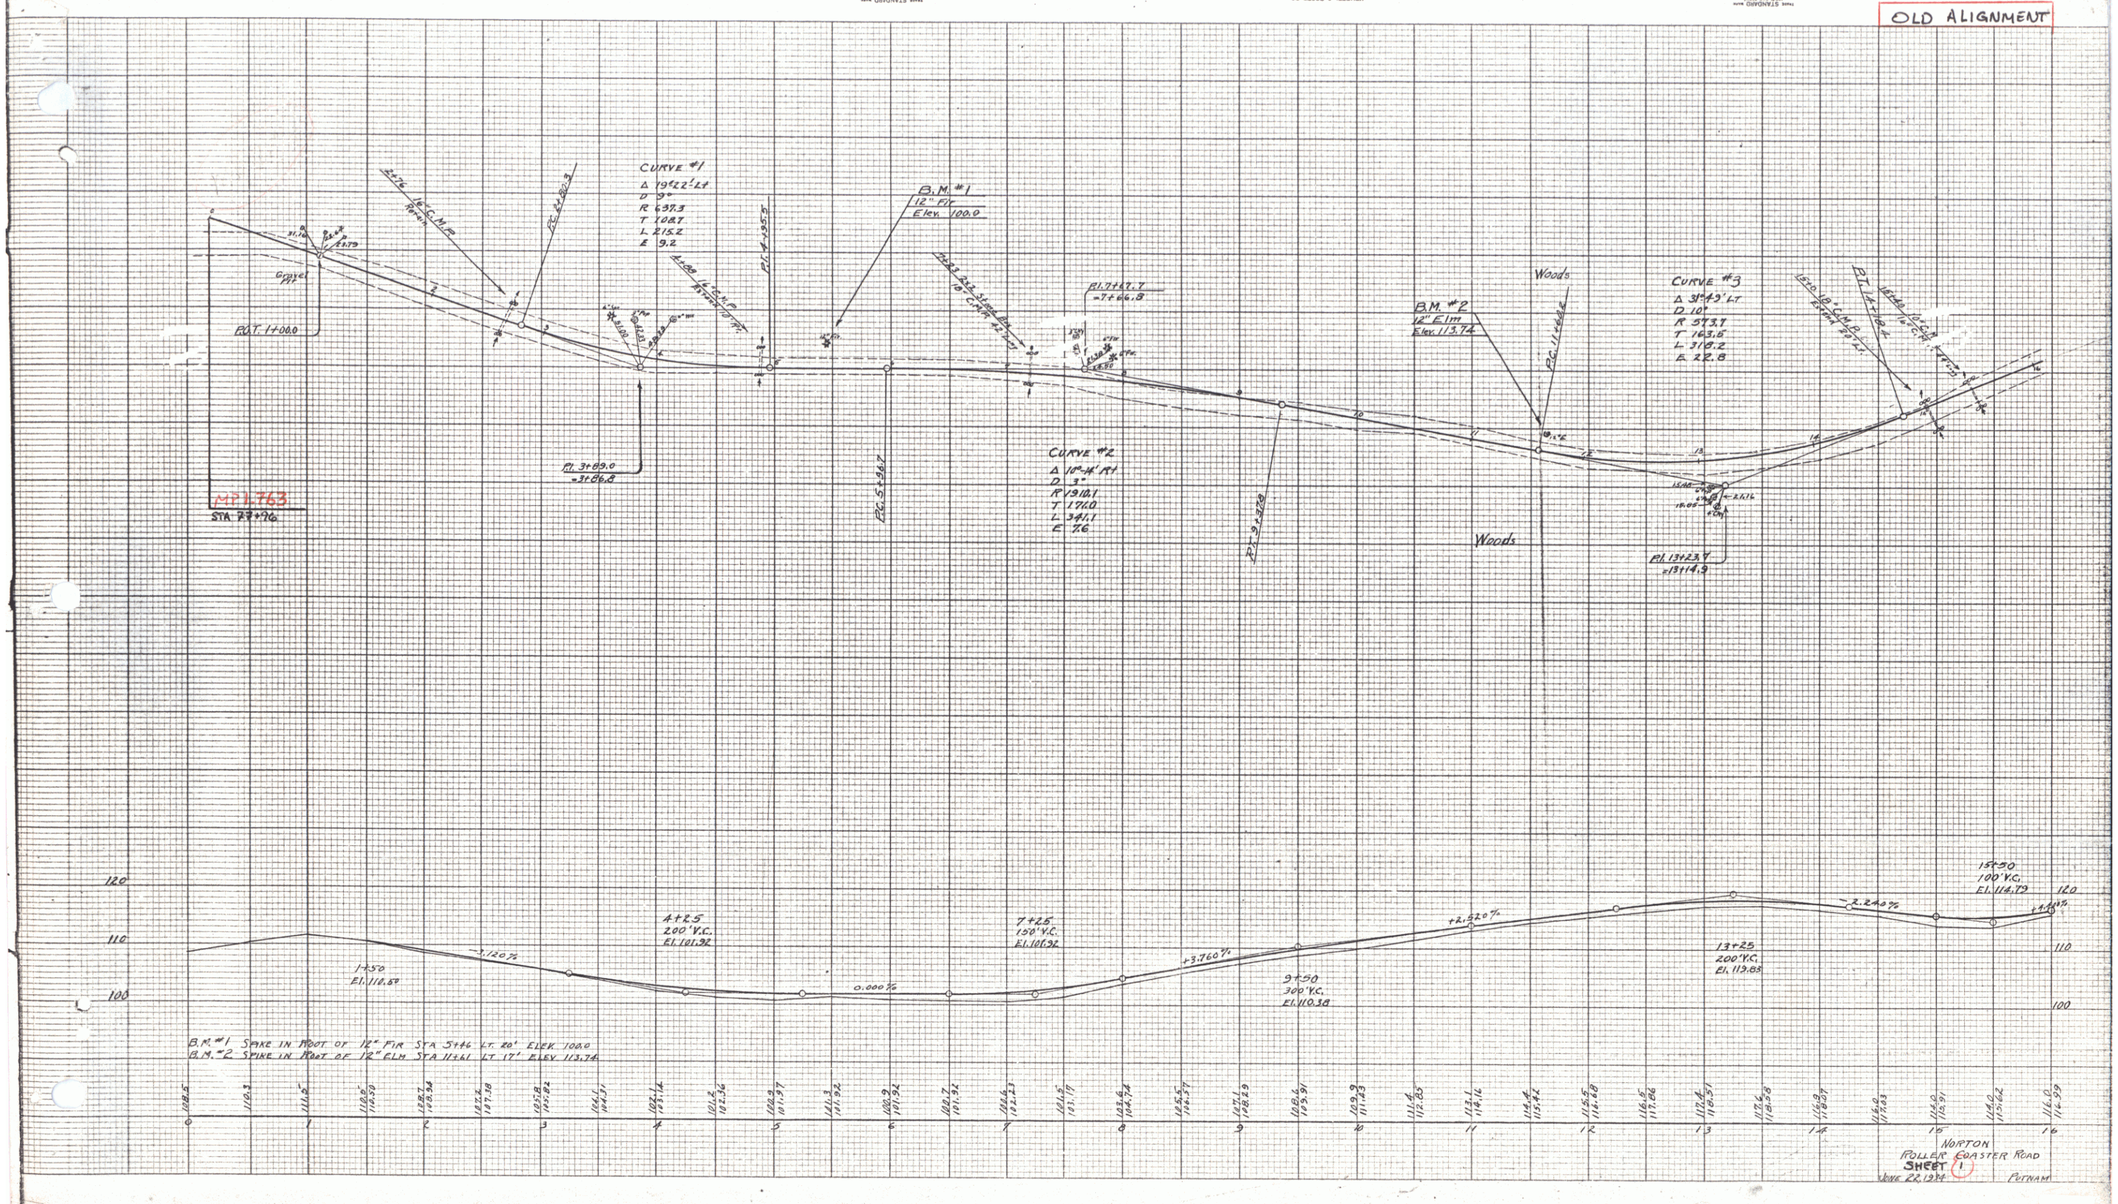OLD ALIGNMENT