POOR ORIGINAL COPY

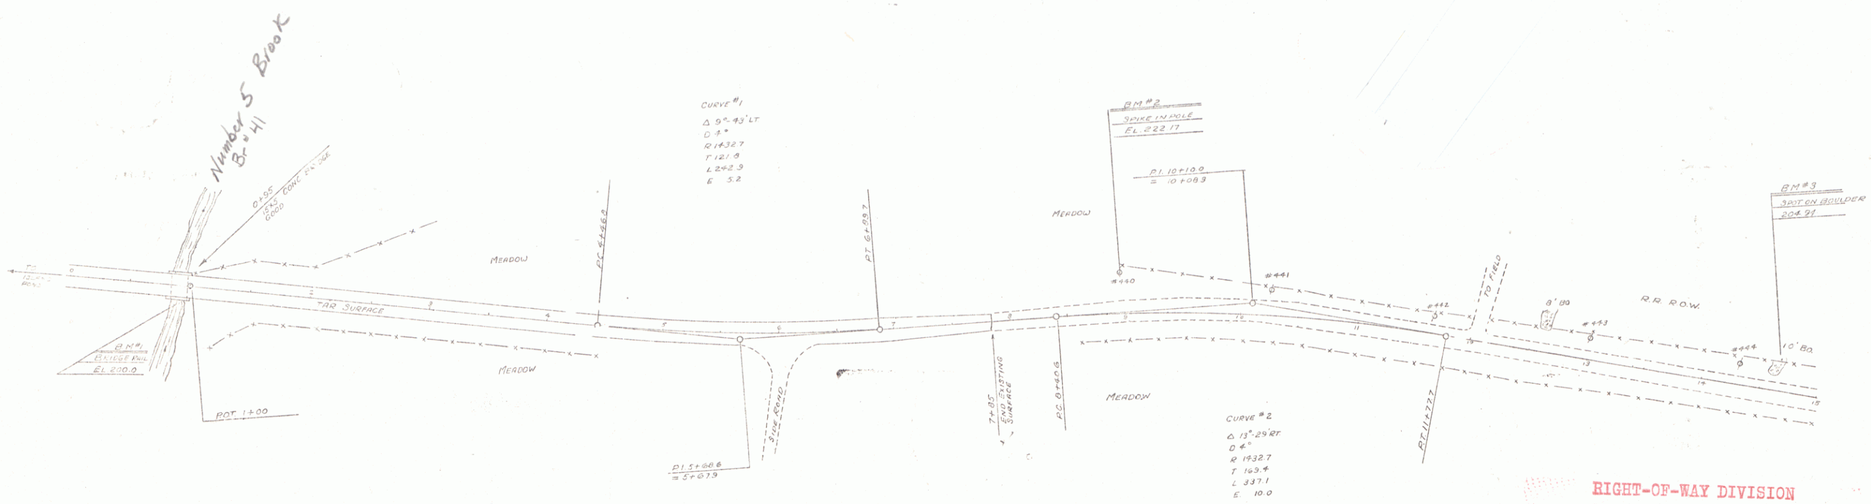

RIGHT-OF-WAY DIVISION
TOWN FILE
PERPETUAL
~~Town~~ Rte of VT114
(To Be Returned To R.O.W. Division)

TOWN OF NORTON
Project: 1733
Pin # 00R462
Route VT114
Date 1/1/1940
MP 3.667-5.357

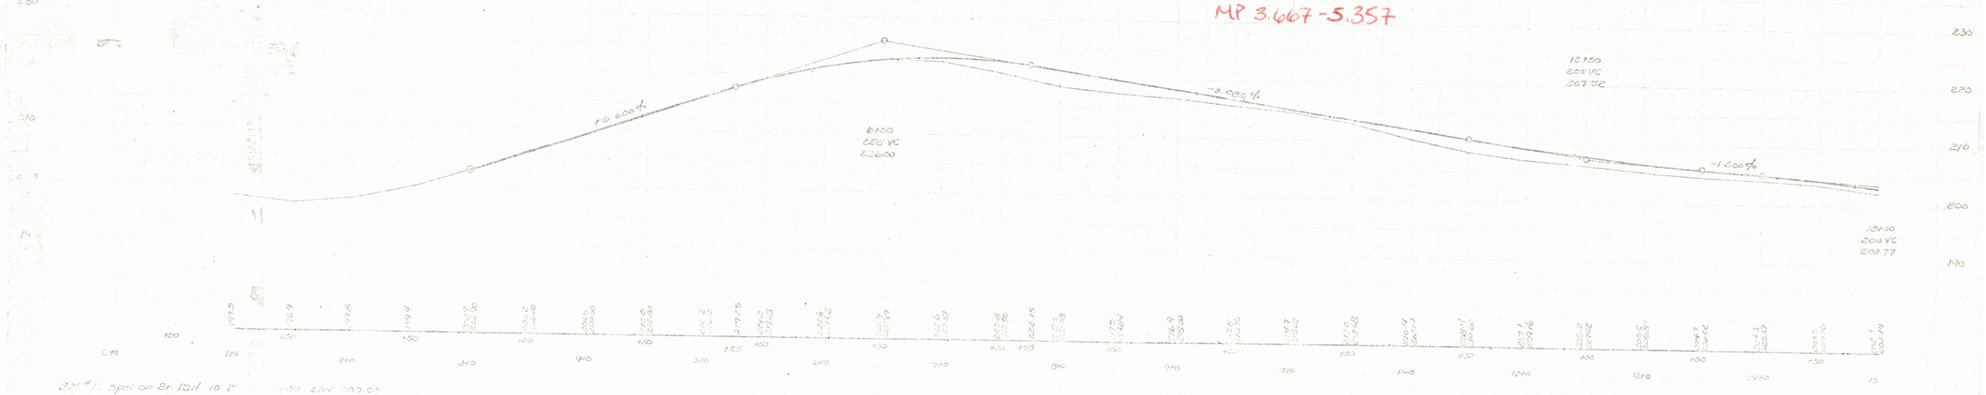

NORTON, FOLLER & CONSTR. HIGHWAY

SHEET 1

DIST. #9 Plans