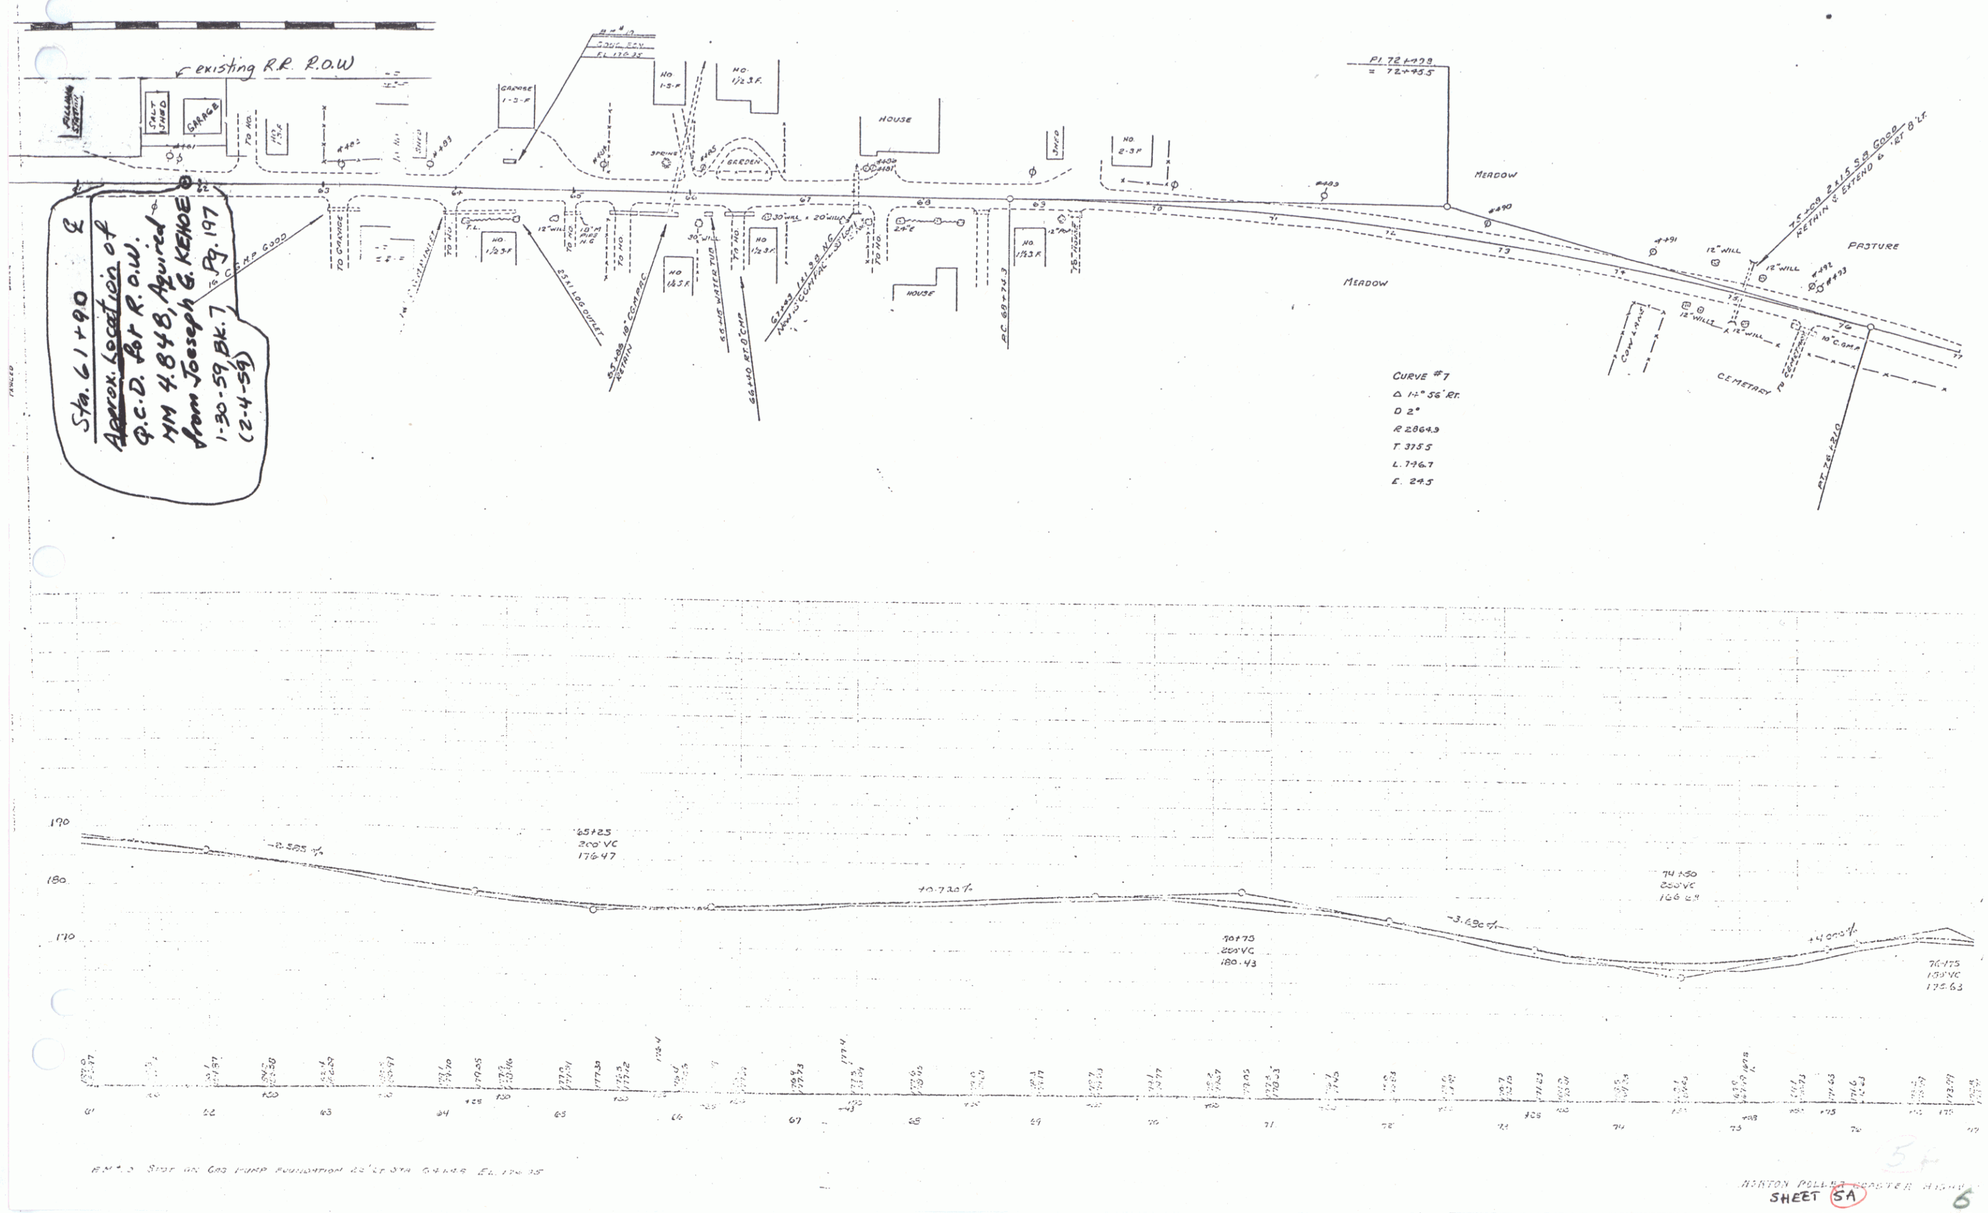
existing R.R. R.O.W
GARAGE
HOUSE
MEADOW
PASTURE
CEMETERY
CURVE #7
Δ 1°-56' Rt.
D 2°
R 2864.9
T 375.5
L 796.7
E 24.5
Sta. 61+90
Approx. Location of
Q.C.D. for R.O.W.
MN 4.848, Aquired
from Joseph G. KEHOE
1-30-59 Bk. 7
Pg. 197
(2-4-59)

SHEET 5A

6