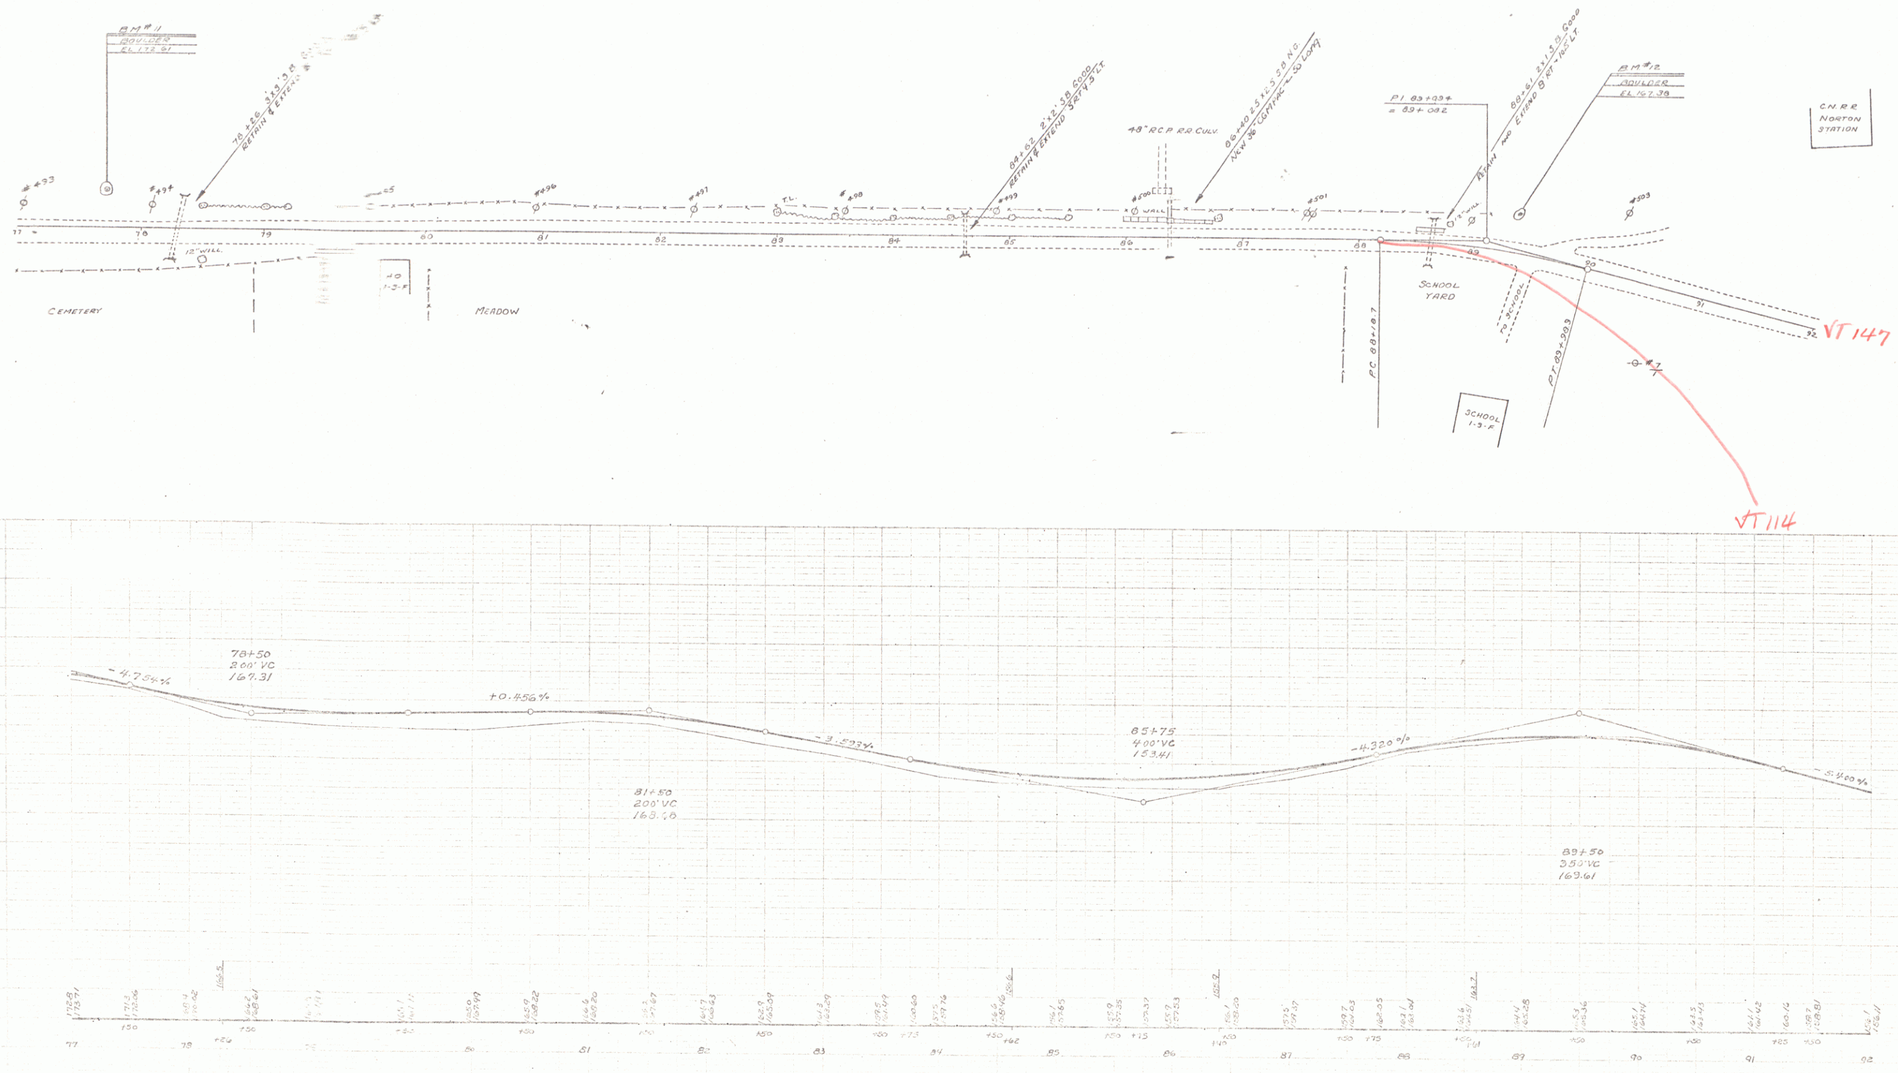

NORTON ROLLER COASTER HIGHWAY
SHEET 6

7