FED. ROAD DIST. NO.	STATE	PROJ. NO.	FISCAL YEAR	SHEET NO	TO SH
9	VT.	2090		17	2

PySt WAR SECONDARY

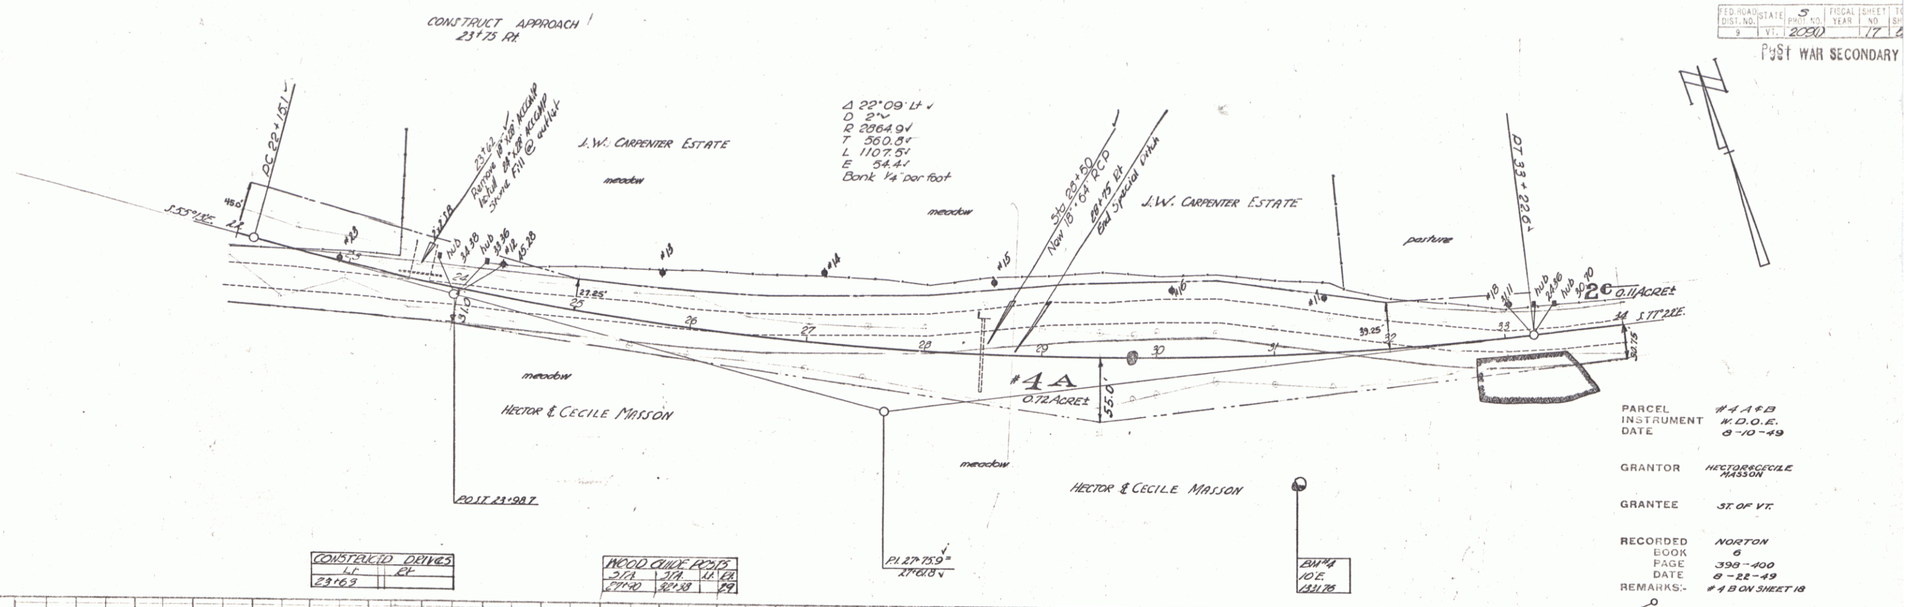

5