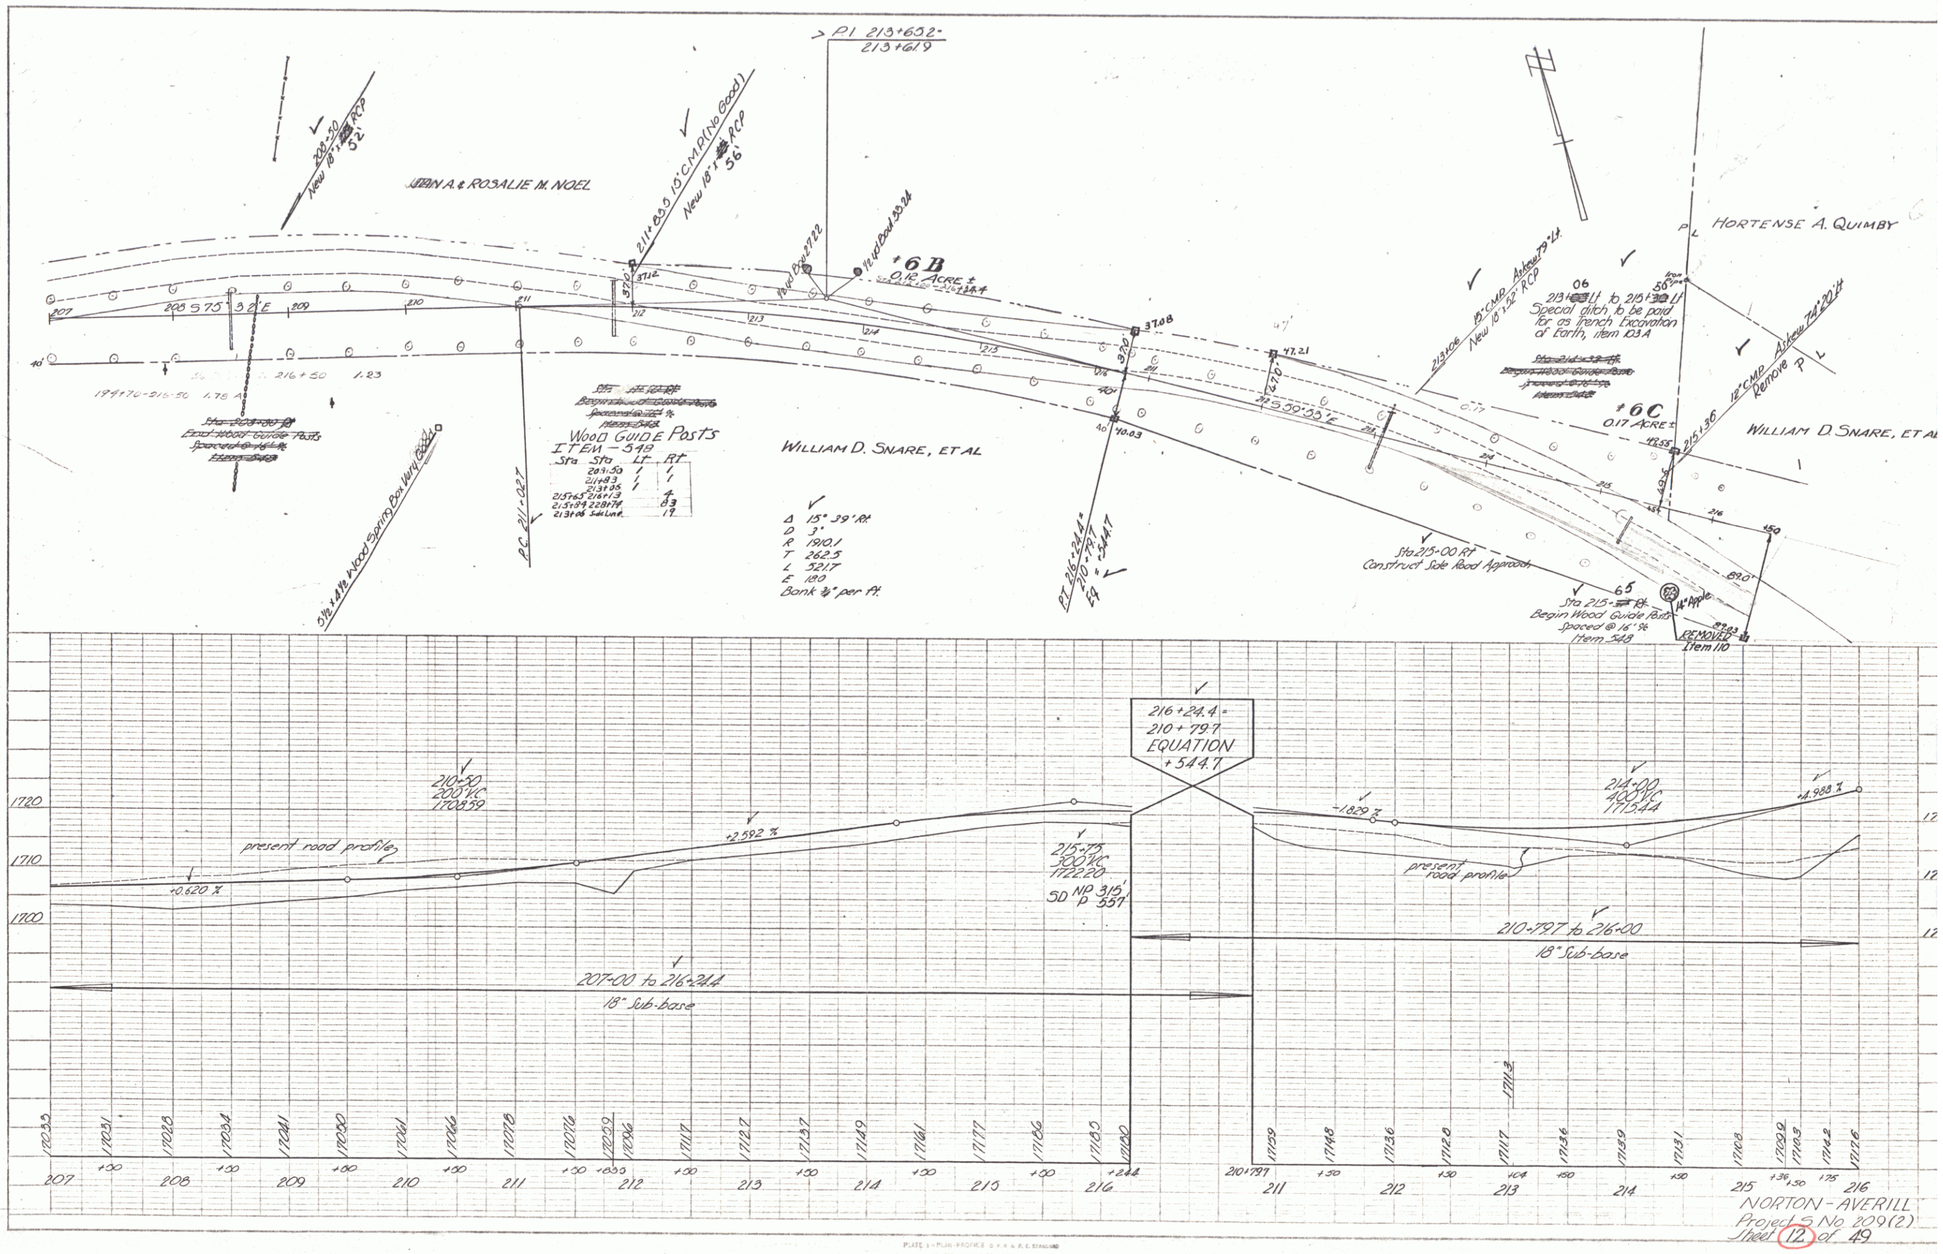

PLAN
SURVEYED 7/32
PLOTTED 7/32
NOTE BOOK
NO.
DESIGNED Lewis
CHECKED Palmer
PLANS CHECKED
M.S. ROTTED
Palmer

PROFILE
SURVEYED 7/32
PLOTTED 7/32
NOTE BOOK
NO.
DESIGNED Lewis
CHECKED Palmer
M.S. ROTTED
STRUCTURE NOTES CHKD.

NORTON - AVERILL
Project S No 209(2)
Sheet 12 of 49

5