THREE CABLE GUARD RAIL
STA. STA. POS.
169+98 123+98 RT.

BM#24

Δ	28° 20' LT.
D	5°
R	1146.3
T	289.3
L	566.7
E	35.9

BANK 3/4" PER FT.

CLEARING & GRUBBING

STA.	STA.	POS.
167+70	169+10	LT.
170+00	177+25	RT.

PARCEL	INSTRUMENT KIND	DATE	GRANTOR	GRANTEE	RECORDED CANAAN BOOK	PAGE	DATE	REMARKS
12 A,B,C	W.D.O.E.	May 11, 54	Arnold M. Jackson	St. of Vt.	O	51	May 14, 54	
8 E	W.D.O.E.	June 3, 54	Heirs of Abner M. Haynes Est.	St. of Vt.	R	550, 551, 552	June 5, 54	
14 A,B,C,D	W.D.O.E.	June 1, 55	Gilbert & Blanche Breault	St. of Vt.	S	60A & 61A	July 28, 55	See also sheet 17

Br 49

Sta 170+00 48" CMP 44'+20' Rt. (POOR)
NEW 48" x 74' ACCESS
L.H. INLET & OUTLET
CONSTRUCT INLET DITCH

#12B
1.20 acres ±
155+54 - 178+77

ARNOLD M. JACKSON

Sta 172+45 15" RCP 77'+40' Rt.
REMOVE, RELAY 36' & EXTEND 20'
WITH NEW 15" RCP
CONSTRUCT INLET
REMOVE, RELAY 22' NEW 24" RCP

P.T. 174 + 65.8

Sta 175+80 15" RCP
REMOVE, RELAY 36' & EXTEND 20'
WITH NEW 15" RCP
L.H.W. INLET

ABNER HAYNES ESTATE

#8E
0.05 acre ±
178+77 - 180+57 pasture

#12A
1.20 acre ±
133+70 - 169+88

167+89 - 170+18 RT.
6" x 230' PACCAR UNDERGRATE

POST 170+31.7

PI. 171+88.4 =
171+76.5

POST 173+82.6

#12C
0.52 acre ±
170+83 - 179+19

ARNOLD M. JACKSON

REMOVE
ITEM 110

Sta 177+05 24" RCP 79'+40' Rt.
REMOVE, RELAY 36' & EXTEND 16'
WITH NEW 24" RCP
L.H.W. INLET

BM#25

#14A GILBERT & BLANCHE BREAULT
(A 0.449±) STA 179+19 - 186+58
WDOE 6/25/55
RECORDED: CANAAN-BK S-PG 60A/61A- 7/28/55

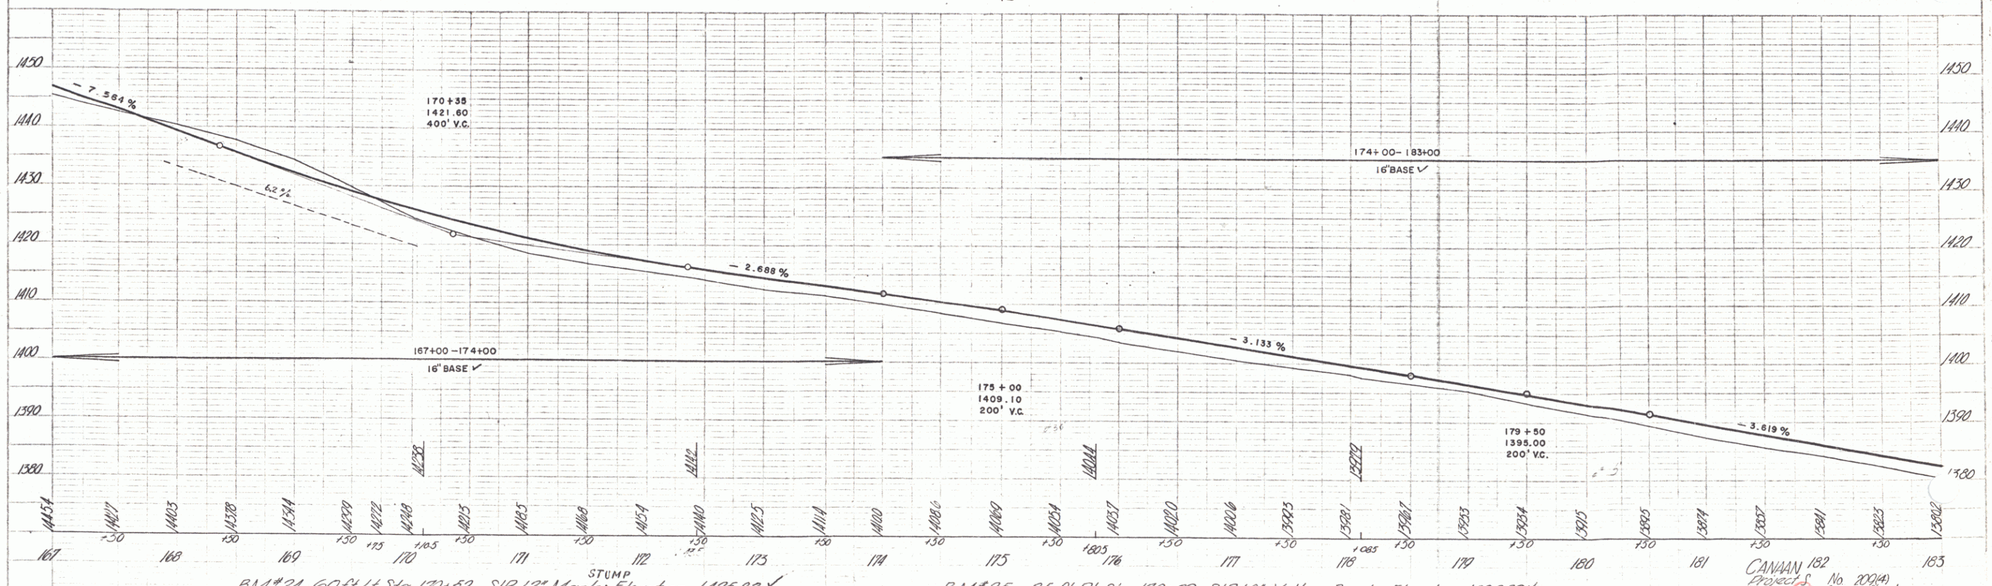

BM#24 60 ft. Lt. Sta 170+52 S.I.R. 12" Maple Elevation 1425.83
BM#23A Lt. Sta. 168+25 S.I.R. 12" Dead 1439.10

BM#25 25 ft. Rt. Sta 178+39 S.I.R. 18" Yellow Birch Elevation 1392.29
BM#24A Lt. Sta. 170+80 S.I.R. 10" Spr. Elevation 1424.45
BM#25A Rt. Sta. 177+30 S.I.R. 18" Dead Maple Elevation 1396.09

CANAAN 182
Project S No. 200(4)
Sheet 16 of 101 Sheets