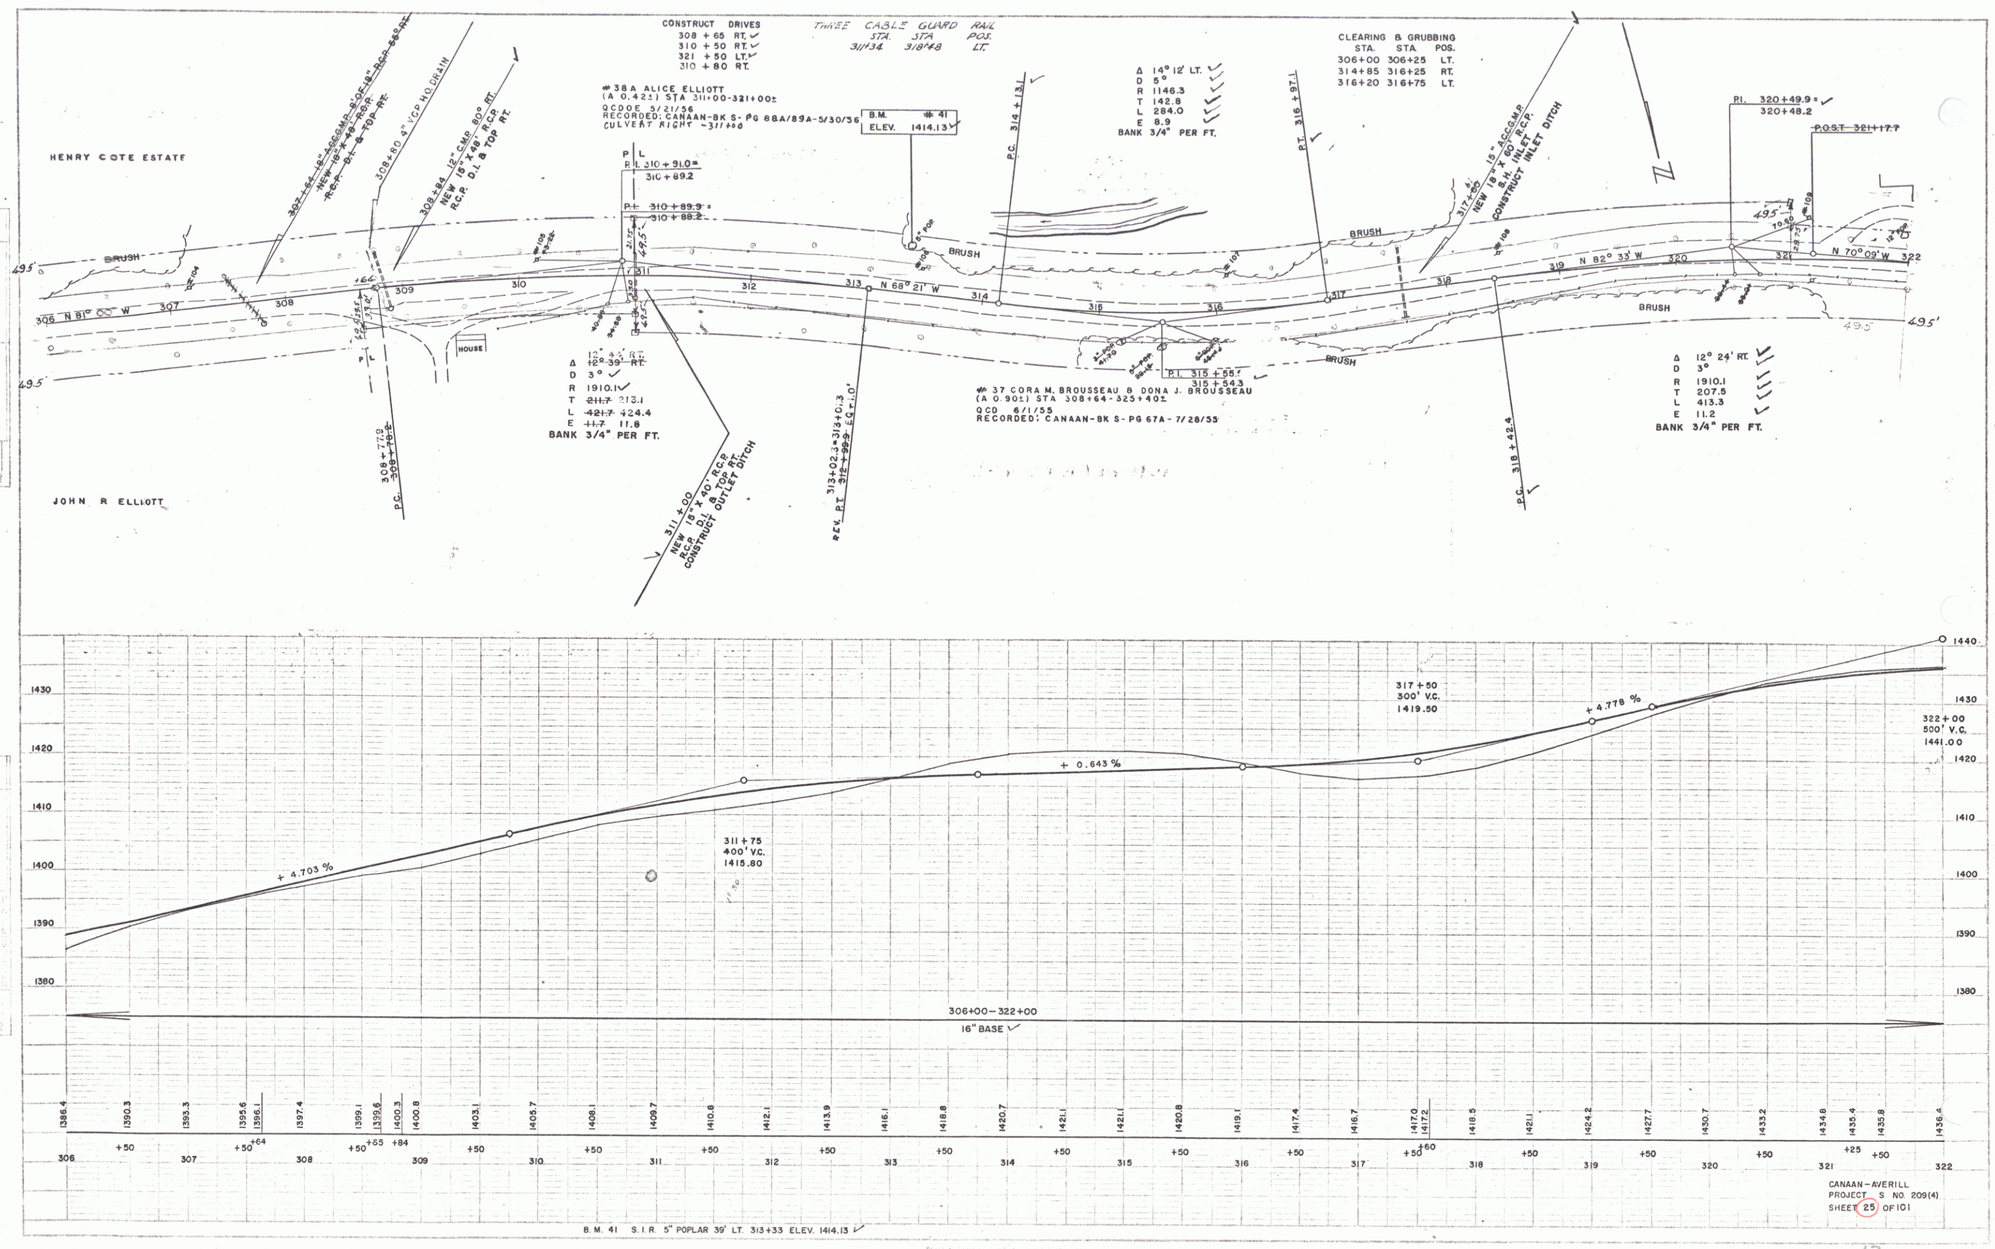
CONSTRUCT DRIVES
308 + 65 RT.
310 + 50 RT.
321 + 50 LT.
310 + 80 RT.
THREE CABLE GUARD RAIL
STA. STA POS.
311+34 318+48 LT.
CLEARING & GRUBBING
STA. STA POS.
306+00 306+25 LT.
314+85 316+25 RT.
316+20 316+75 LT.
HENRY COTE ESTATE
JOHN R ELLIOTT
#38A ALICE ELLIOTT
(A 0.42±) STA 311+00-321+00±
QCDOE 3/21/56
RECORDED: CANAAN-BK S-PG 88A/89A-5/30/56
CULVERT RIGHT ~311+86
B.M. #41
ELEV. 1414.13
Δ 14° 12' LT.
D 5°
R 1146.3
T 142.8
L 284.0
E 8.9
BANK 3/4" PER FT.
PI. 320+49.9
320+48.2
POST 321+17.7
BRUSH
HOUSE
N 81° 00' W
N 68° 21' W
N 82° 33' W
N 70° 09' W
Δ 12° 39' RT.
D 3°
R 1910.1
T 213.1
L 424.4
E 11.8
BANK 3/4" PER FT.
#37 CORA M. BROUSSEAU & DONA J. BROUSSEAU
(A 0.90±) STA 308+64-325+40±
QCD 6/1/55
RECORDED: CANAAN-BK S-PG 67A-7/28/55
PI. 315+55.7
315+54.3
Δ 12° 24' RT.
D 3°
R 1910.1
T 207.5
L 413.3
E 11.2
BANK 3/4" PER FT.
NEW 18" x 40' RCP
R.C.P. D.I. & TOP RT.
NEW 18" x 48' RCP
R.C.P. D.I. & TOP RT.
NEW 18" x 40' RCP
R.C.P. D.I. & TOP RT.
CONSTRUCT OUTLET DITCH
NEW 18" x 40' RCP
R.C.P. D.I. & TOP
CONSTRUCT INLET DITCH
+ 4.703 %
+ 0.643 %
+ 4.778 %
311+75
400' V.C.
1415.80
317+50
300' V.C.
1419.50
322+00
500' V.C.
1441.00
306+00 – 322+00
16" BASE
B.M. 41 S.I.R. 5" POPLAR 39' LT. 313+33 ELEV. 1414.13
CANAAN-AVERILL
PROJECT S NO. 209(4)
SHEET 25 OF 101
13