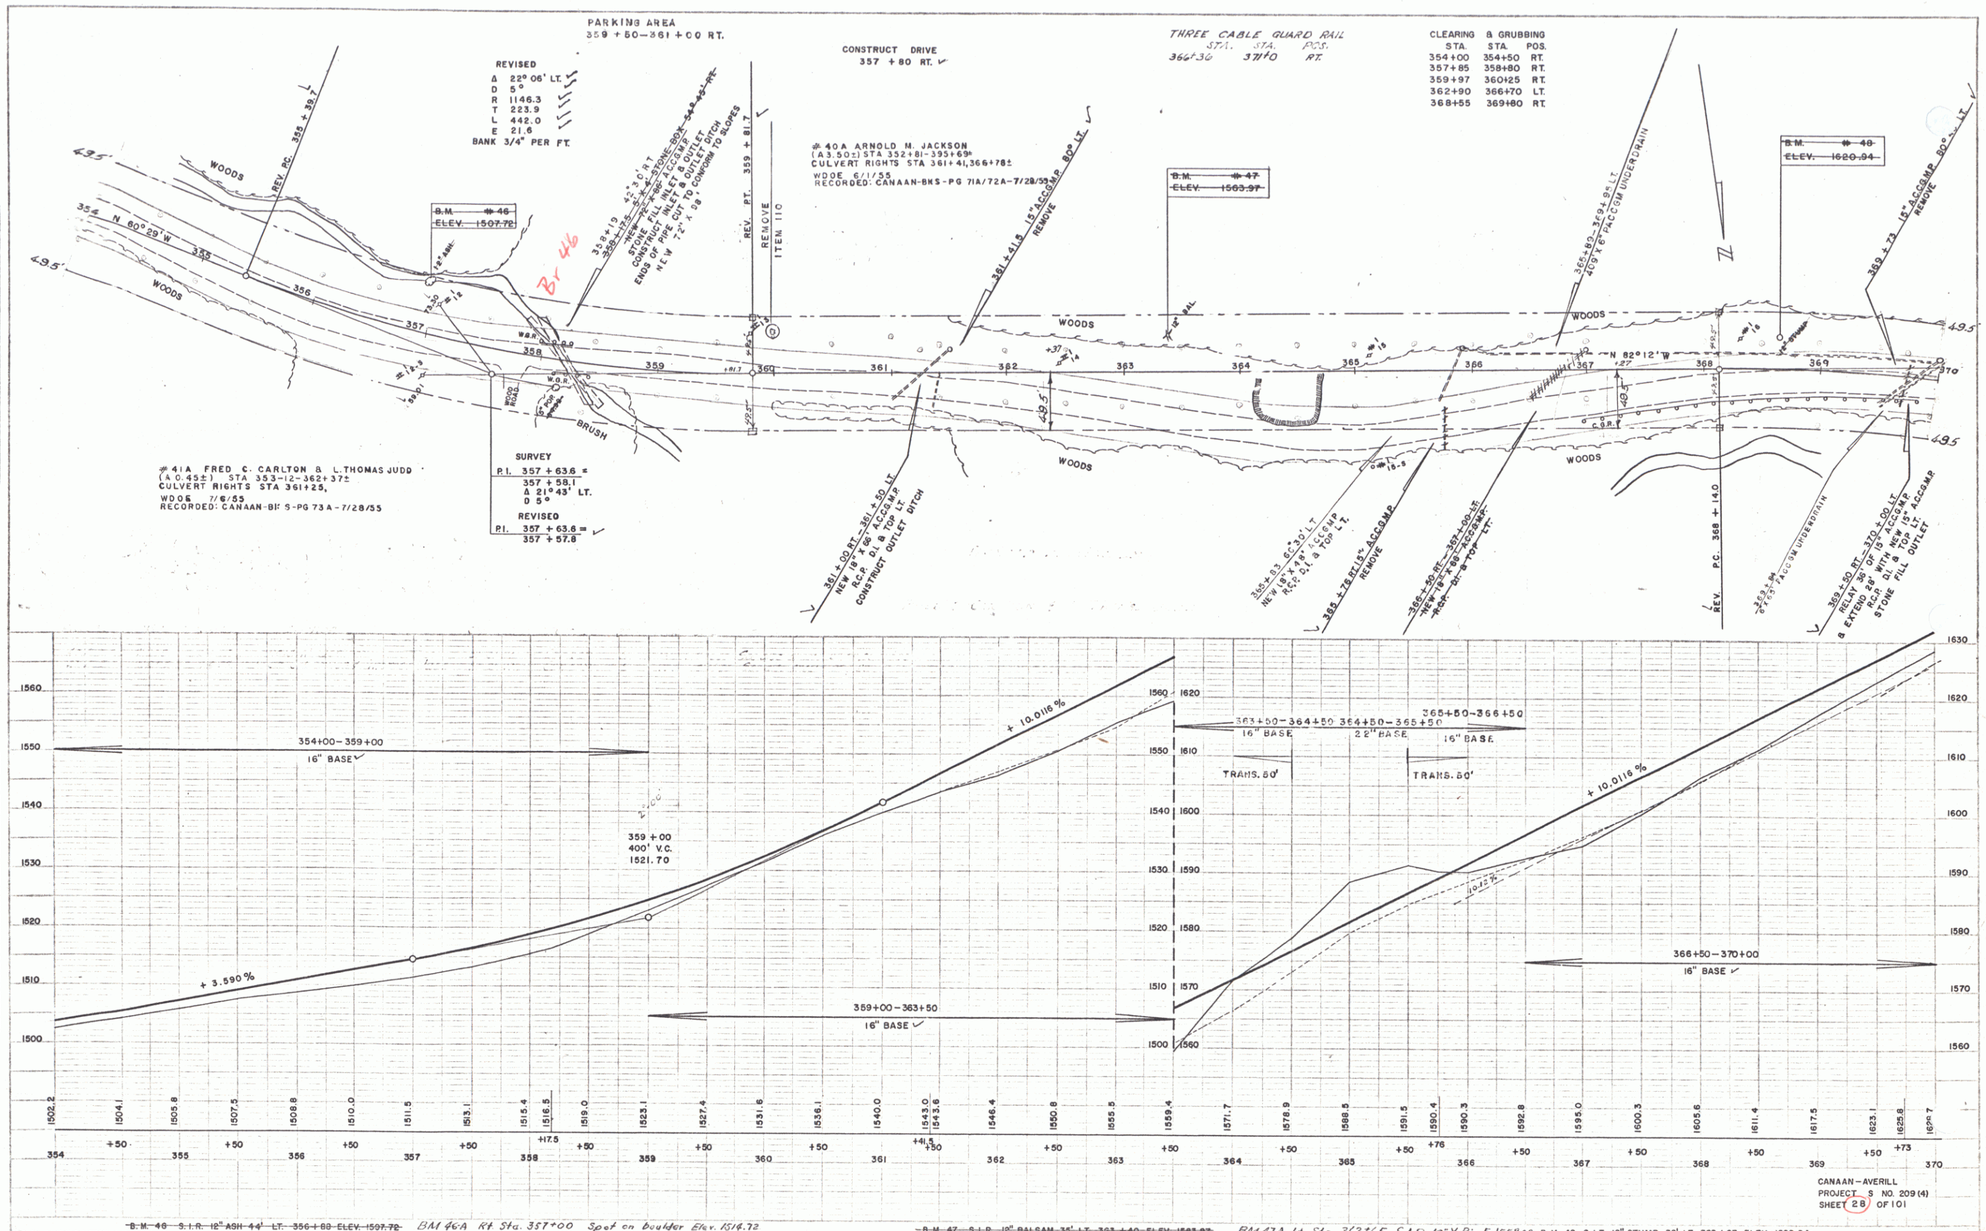

~~B.M. 46 S.I.R. 12" ASH 44' LT. 356+88 ELEV. 1507.72~~ BM 46A Rt. Sta. 357+00 Spot on boulder Elev. 1514.72

~~B.M. 47 S.I.R. 12" BALSAM 35' LT. 363+40 ELEV. 1503.97~~ BM 47A Lt. Sta. 362+65 S.I.R. 10" Y. Bir. E. 1503.08 ~~B.M. 48 S.I.T. 12" STUMP 32' LT. 368+67 ELEV. 1620.94~~
BM 48A Lt. Sta. 368+50 S.I.T. 10" Maple Elev. 1622.51

16