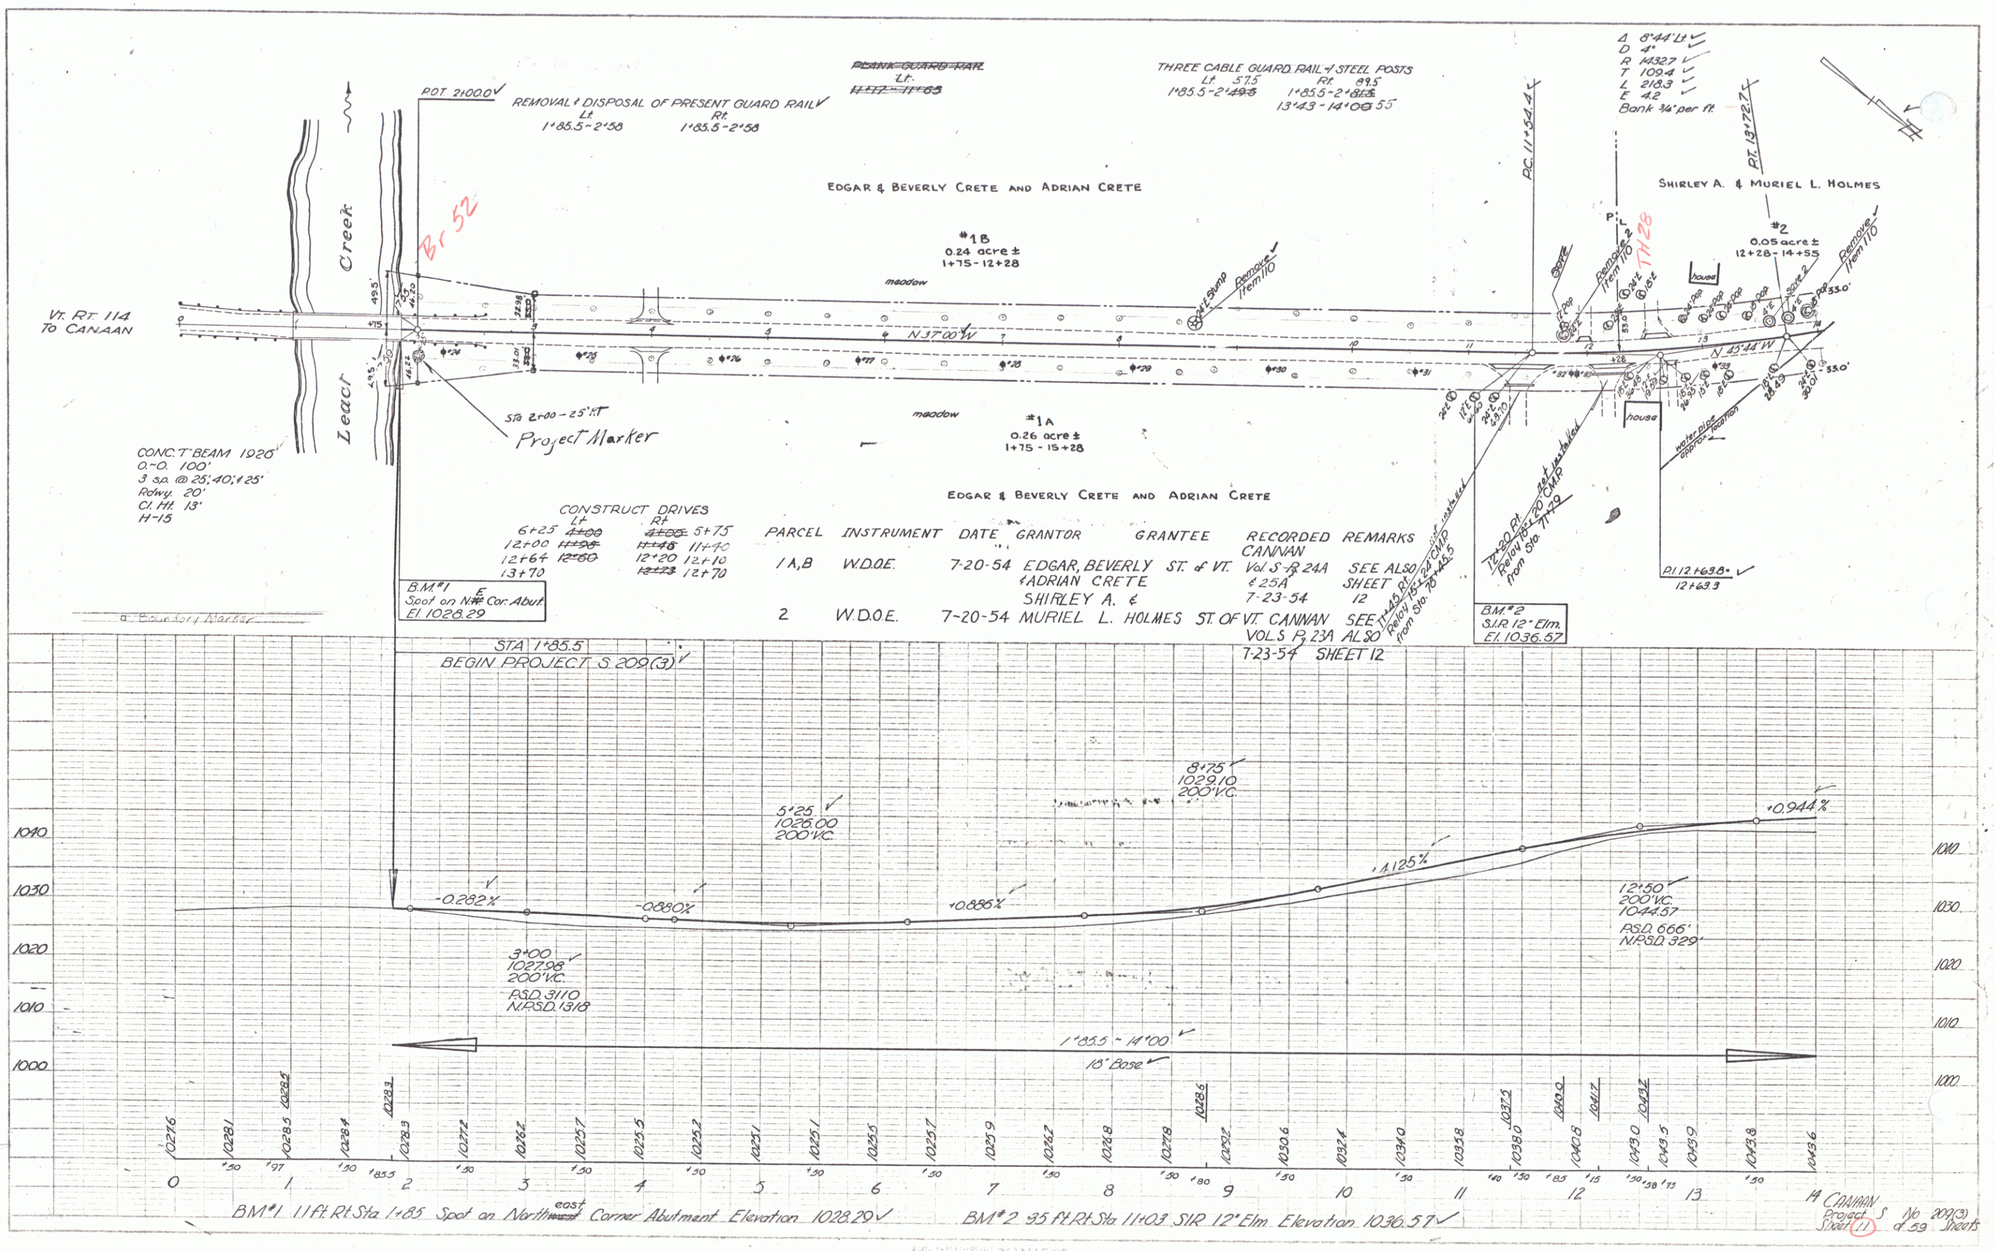
POT 21+00.0
REMOVAL & DISPOSAL OF PRESENT GUARD RAIL
Lt. 1+85.5-2+58
Rt. 1+85.5-2+58
THREE CABLE GUARD RAIL & STEEL POSTS
Lt. 57.5 1+85.5-2+49.5
Rt. 49.5 1+85.5-2+62.5
13+43-14+06.55
Δ 8°44' Lt
D 4°
R 1432.7
T 109.4
L 218.3
E 4.2
Bank ¾" per ft.
PC 11+54.4
PT 13+72.7
EDGAR & BEVERLY CRETE AND ADRIAN CRETE
SHIRLEY A. & MURIEL L. HOLMES
#1B
0.24 acre ±
1+75-12+28
#2
0.05 acre ±
12+28-14+55
meadow
house
Br 52
TH 28
Vt. Rt. 114 TO CANAAN
Leach Creek
N 37°00' W
N 43°44' W
Sta 2+00-25' Rt
Project Marker
#1A
0.26 acre ±
1+75-15+28
CONC. T-BEAM 1926
O.-O. 100'
3 sp. @ 25', 40', & 25'
Rdwy. 20'
Cl. Ht. 13'
H-15
CONSTRUCT DRIVES
Lt. 6+25 12+00 12+64 13+70
Rt. 5+75 11+40 12+10 12+70
PARCEL INSTRUMENT DATE GRANTOR GRANTEE RECORDED REMARKS
1A,B W.D.O.E. 7-20-54 EDGAR, BEVERLY & ADRIAN CRETE ST. of VT. CANNAN Vol. S-P. 24A & 25A SEE ALSO SHEET 12
2 W.D.O.E. 7-20-54 SHIRLEY A. & MURIEL L. HOLMES ST. OF VT. CANNAN 7-23-54 SEE VOL. S P. 23A ALSO 7-23-54 SHEET 12
B.M.#1 Spot on N.E. Cor. Abut. El. 1028.29
B.M.#2 S.I.R. 12" Elm. El. 1036.57
PI 12+63.8
12+63.3
STA 1+85.5
BEGIN PROJECT S. 209(3)
-0.282%
-0.880%
+0.886%
+1.125%
+0.944%
3+00 1027.98 200' V.C. PSD. 3110 NPSD. 1318
5+25 1026.00 200' V.C.
8+75 1029.10 200' V.C.
12+50 200' V.C. 1044.57 PSD. 666' NPSD. 329'
1+85.5-14+00
15' Base
BM#1 11 Ft. Rt. Sta 1+85 Spot on Northeast Corner Abutment Elevation 1028.29
BM#2 35 Ft. Rt. Sta 11+03 S.I.R. 12" Elm. Elevation 1036.57
14 CANNAN Project S. No. 209(3) Sheet 11 of 59 Sheets