


PLAN
 DATE 9/26
 DRAWN BY
 CHECKED BY

PROFILE
 DATE 9-91
 DRAWN BY
 CHECKED BY

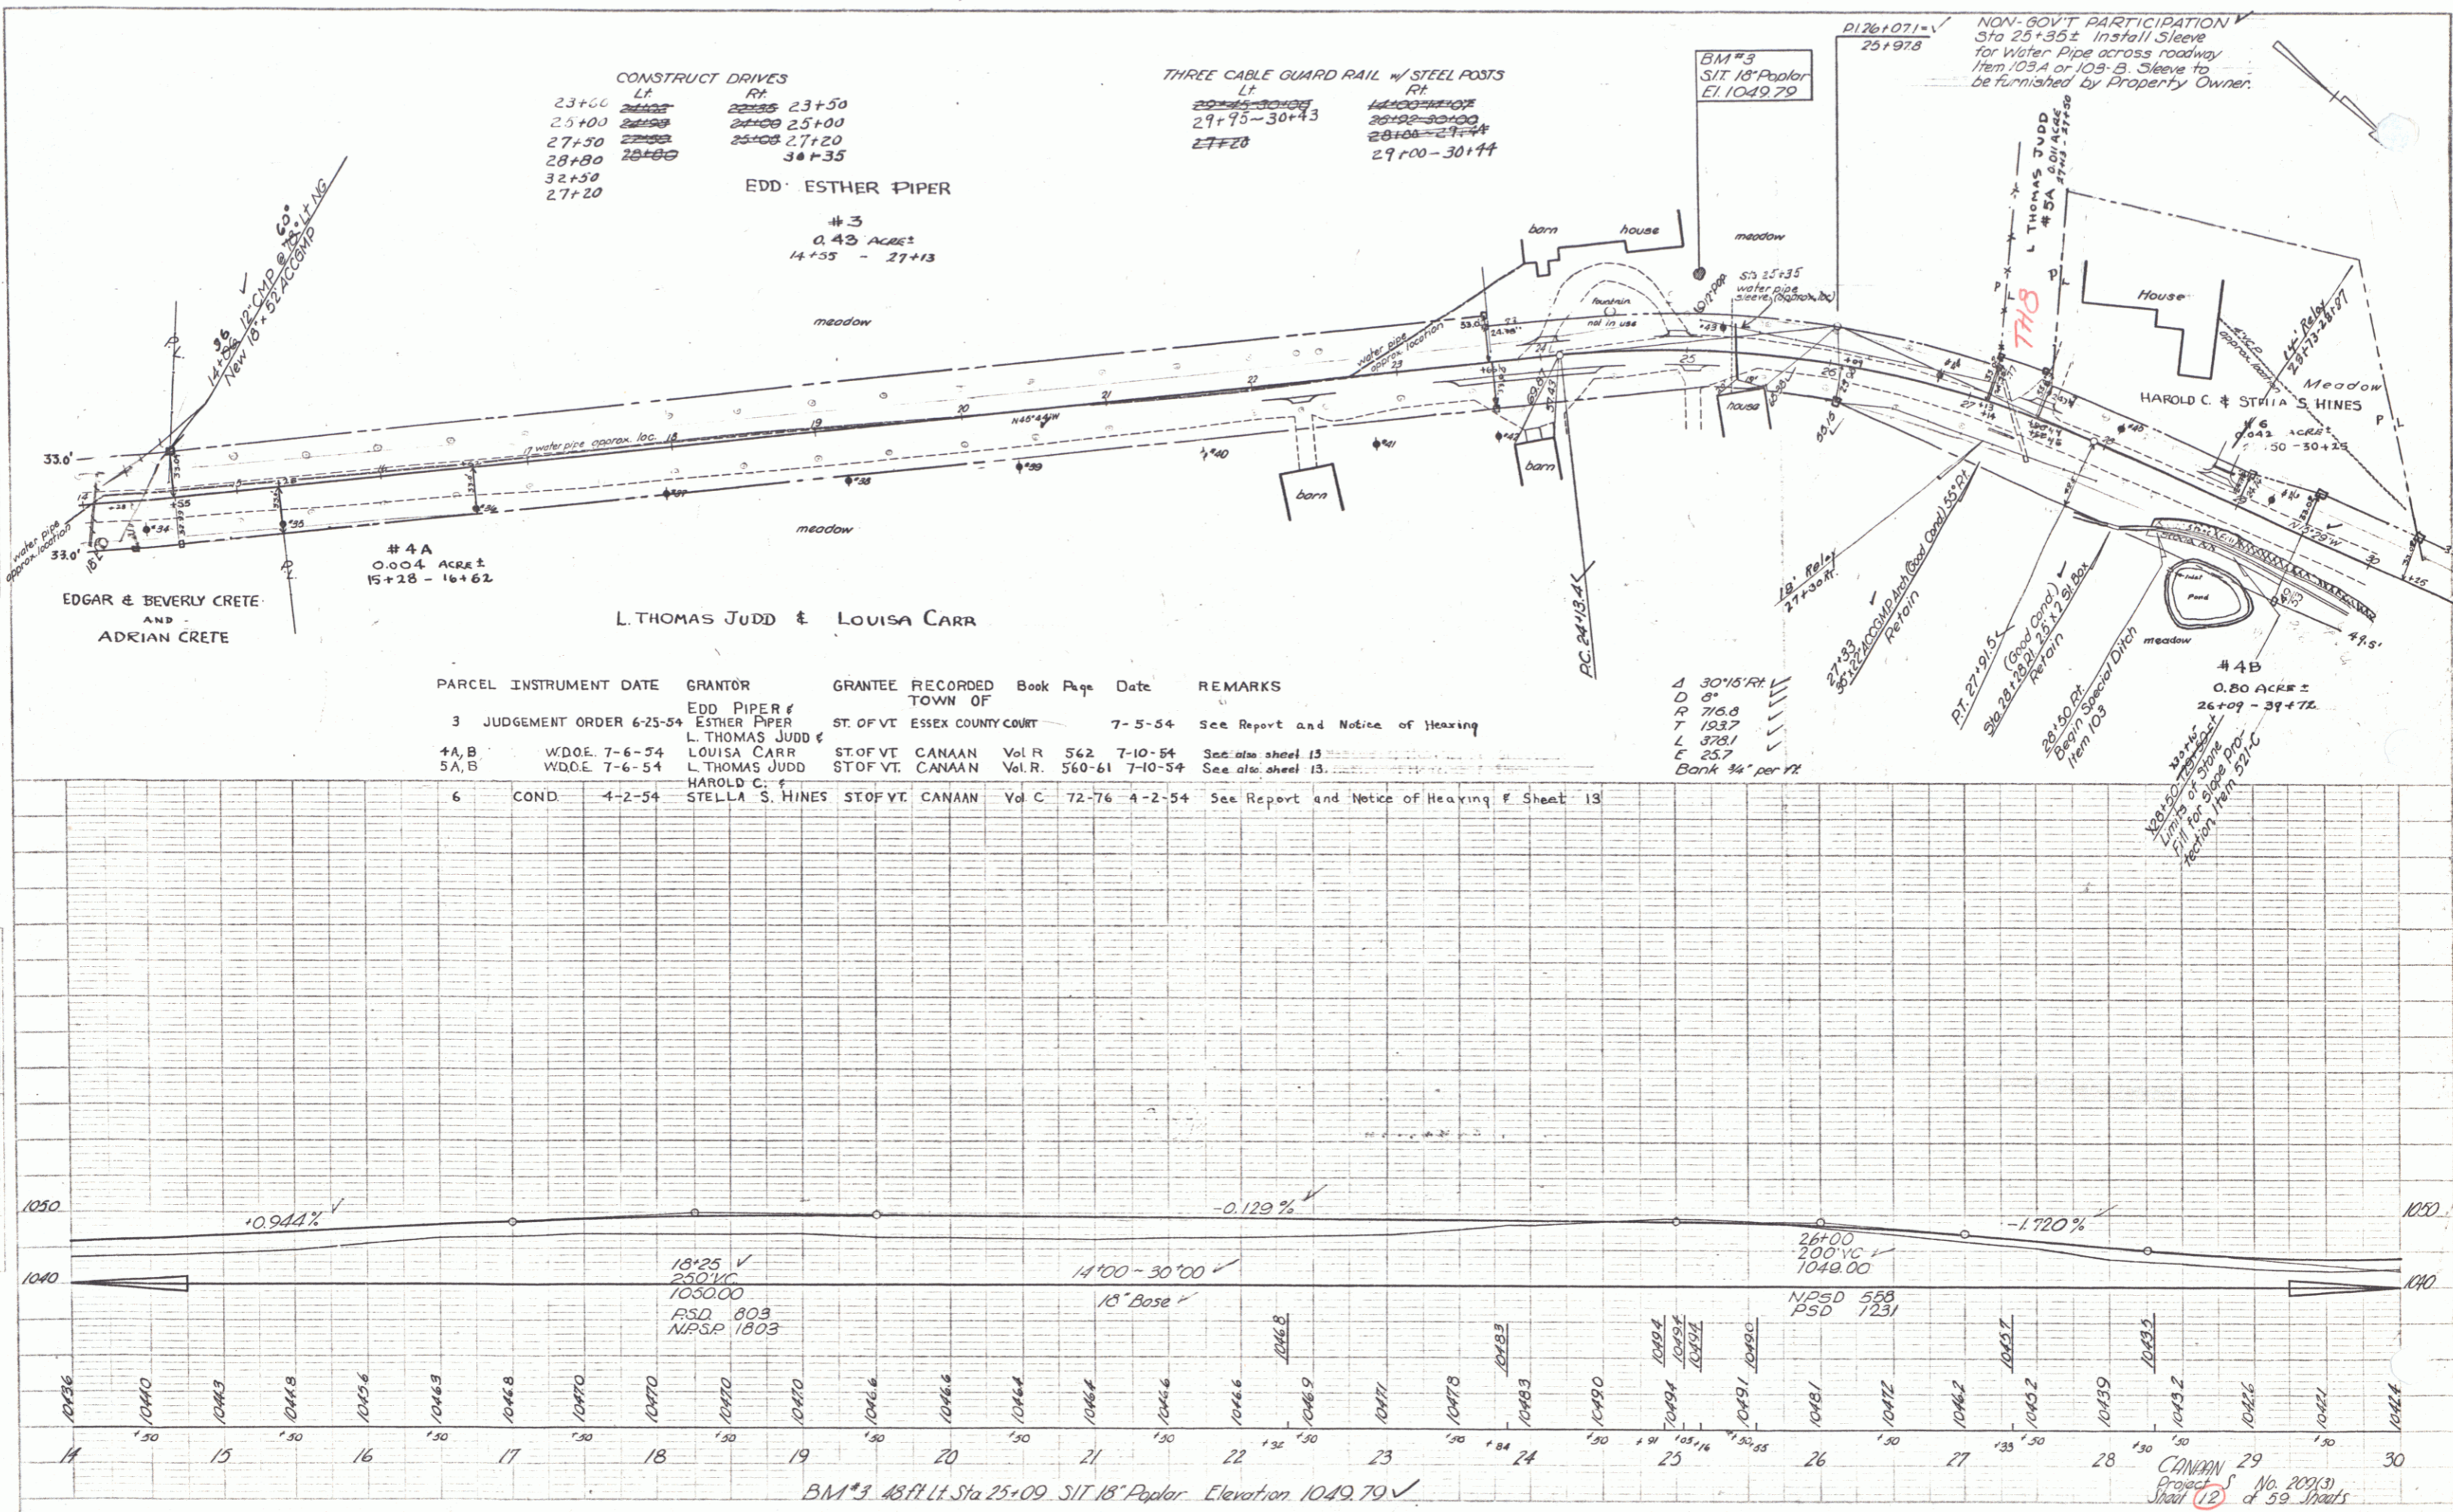

BM #3 48 ft Lt. Sta 25+09 SIT 18" Paper Elevation 1049.79

CANAAN Project No. 202(3) Sheet 12 of 59 Sheets