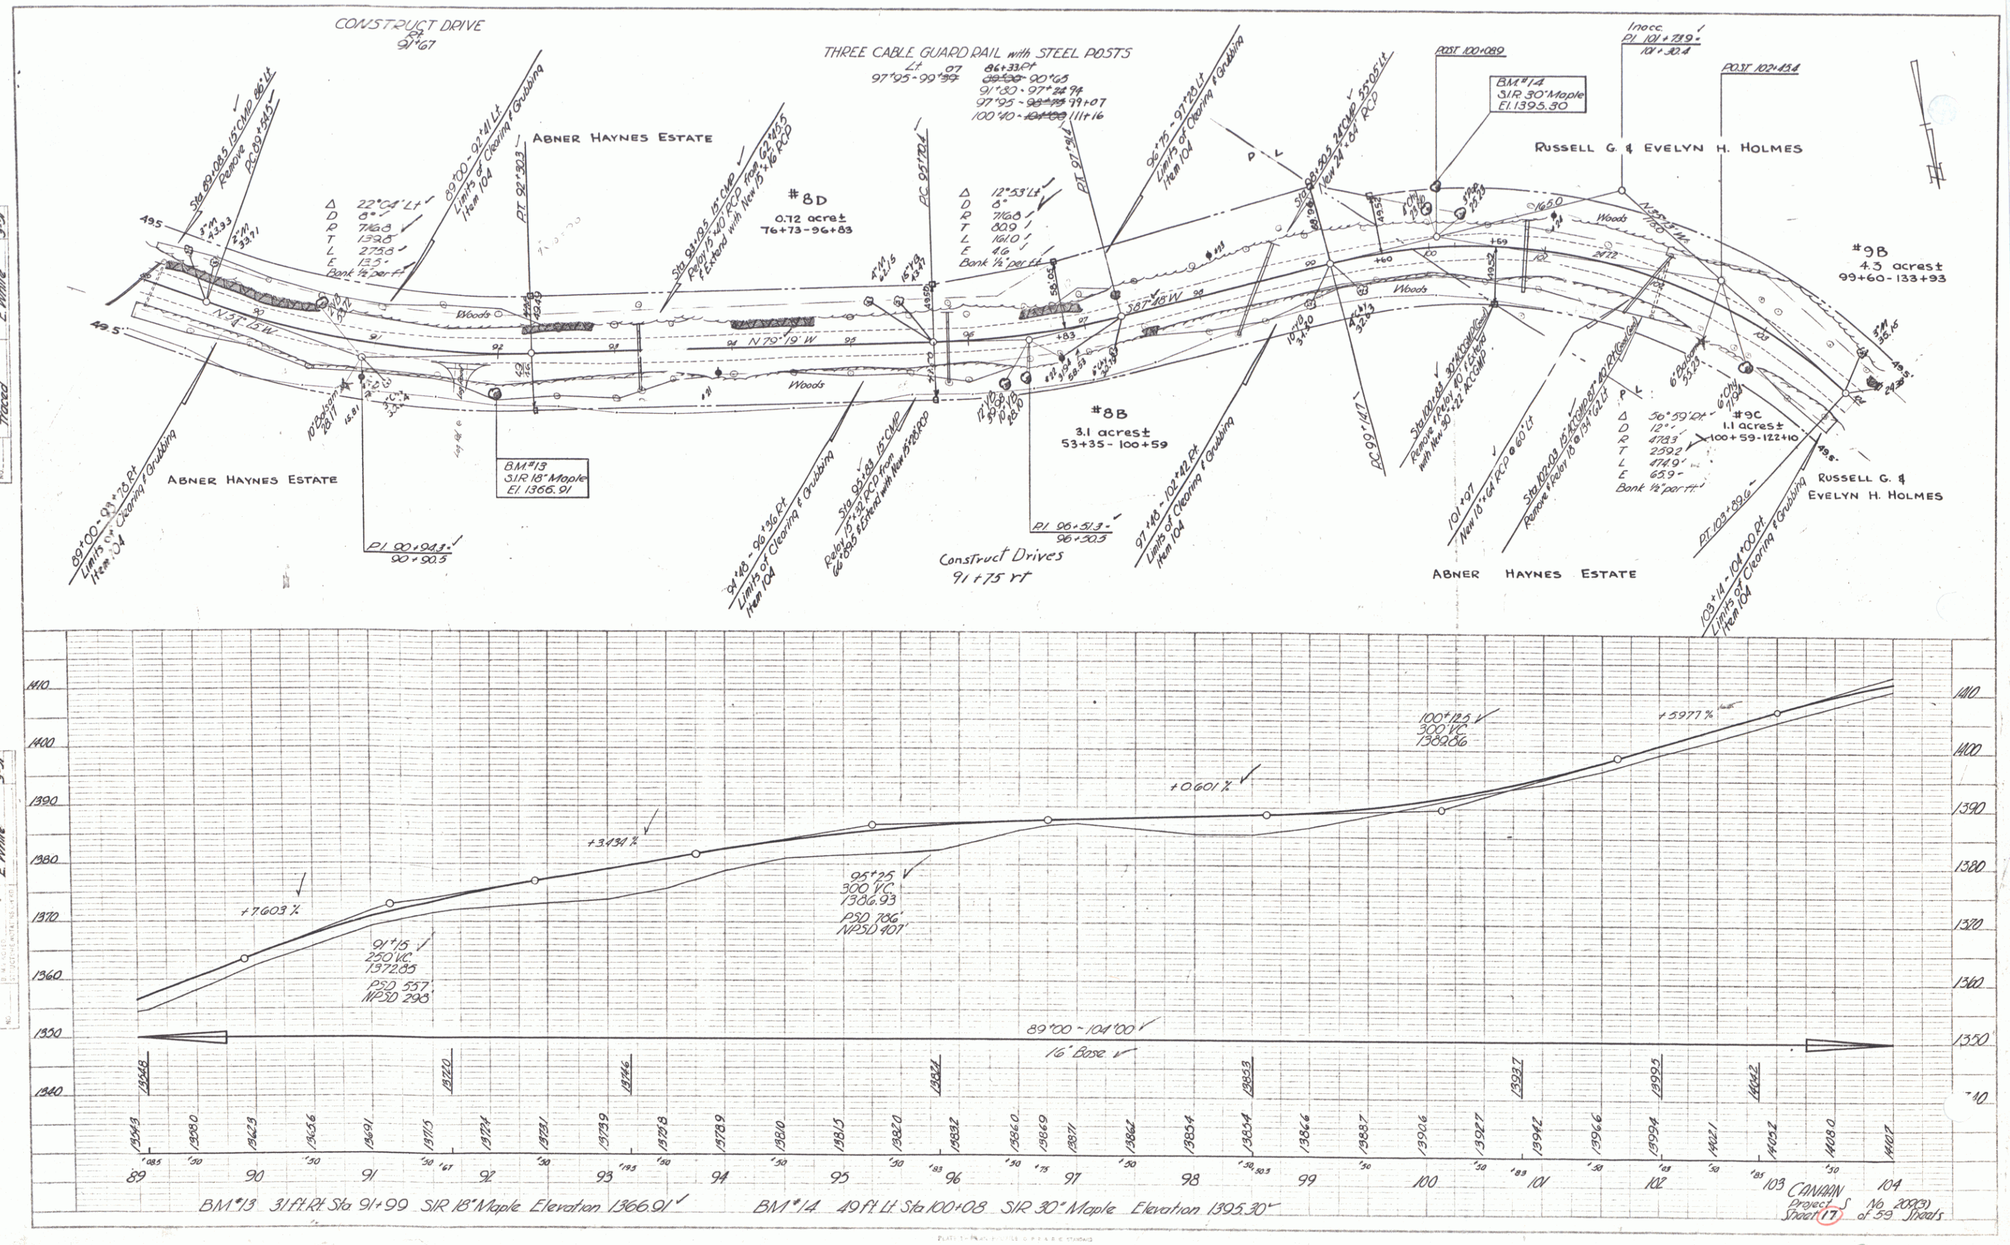
CONSTRUCT DRIVE
91+67
THREE CABLE GUARD RAIL with STEEL POSTS
ABNER HAYNES ESTATE
#8D
0.72 acres±
76+73 - 96+83
#8B
3.1 acres±
53+35 - 100+59
#9B
4.3 acres±
99+60 - 133+93
#9C
1.1 acres±
100+59 - 122+10
RUSSELL G. & EVELYN H. HOLMES
BM#13
31R 18" Maple
El. 1366.91
BM#14
31R 30" Maple
El. 1395.30
Construct Drives
91+75 rt
Woods
N 79°19' W
N 87°48' W
89°00' - 104°00'
16' Base
+7.603 %
+3.434 %
+0.601 %
+5.977 %
91+15
250' VC
1372.05
PSD 557'
NPSD 298'
95+25
300' VC
1366.93
PSD 786'
NPSD 407'
100+125
300' VC
1388.86
BM#13 31 ft Rt Sta 91+99 SIR 18" Maple Elevation 1366.91
BM#14 49 ft Lt Sta 100+08 SIR 30" Maple Elevation 1395.30
Sheet 17 of 59 Sheets