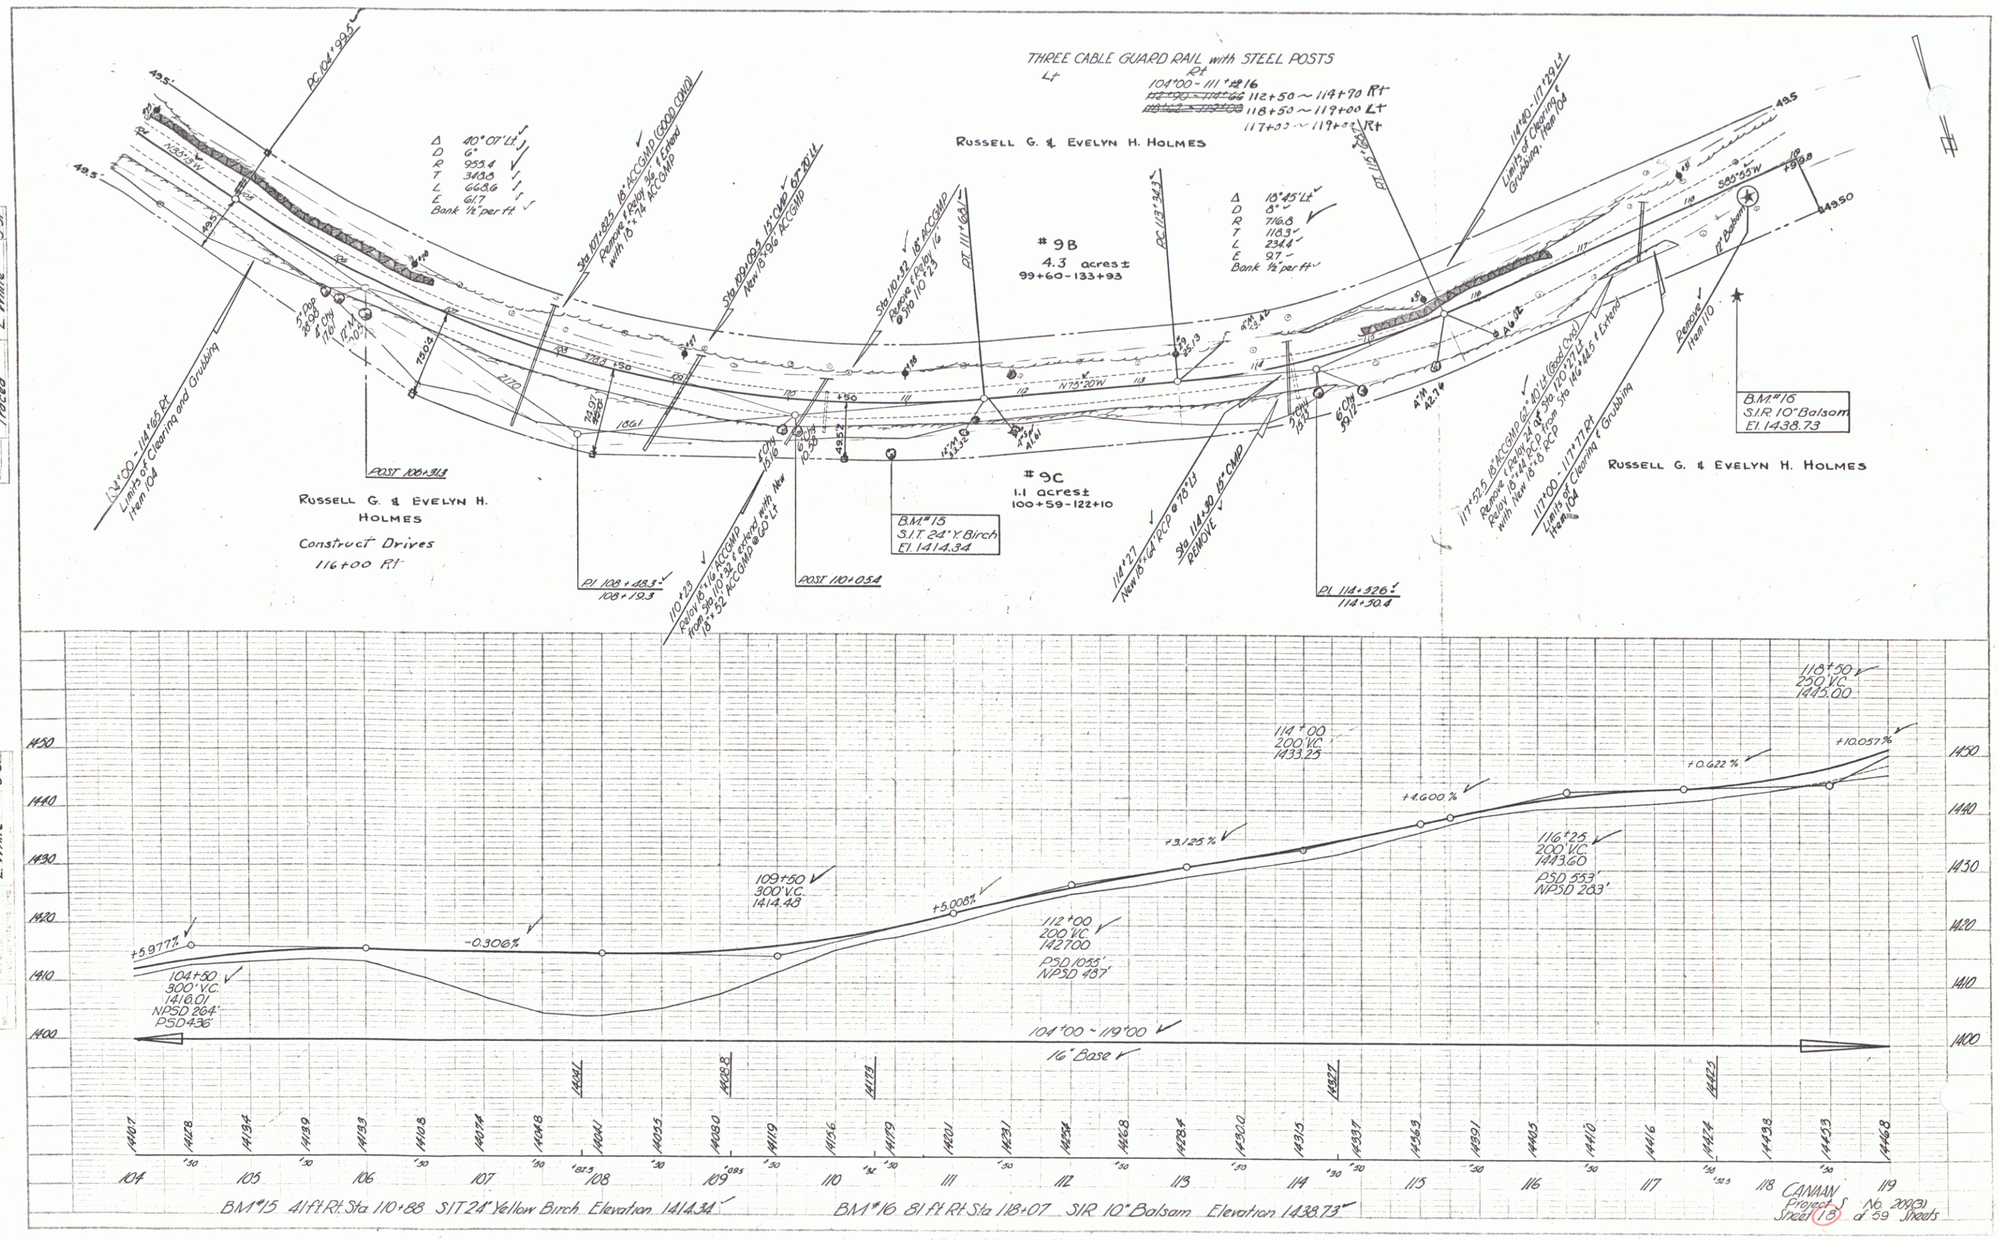
THREE CABLE GUARD RAIL with STEEL POSTS
Lt
Rt
104+00 - 111+#16
112+50 ~ 119+90 Rt
118+50 ~ 119+00 Lt
117+00 ~ 119+00 Rt
Δ 40° 07' Lt
D 6°
R 955.4
T 344.8
L 668.6
E 61.7
Bank ½ per ft
Δ 18° 45' Lt
D 8°
R 716.8
T 118.3
L 234.4
E 9.7
Bank ½ per ft
RUSSELL G. & EVELYN H. HOLMES
#9B
4.3 acres±
99+60 - 133+93
#9C
1.1 acres±
100+59 - 122+10
RUSSELL G. & EVELYN H. HOLMES
Construct Drives
116+00 Rt
RUSSELL G. & EVELYN H. HOLMES
B.M.#15
S.I.T. 24" Y. Birch
El. 1414.34
B.M.#16
S.I.R. 10" Balsam
El. 1438.73
POST 110+05.4
PI 108+48.3
108+19.3
PI 114+32.6
114+30.4
PC 104+99.6
PC 113+34.4
PT 111+64.1
PT 117+29.4
Sta 107+82.5 18" ACCOMP (GOOD COND)
Sta 109+09.4 15" CMP 67' OLL
Sta 110+32 18" ACCOMP
Sta 114+30 15" CMP
Remove Hem 104
Remove Hem 110
Limits of Clearing & Grubbing Hem 104
104+00 - 114+65 Rt
Limits of Clearing and Grubbing Hem 104
117+00 - 117+77 Rt
Limits of Clearing & Grubbing Hem 104
N35°13'W
N75°20W
S85°55W
49.5
49.50
104+00 - 119+00
16' Base
+5.977%
-0.306%
+5.006%
+3.125%
+4.600%
+0.622%
+10.057%
104+50
300' V.C.
NPSD 264'
PSD 436'
109+50
300' V.C.
1414.48
112+00
200' V.C.
1427.00
PSD 1053'
NPSD 487'
114+00
200' V.C.
1433.25
116+25
200' V.C.
PSD 533'
NPSD 203'
1445.00
104 105 106 107 108 109 110 111 112 113 114 115 116 117 118 119
BM#15 41 ft Rt Sta 110+88 SIT 24" Yellow Birch Elevation 1414.34
BM#16 81 ft Rt Sta 118+07 SIR 10" Balsam Elevation 1438.73
CANAAN
Project S No 209(3)
Sheet 18 of 59 Sheets
9