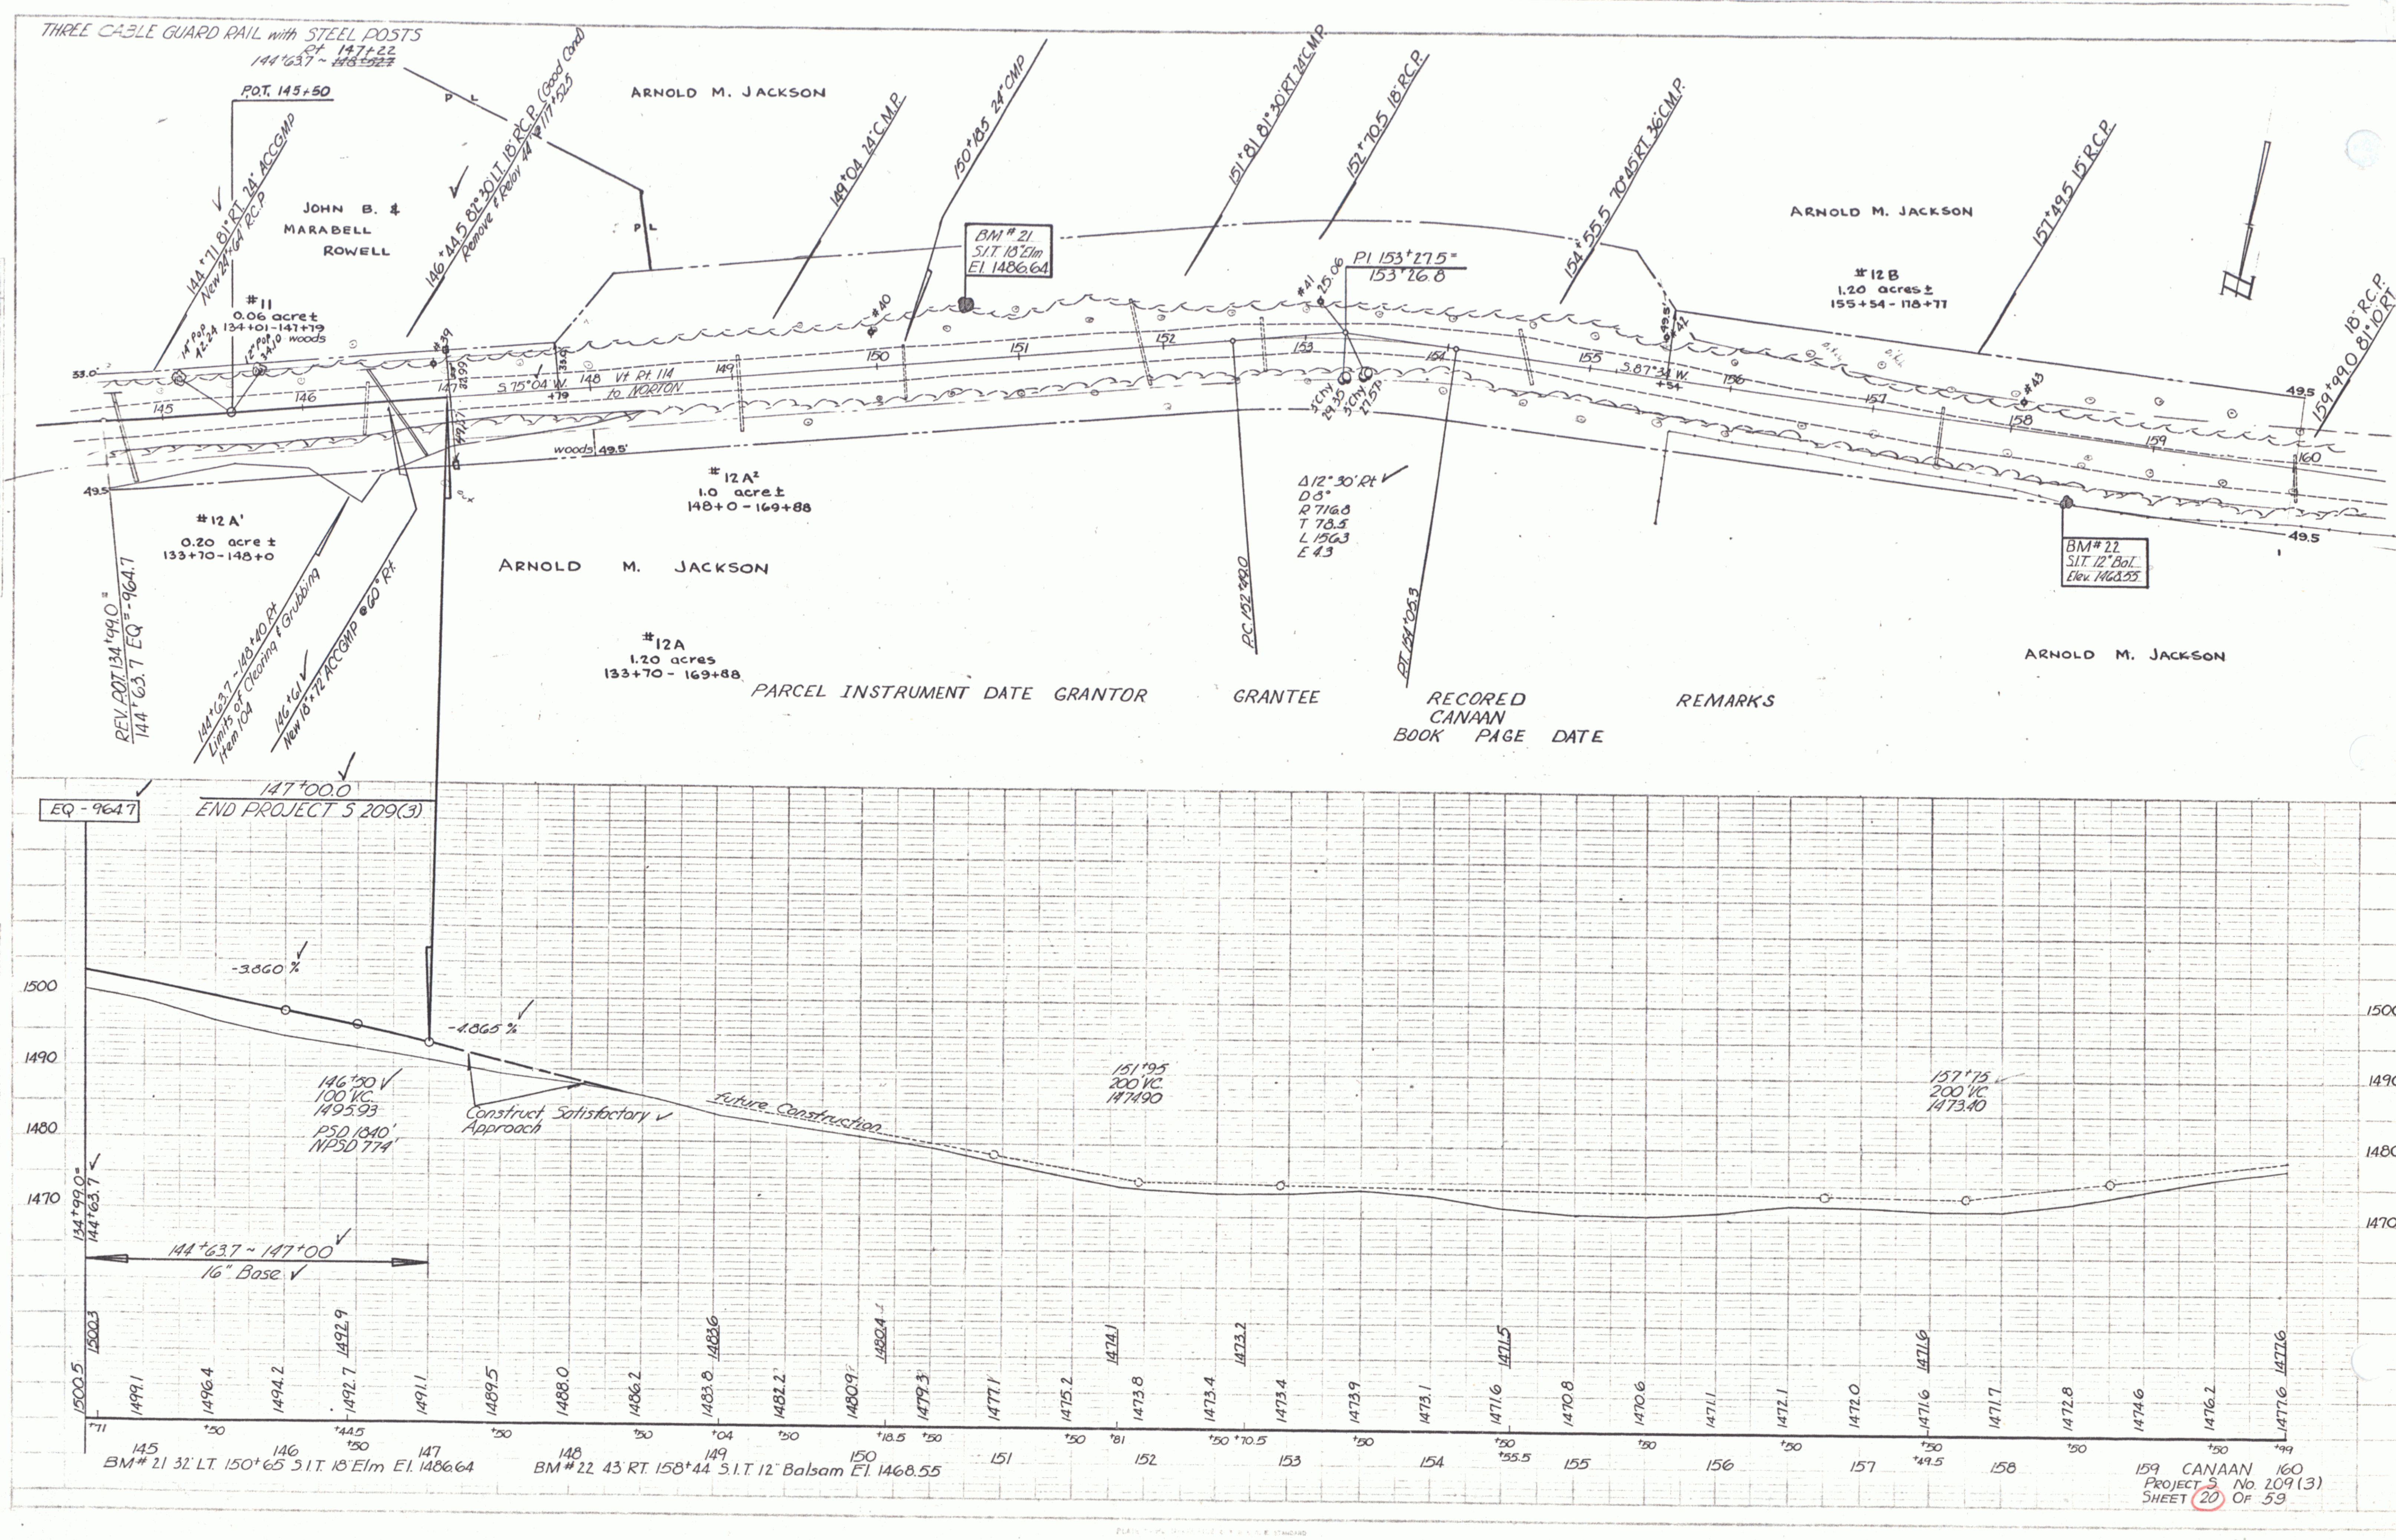
THREE CABLE GUARD RAIL with STEEL POSTS
Rt 147+22
144+63.7
P.O.T. 145+50
ARNOLD M. JACKSON
JOHN B. &
MARABELL
ROWELL
#11
0.06 acre±
134+01-147+19
BM#21
S.I.T. 18" Elm
El. 1486.64
PI 153+27.5
153+26.0
ARNOLD M. JACKSON
#12 B
1.20 acres±
155+54 - 118+77
#12 A²
1.0 acre±
148+0 - 169+88
#12 A'
0.20 acre±
133+70 - 148+0
ARNOLD M. JACKSON
#12A
1.20 acres
133+70 - 169+88
Δ 12°30' Rt
D 8°
R 716.8
T 78.5
L 156.3
E 4.3
BM#22
S.I.T. 12" Bal.
Elev. 1468.55
ARNOLD M. JACKSON
REV. P.O.T. 134+49.0
144+63.7 EQ. = 964.7
PC 152+80
PT 154+06.3
PARCEL INSTRUMENT DATE GRANTOR GRANTEE RECORED CANAAN BOOK PAGE DATE REMARKS
147+00.0
EQ - 964.7
END PROJECT S 209(3)
-3.860 %
-1.865 %
146+50
100' VC
1495.93
PSD 1840'
NPSD 774'
Construct Satisfactory Approach
Future Construction
151+95
200' VC
1474.90
157+75
200' VC
1473.40
144+63.7 ~ 147+00
16" Base
BM#21 32' LT. 150+65 S.I.T. 18 Elm El. 1486.64
BM#22 43' RT. 158+44 S.I.T. 12" Balsam El. 1468.55
159 CANAAN 160
PROJECT S No. 209(3)
SHEET 20 OF 53