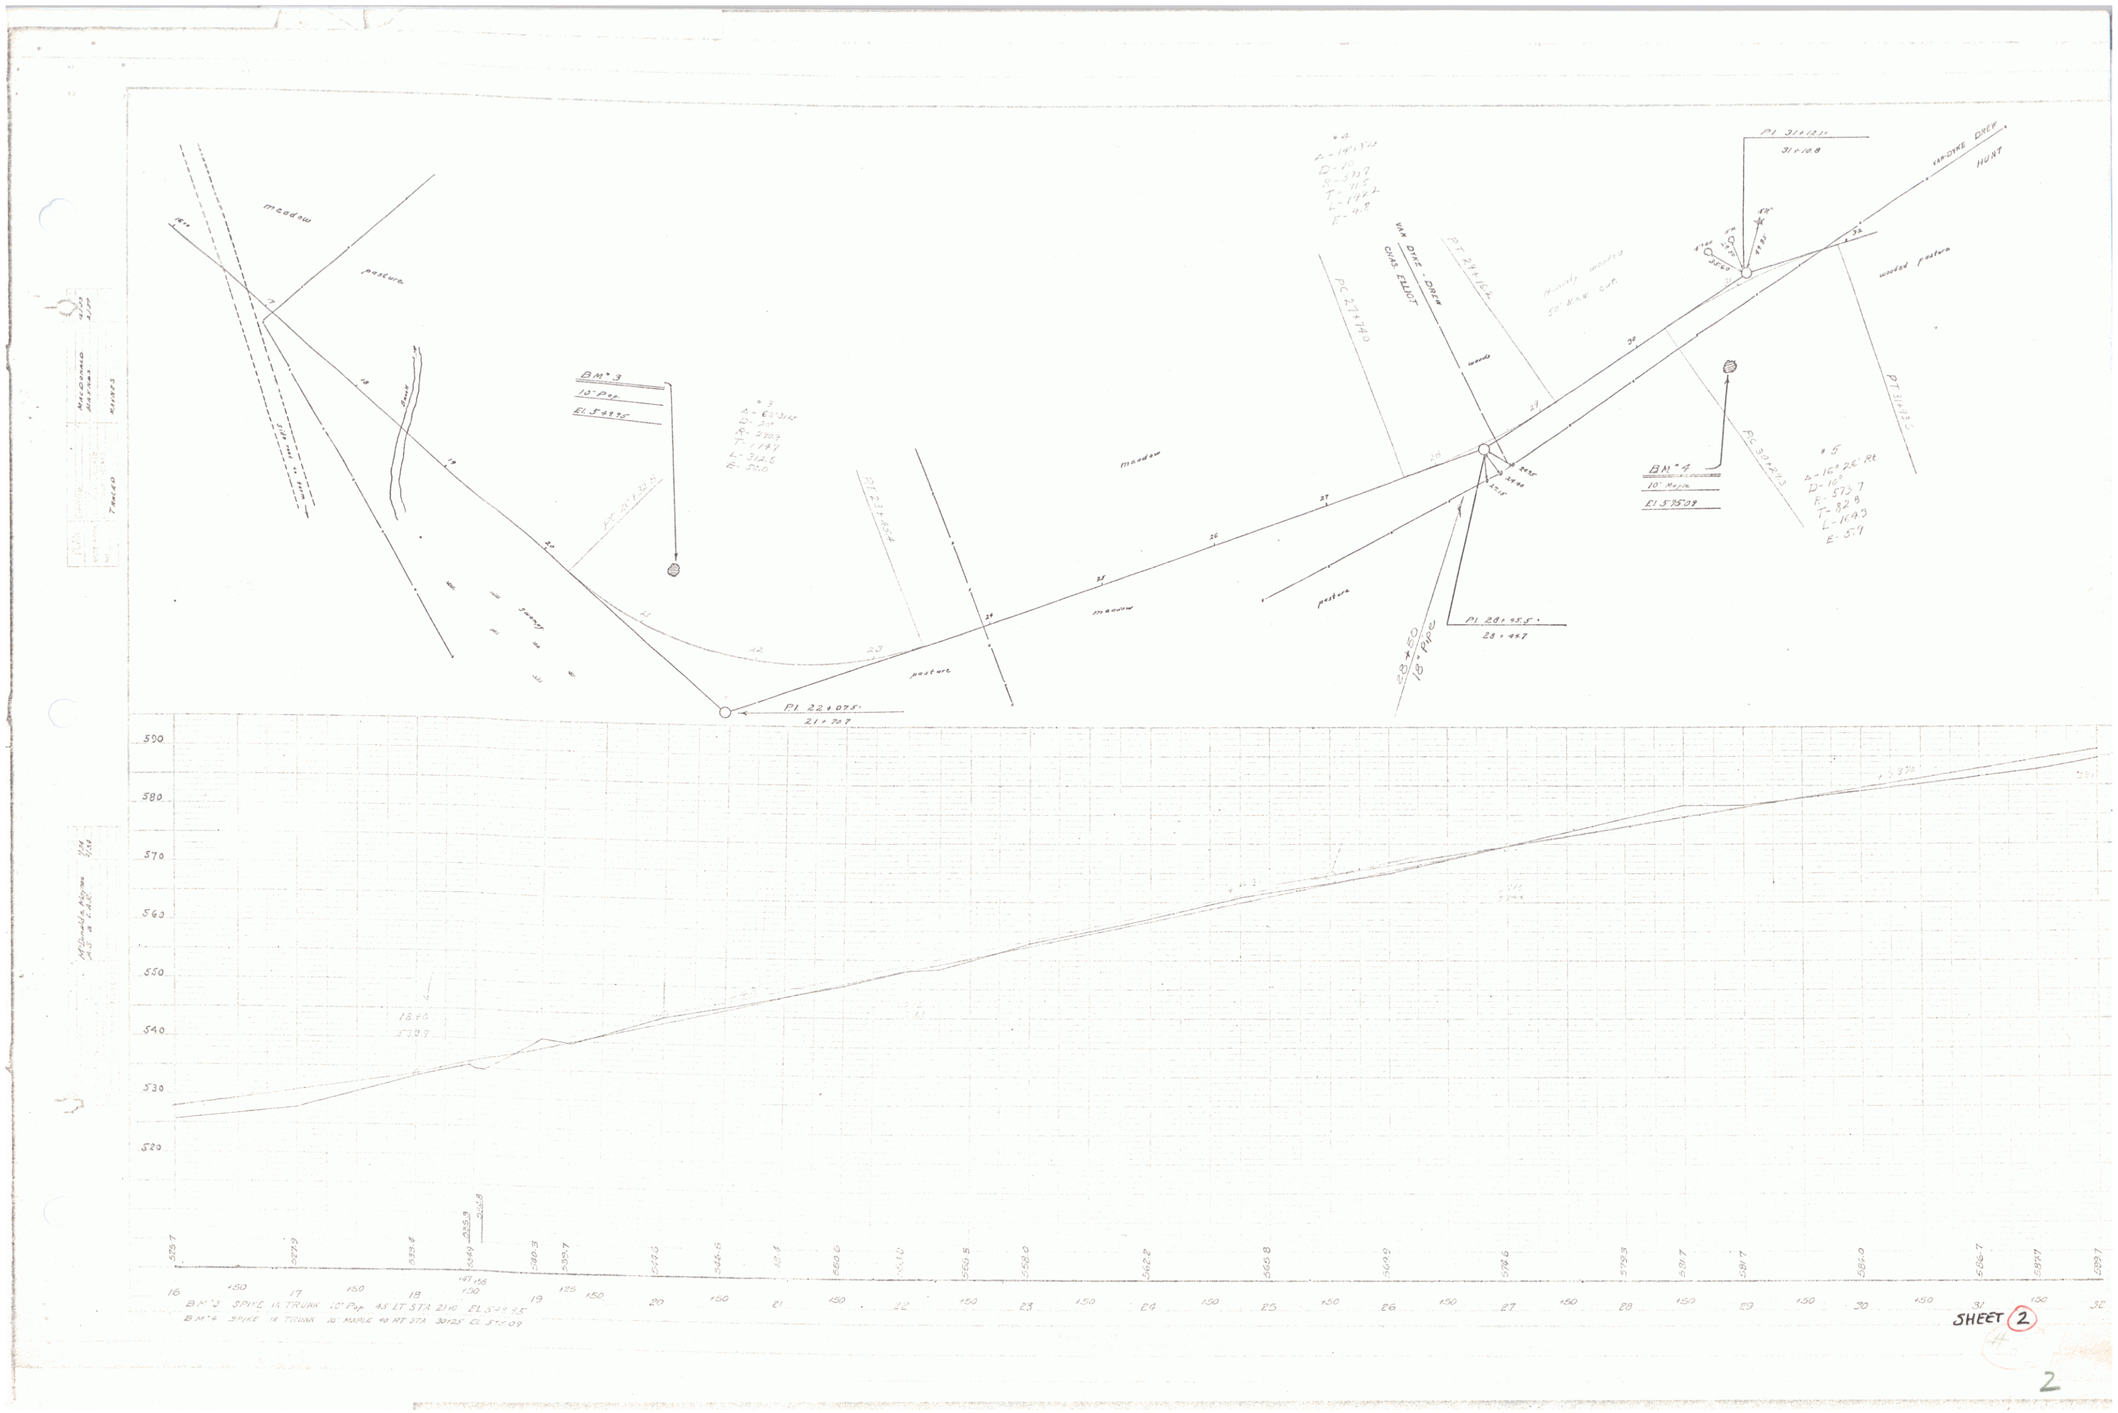
meadow
pasture
BM #3
10" Pap.
El. 548.75
PC 20+14.25
PI 22+07.5
21+70.7
PT 23+54
meadow
pasture
PC 27+93
VAN DYCE - DREW
CHAS ELLIOT
weeds
PT 27+15.5
PI 28+45.5
28+97
28+50
18" Pipe
BM #4
10" Maple
El. 575.09
PC 30+47.5
PI 31+12.1
31+08
VAN DYKE DREW
HUNT
weed pasture
PT 31+73.5
16 150 17 150 18 150 19 150 20 150 21 150 22 150 23 150 24 150 25 150 26 150 27 150 28 150 29 150 30 150 31 150 32
BM #3 SPIKE 14" TRUNK 10" Pap. 45' LT STA 21+10 EL 549.25
BM #4 SPIKE 14" TRUNK 10" MAPLE 40 RT STA 30+25 EL 575.09
SHEET 2

2