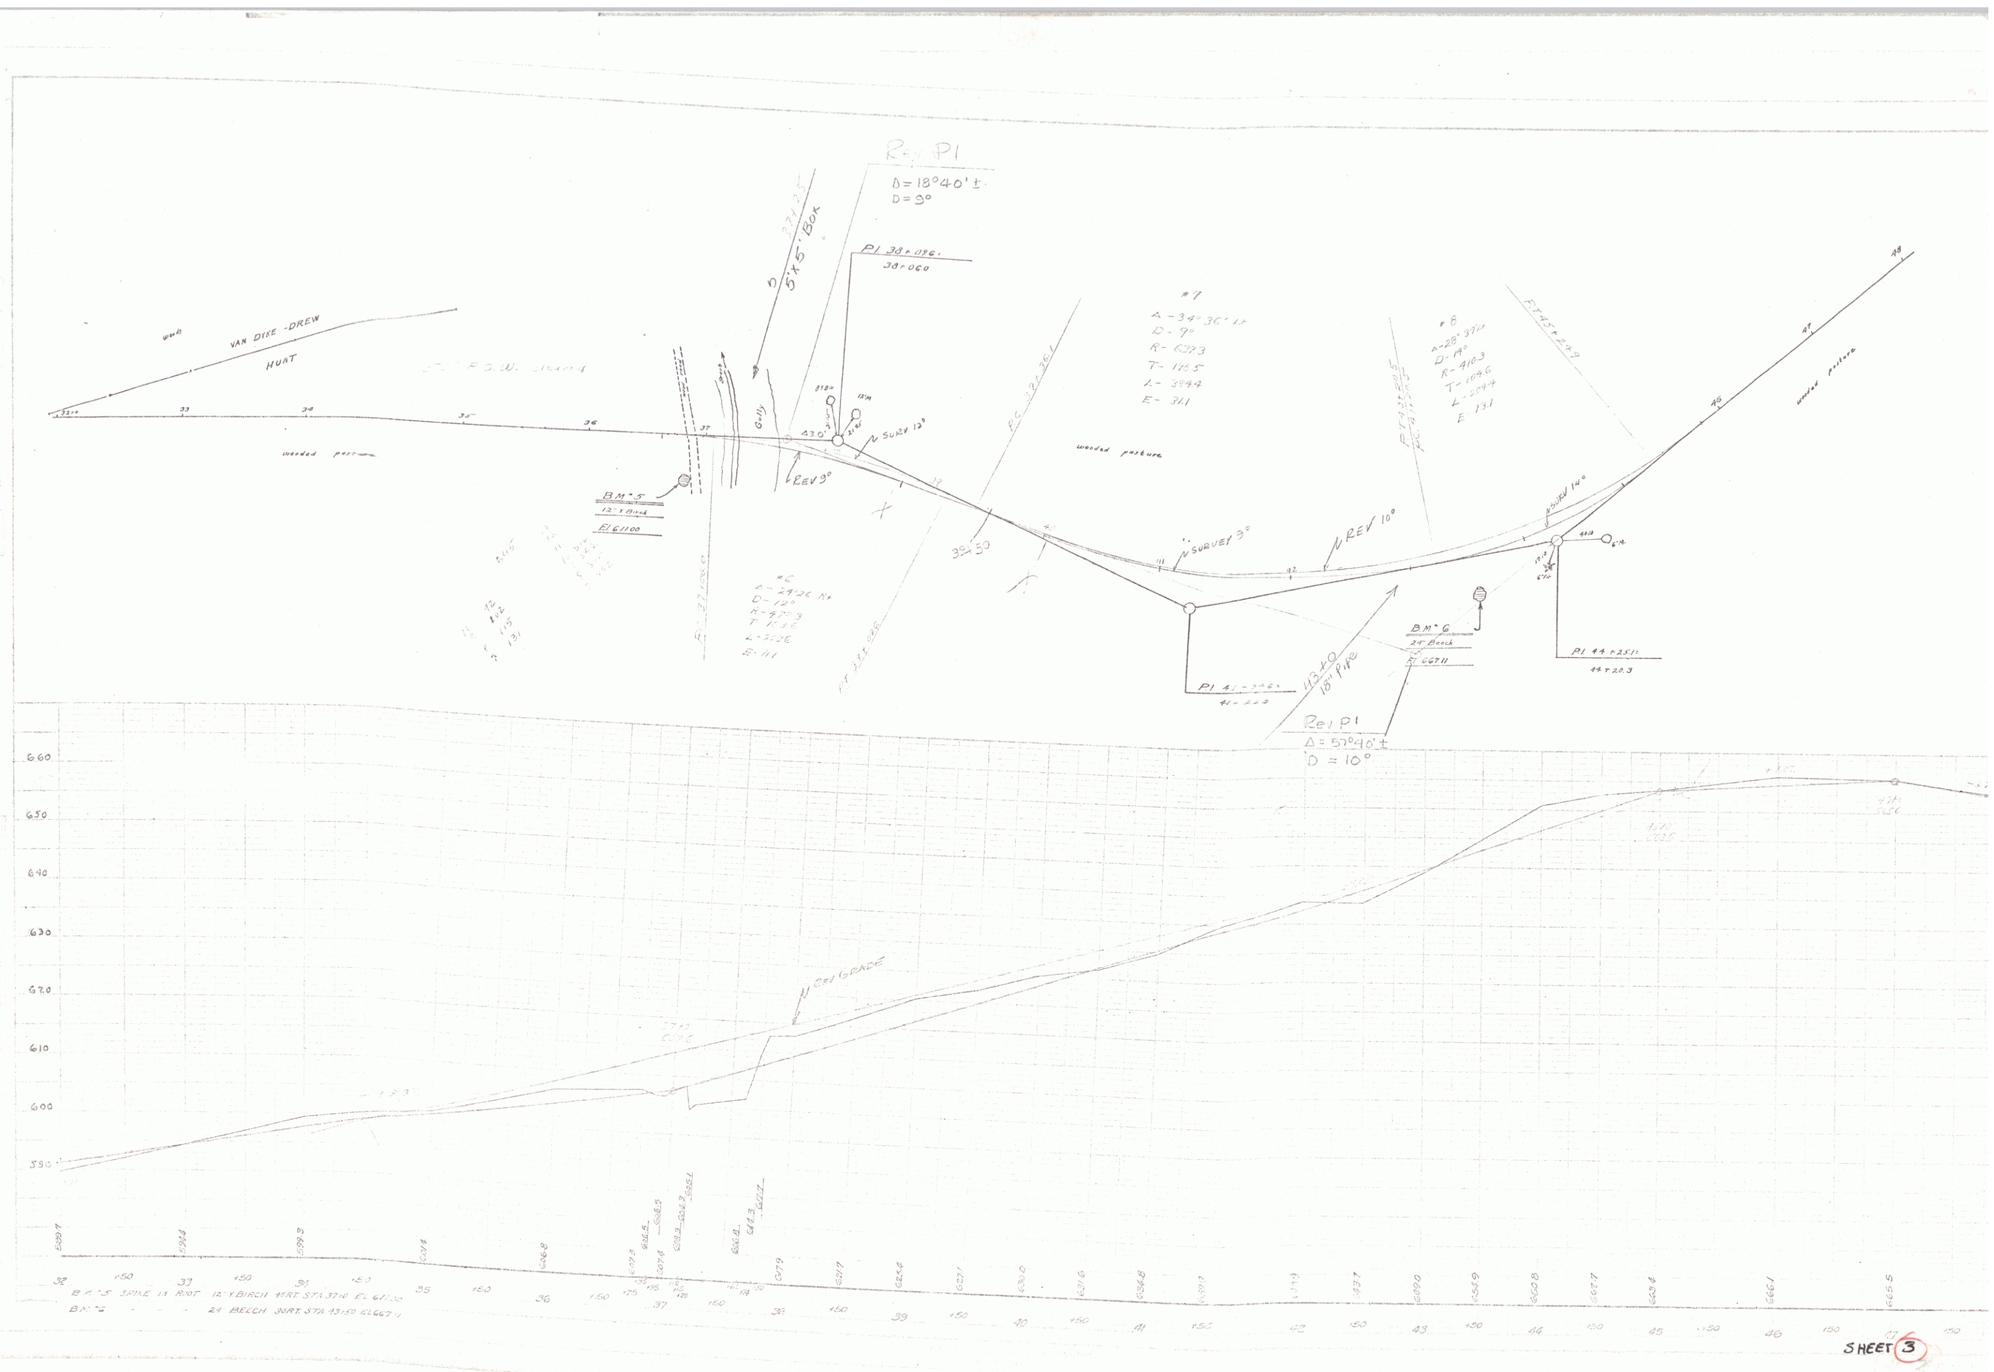
Rel P1
Δ = 18°40' ±
D = 3°
5 x 5 - Box
PI 38+0786
38+060
#7
Δ = 34°36' ±
D = 9°
R = 637.3
T = 195.5
L = 384.4
E = 31.1
#6
Δ = 28°37'
D = 14°
R = 410.3
T = 104.6
L = 204.4
E = 13.1
#5
Δ = 24°26' ±
D = 12°
R = 477.3
T = 103
L = 203.6
E = 11.1
VAN DYKE - DREW
HUNT
wooded pasture
BM #5
12" Birch
El 611.00
BM #6
24" Beech
El 607.11
PI 41+3246
41+220
PI 44+2511
44+203
Rel P1
Δ = 57°40' ±
D = 10°
113 ± 0
18" Pipe
REV 3°
SURVEY 12°
SURVEY 3°
REV 10°
SURVEY 10°
Old GRADE
660
650
640
630
620
610
600
590
BM #5 SPIKE IN ROOT 12" BIRCH 10 FRT. STA. 37+0 EL 611.00
BM #6 24" BEECH 30 FRT. STA. 43+50 EL 607.11

SHEET 3

3