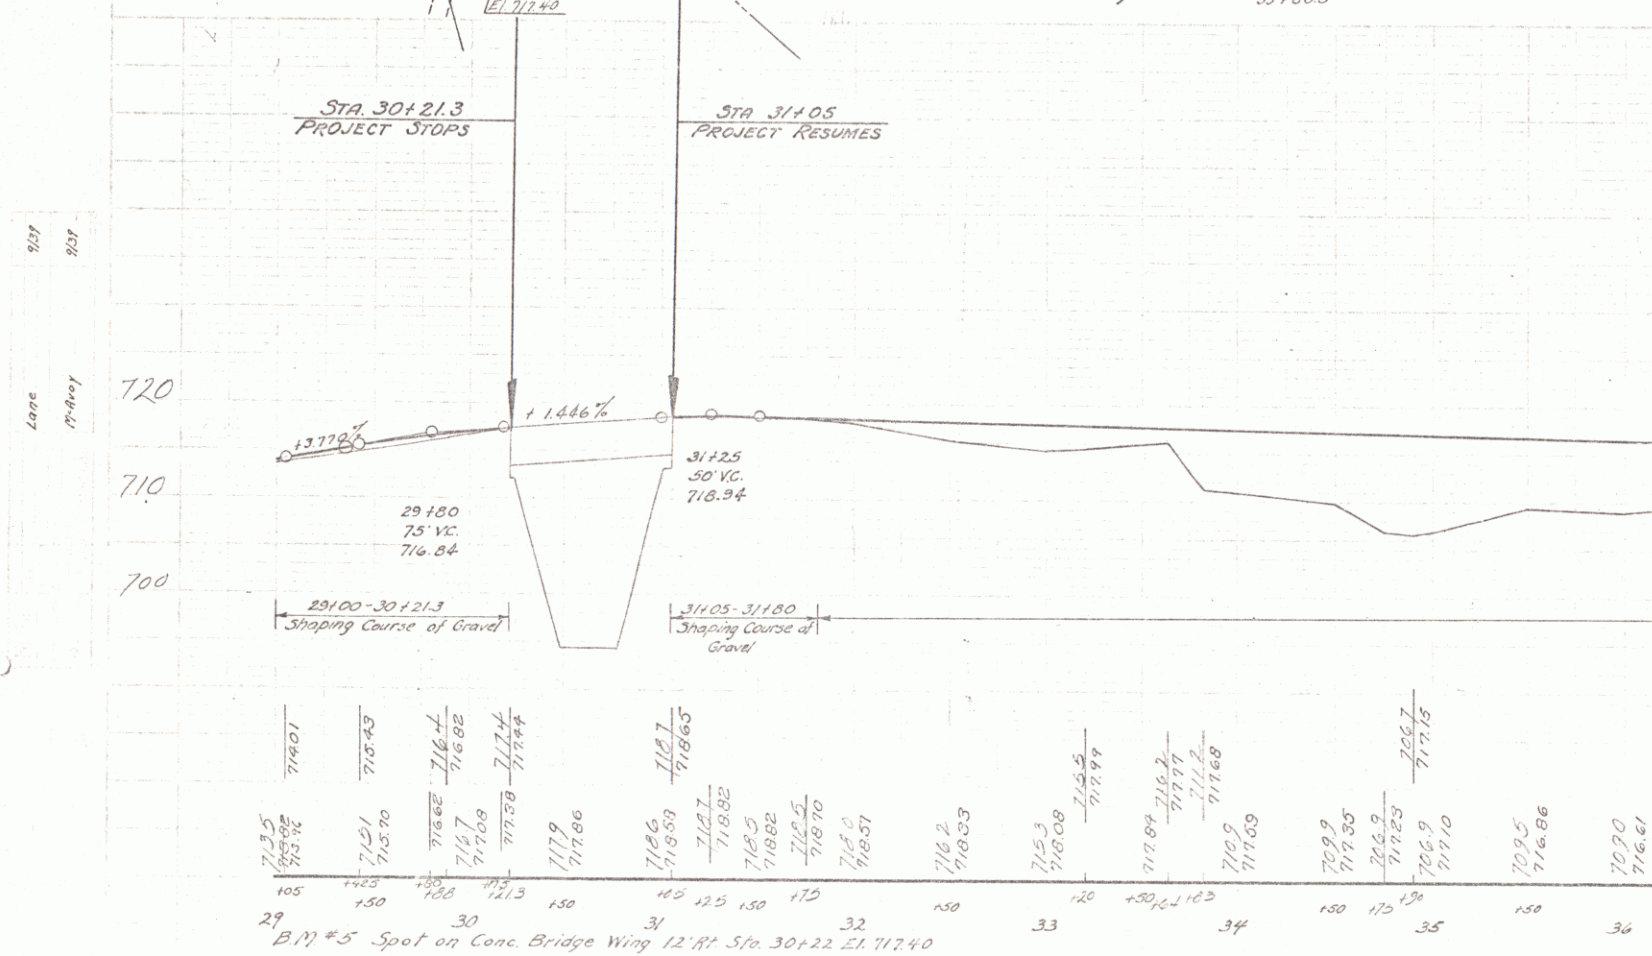

B.M. #5 Spot on Conc. Bridge Wing 12' Rt. Sta. 30+22 El. 717.40

B.M. #6 S.I.R. 36" Elm 17.5' Rt. Pres. Rd. Sta. 51+43 El. 712.64