FED. ROAD DIST. NO.	STATE	FISCAL YEAR	SHEET NO.	TOTAL SHEETS
2	VT.	1941	9	49

FAS 188 B(1)

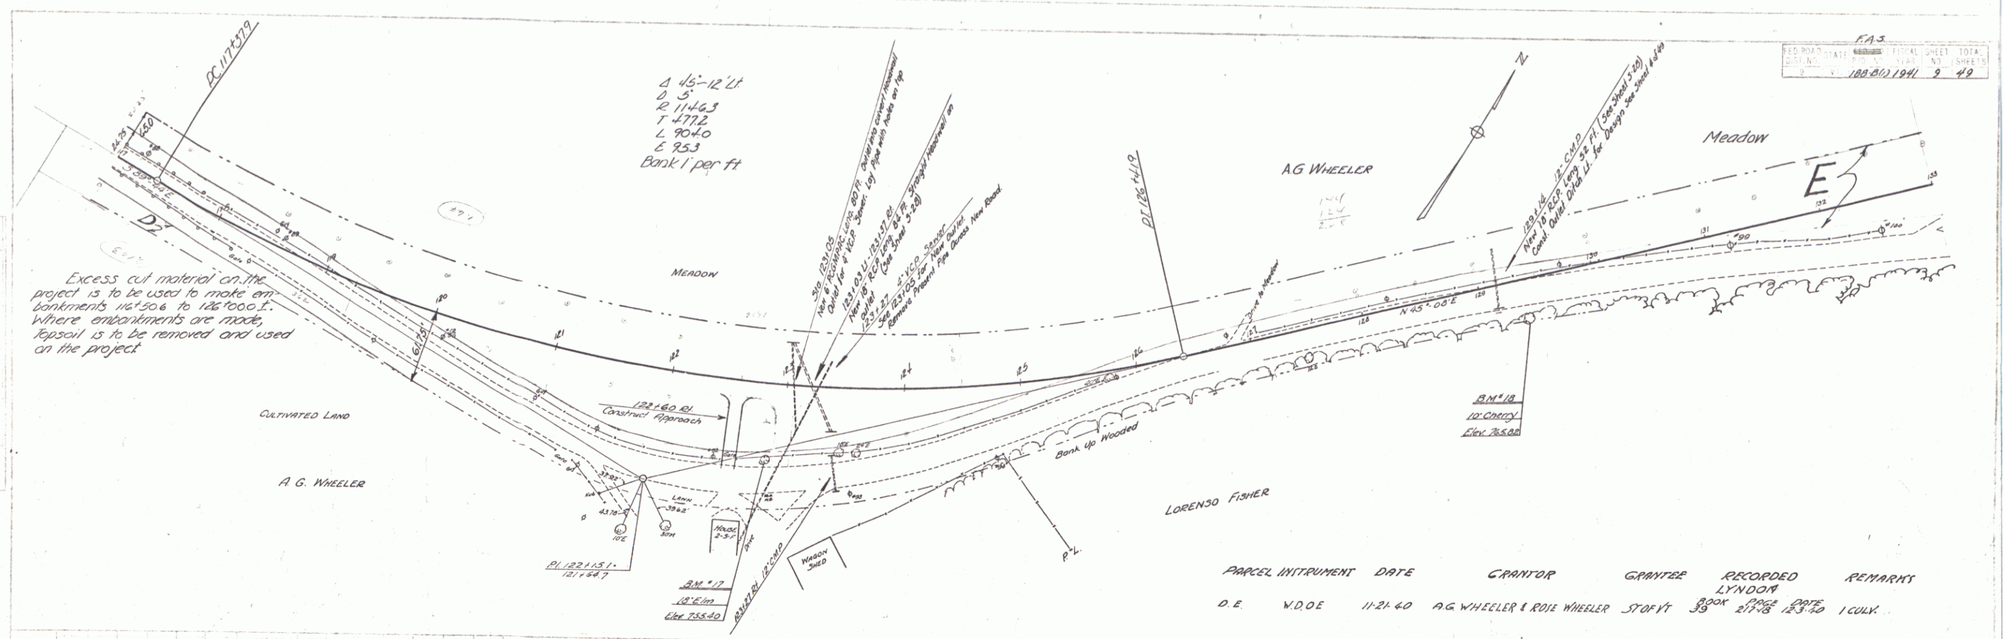

7