F.A.S.

FED. ROAD DIST. NO.	STATE	PROJ. NO.	FISCAL YEAR	SHEET NO.	TOTAL SHEETS
9	VT.	188-B(1)	1941	9	49

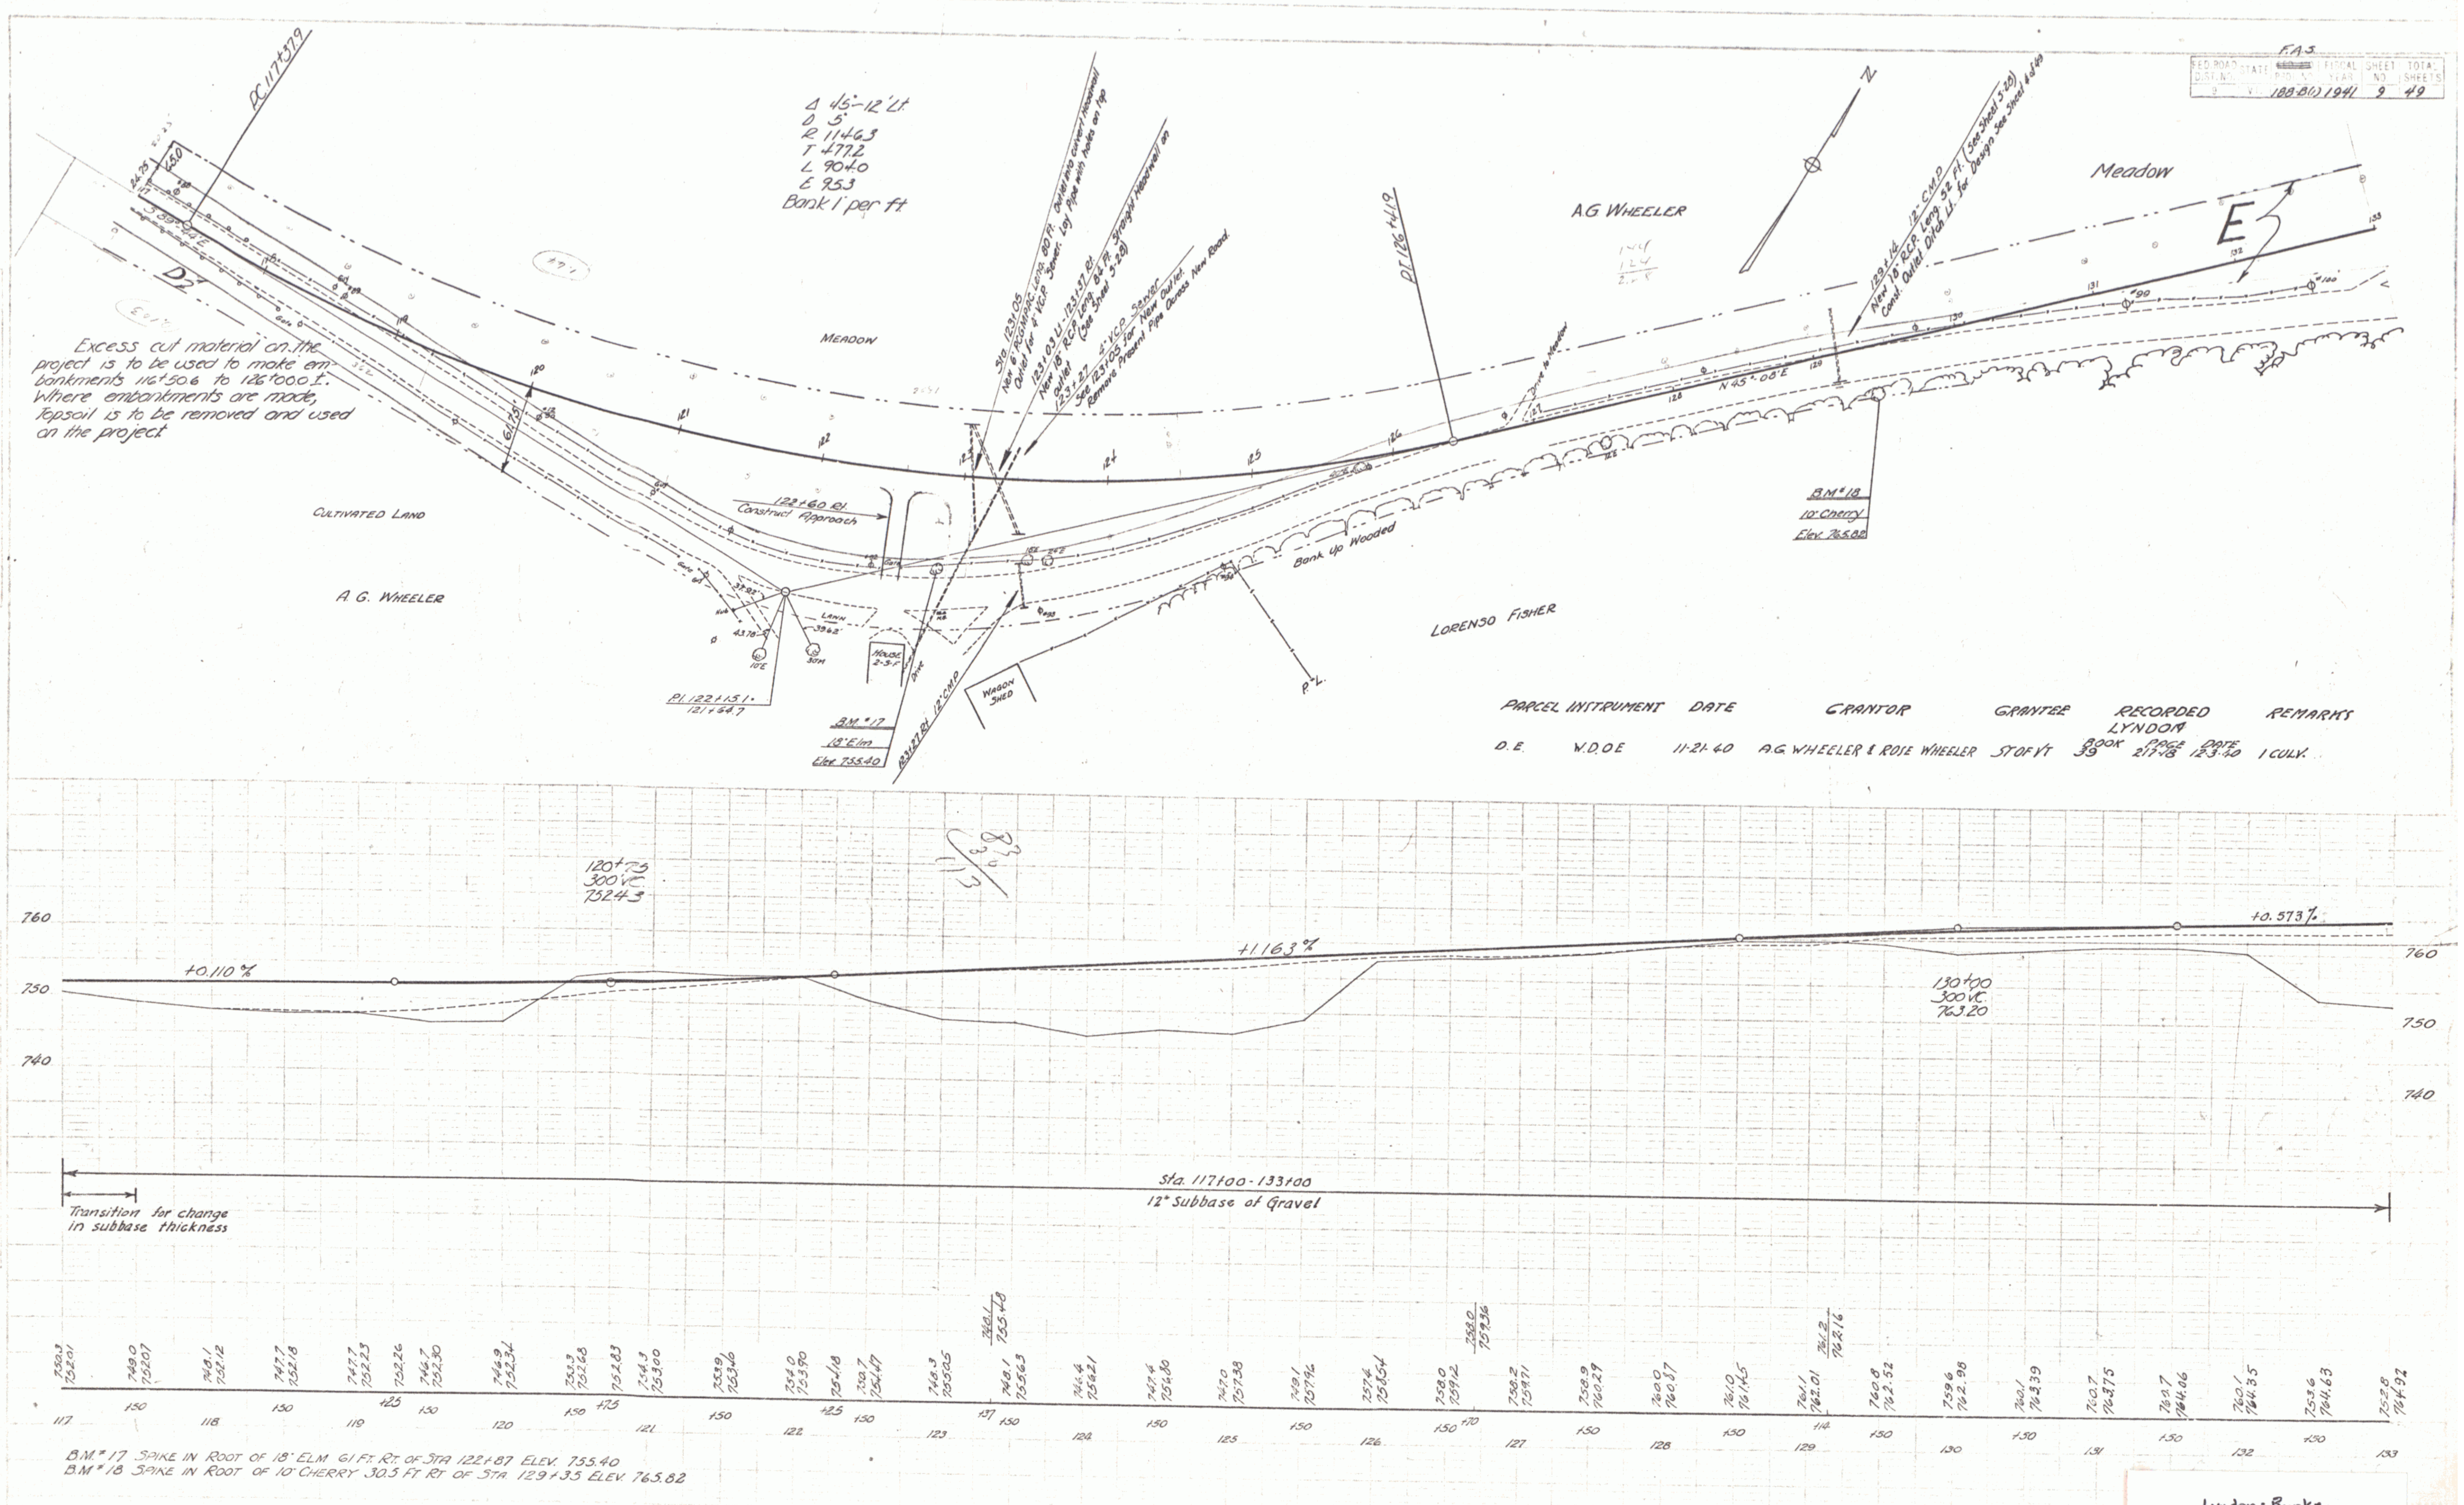

Lyndon - Burke
Series ST No 188N
SHEET 2 of

2