PARCEL	INSTRUMENT	DATE	GRANTOR	GRANTEE	RECORDED BOOK	PAGE	DATE	REMARKS
A	WDOE	MAR 21, '41	Victor & Rose Roberts	St. of Vt	39	227	4-1-41	
A'	WDOE	10-21-41	ARTHUR S CASWELL	ST OF VT	39	285	2-4-42	

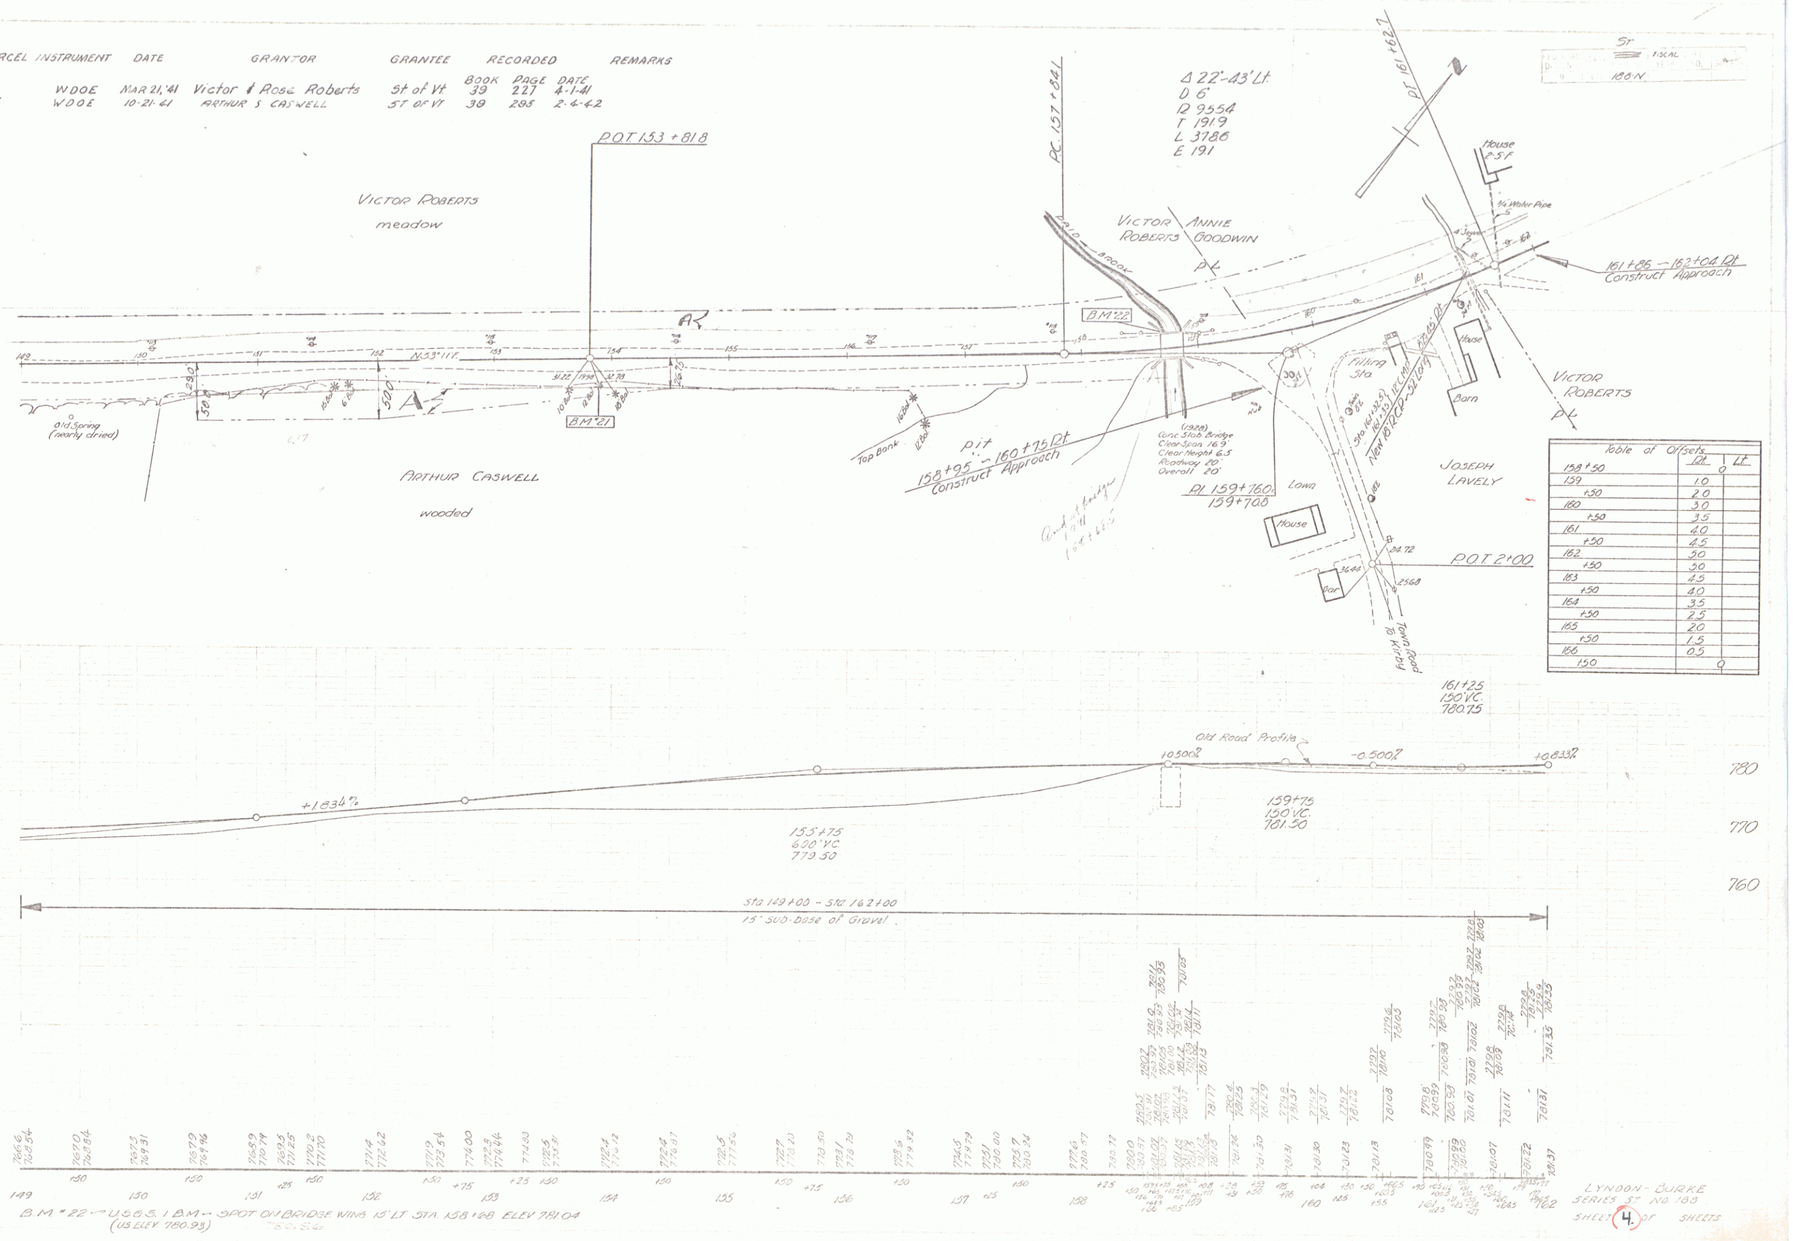

Table of Offsets	Rt.	Lt.
159+50	0	
159	1.0	
+50	2.0	
160	3.0	
+50	3.5	
161	4.0	
+50	4.5	
162	5.0	
+50	5.0	
163	4.5	
+50	4.0	
164	3.5	
+50	2.5	
165	2.0	
+50	1.5	
166	0.5	
150	0	

4