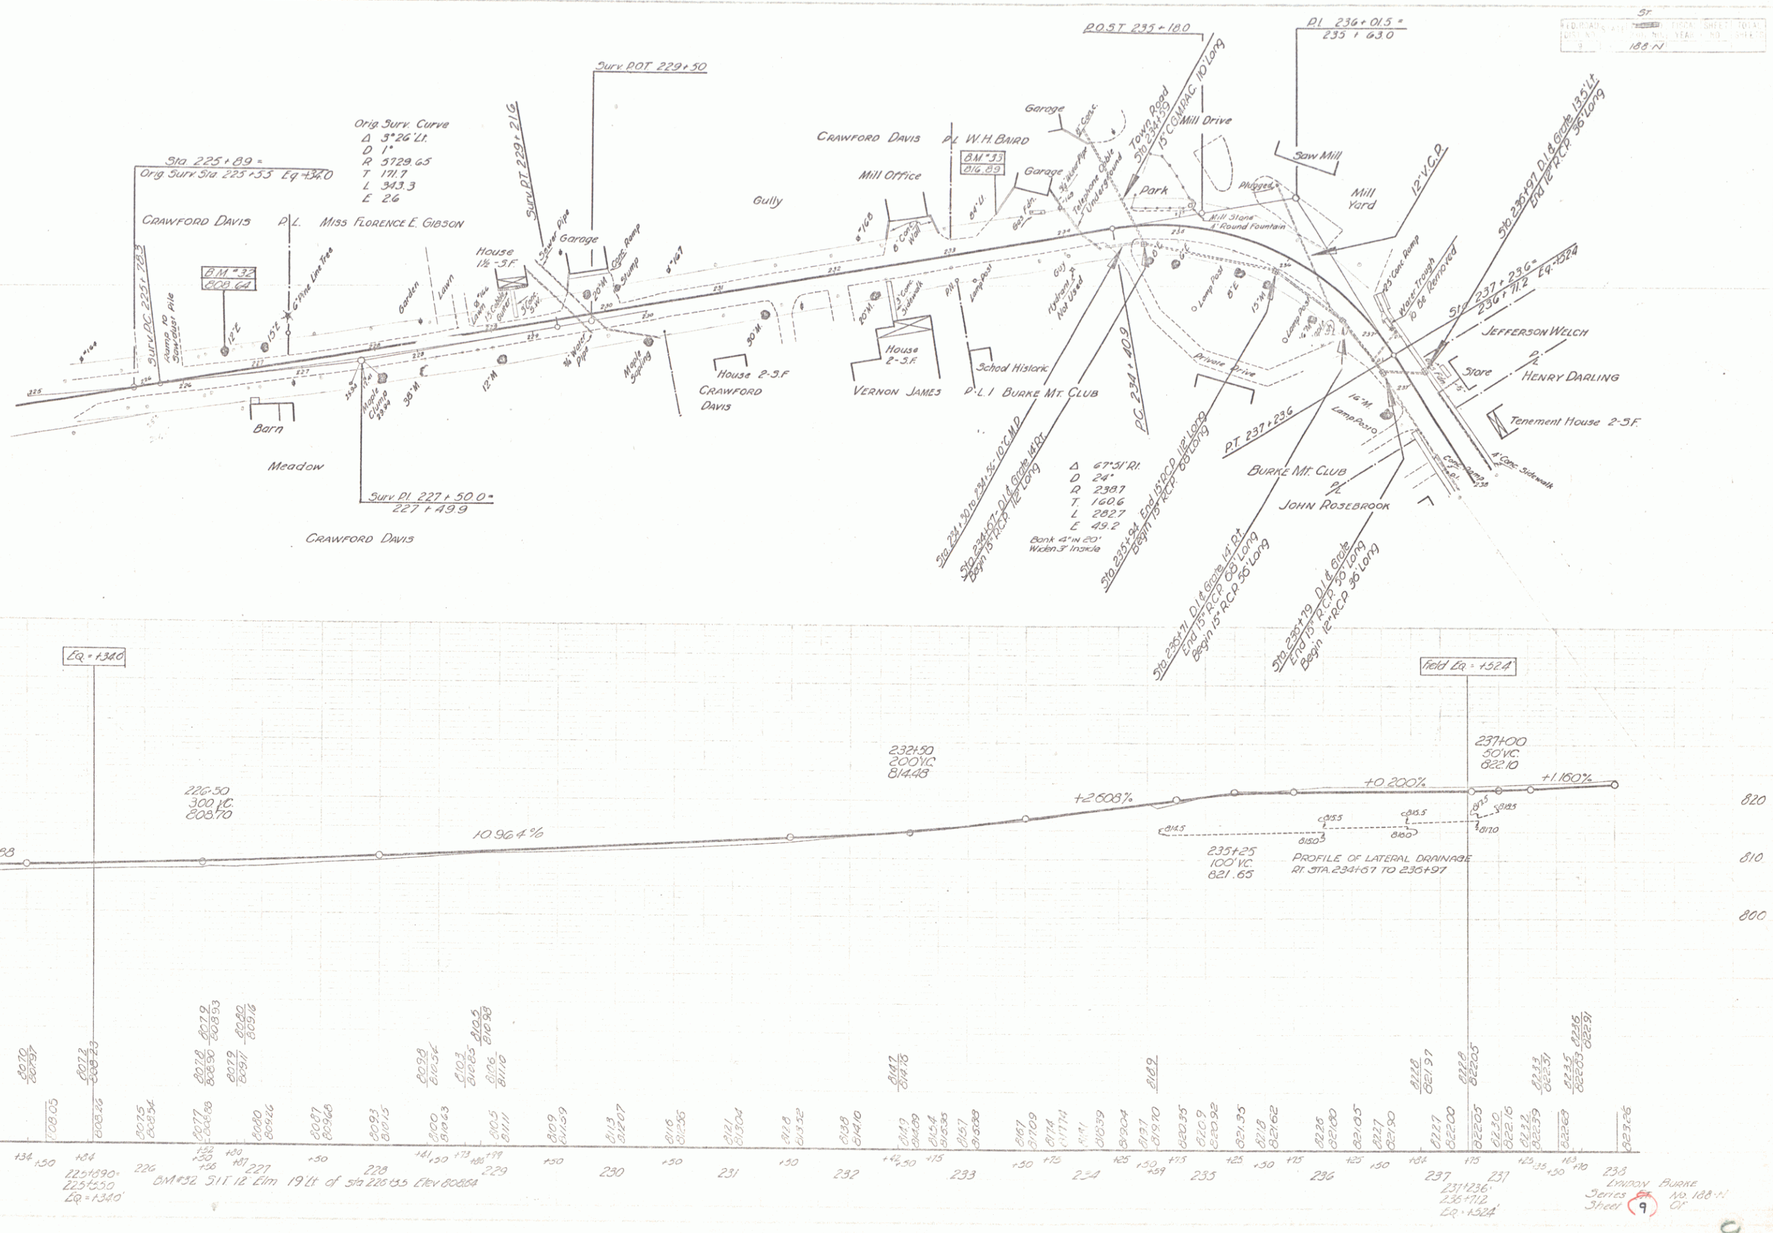
Sta 225+89 =
Orig Surv Sta 225+53 Eq +340
Orig Surv Curve
Δ 3°26' Lt.
D 1°
R 5729.65
T 171.7
L 343.3
E 2.6
CRAWFORD DAVIS
P.L. MISS FLORENCE E. GIBSON
Surv PC 225+72.3
Surv PT 229+21.6
Surv POT 229+50
House 1½-3F
Garage
Barn
Meadow
Surv PI 227+50.0 =
227+49.9
CRAWFORD DAVIS
Gully
House 2-3F
CRAWFORD DAVIS
Mill Office
CRAWFORD DAVIS
P.L. W.H. BAIRD
House 2-3F
VERNON JAMES
School House
P.L. BURKE MT. CLUB
POST 235+18.0
Town Road
Mill Drive
Park
Saw Mill
Mill Yard
Mill Stone & Round Fountain
Private Drive
PC 234+41.0
PT 237+23.6
BURKE MT. CLUB
P.L. JOHN ROSEBROOK
Sta 234+67 D.I. & Grate 18" Lt.
Begin 15" RCP 16" Long
Sta 235+94 End 15" RCP 116' Long
Begin 15" RCP 90' Long
Δ 67°51' Rt.
D 24°
R 238.7
T 160.6
L 282.7
E 49.2
Bank 4" in 20'
Widen 3' Inside
Sta 236+71 D.I. & Grate 14" Lt.
End 15" RCP 103' Long
Begin 15" RCP 90' Long
Sta 237+79 D.I. & Grate
End 15" RCP 90' Long
Begin 15" RCP 90' Long
Sta 235+97 D.I. & Grate 13.5' Lt.
End 15" RCP 90' Long
Sta 237+23.6 =
236+71.2 Eq +152.4
JEFFERSON WELCH
P.L.
Store
HENRY DARLING
Tenement House 2-3F
Eq = +340
Field Eq = +152.4
820
810
800
10+88
226+50
300' VC
808.70
10.96 4%
232+50
200' VC
814.48
+2.608%
+0.200%
+1.160%
237+00
50' VC
822.10
235+25
100' VC
821.65
PROFILE OF LATERAL DRAINAGE
PI. STA. 234+67 TO 235+97
225
226
227
228
229
230
231
232
233
234
235
236
237
238
BM #32 3'LT 12" Elm 19' Lt of Sta 228+35 Elev 808.64
225+89=
225+53
Eq = +340'
237+236=
235+71.2
Eq = +152.4'
LYNDON BURKE
Series 8
Sheet 9
No. 188-H
Of

9