FEDERAL AID PROJECT NO.	STATE	ST	FISCAL YEAR	SHEET NO.	TOTAL SHEETS
	VT	188-N			

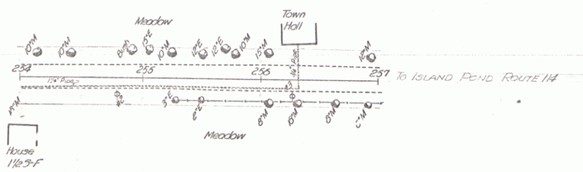

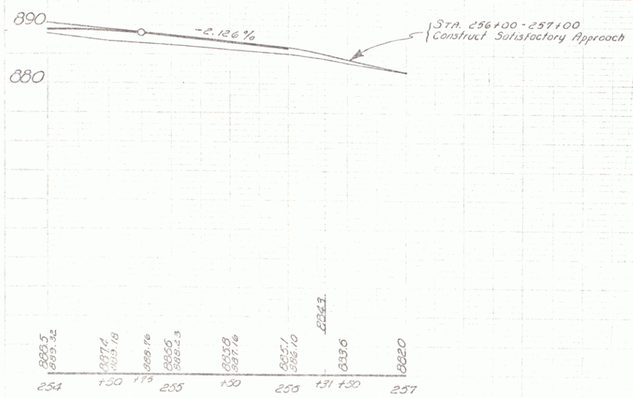

Lyndon - Burke
Series ST No 188 N
Sheet 11 of Sheets

11