



PARCEL #1, 18B #1C
 INSTRUMENT W.D.O.E. W.D.O.E.
 DATE 5-18-51 10-18-51

GRANTOR Morris D. & Elvira M. Noyes de M. Noyes
 GRANTEE STATE OF VERMONT de

RECORDED Newark NEWARK
 BOOK 19 19
 PAGE 192-93 197
 DATE 5-31-51 9-23-51

REMARKS: #1 B on sheet 10/12 See sheet 12


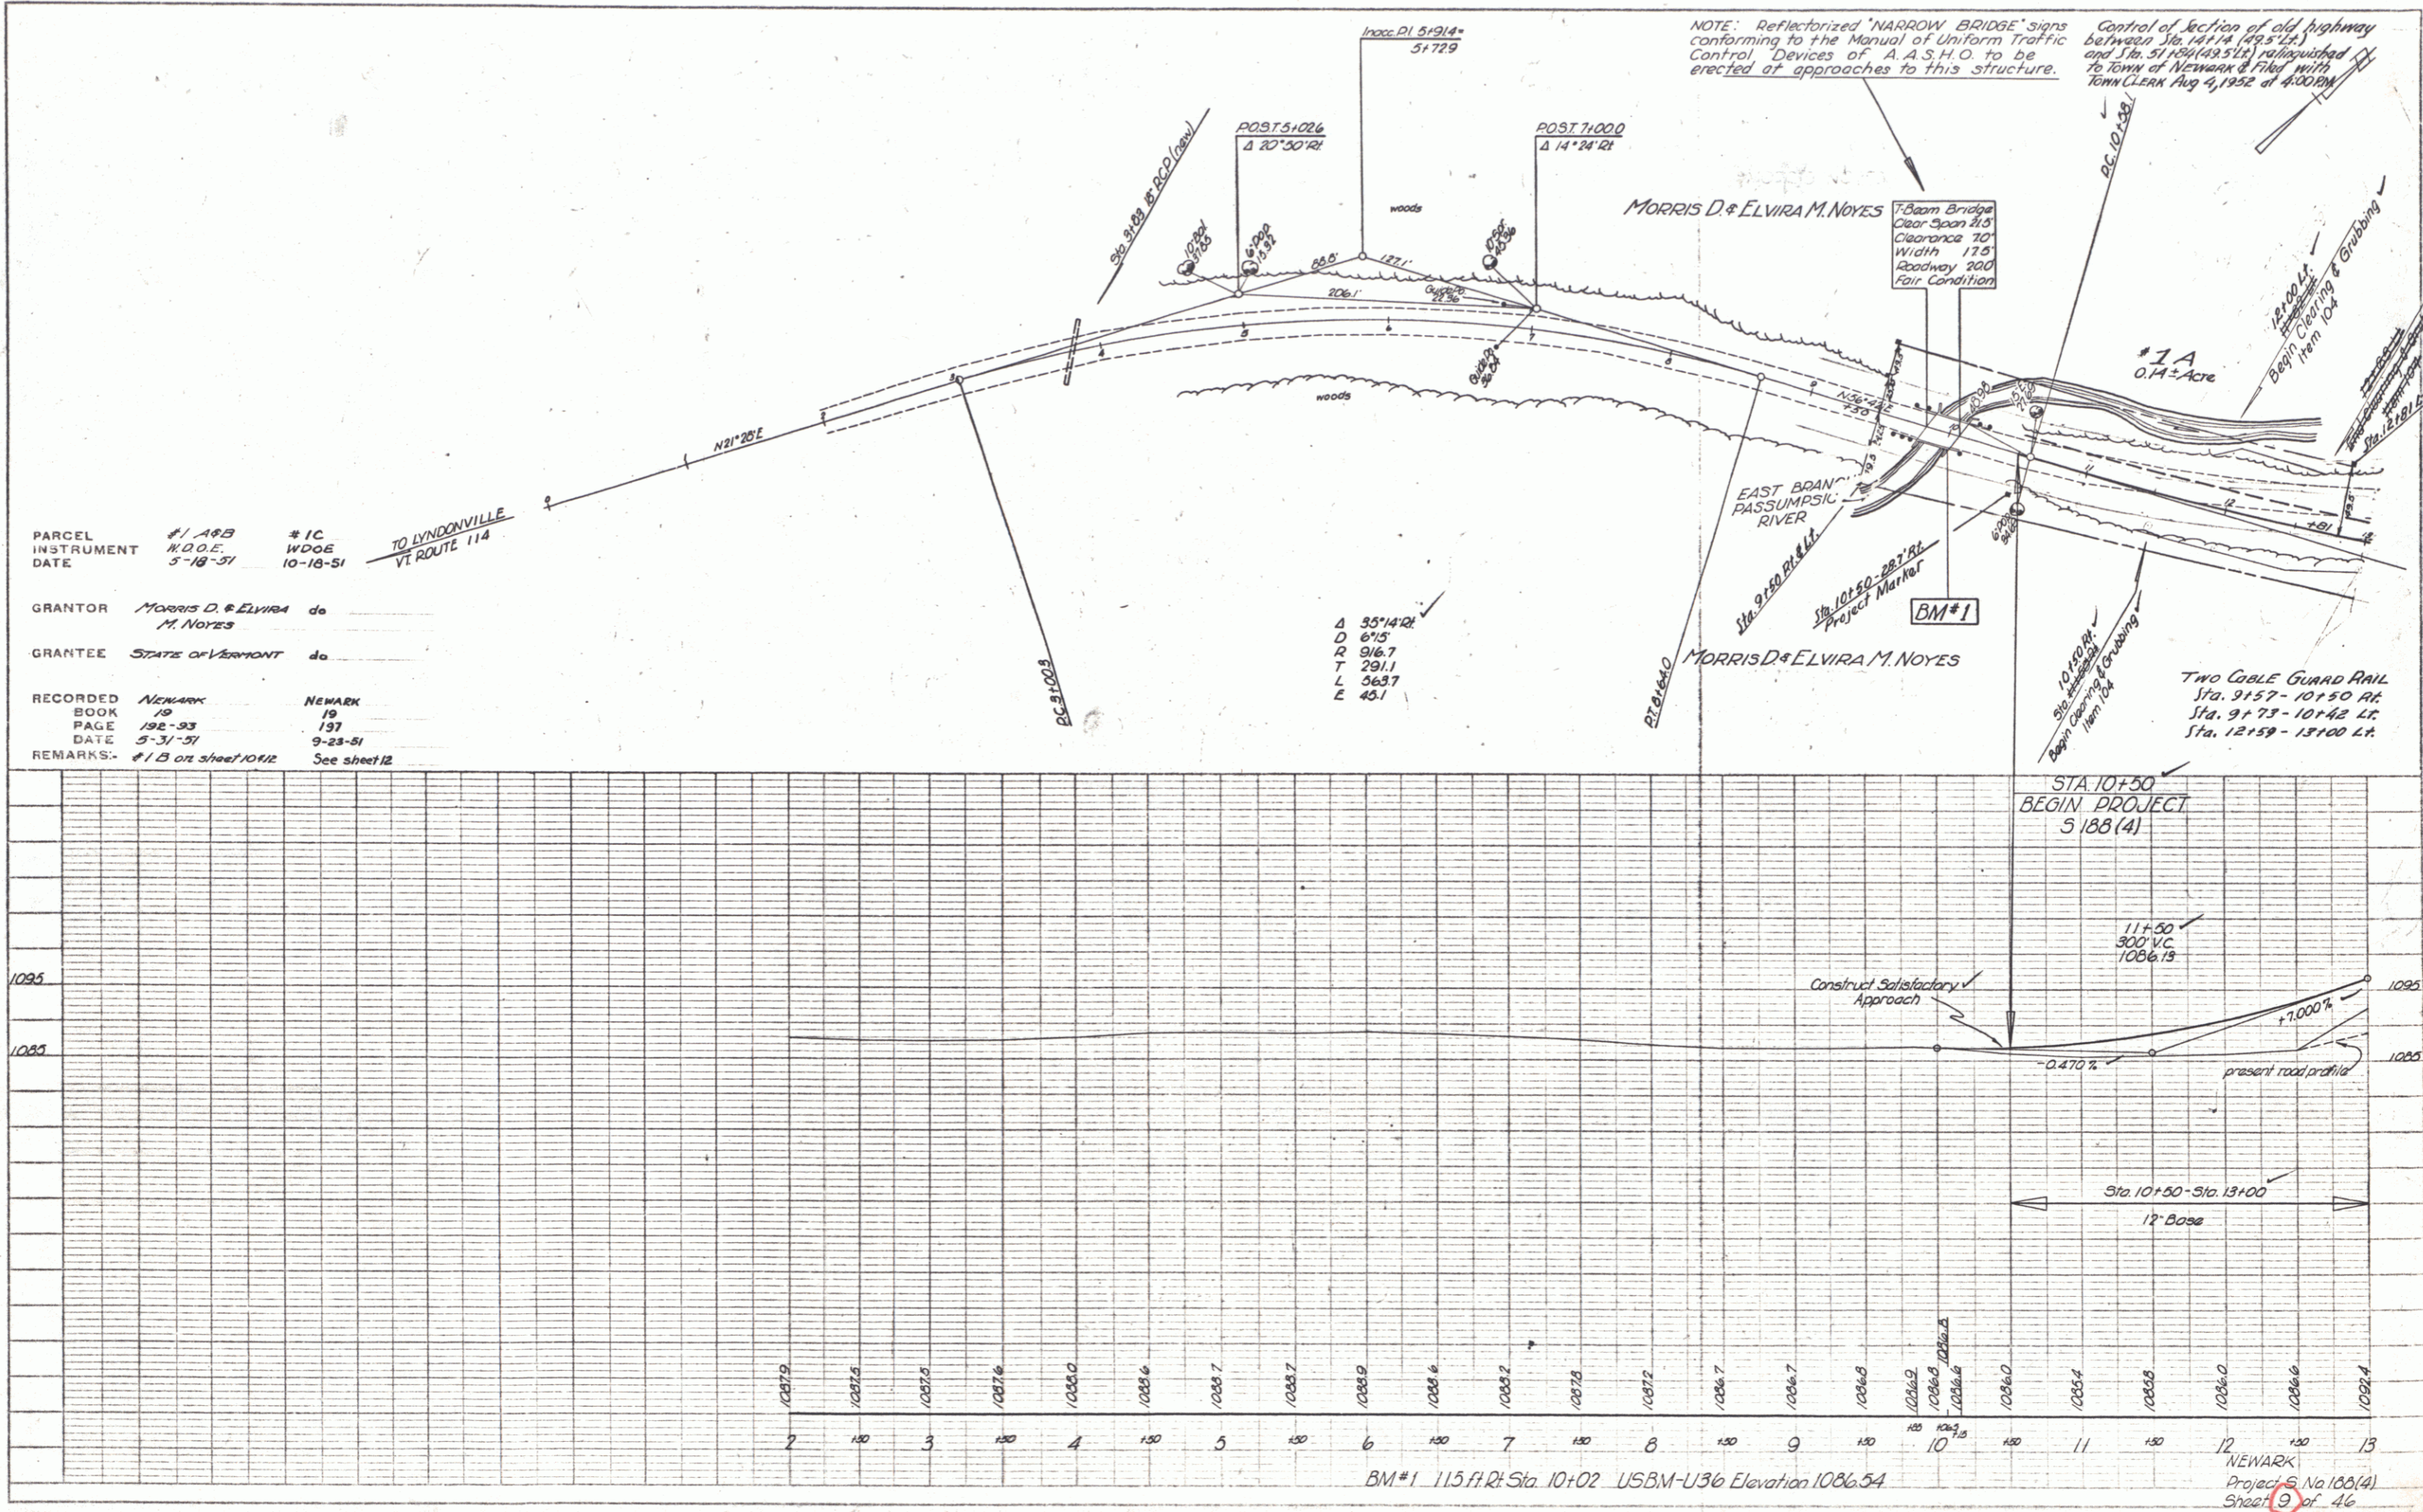

BM #1 115 Ft. Sta. 10+02 USBM-U36 Elevation 1086.54

NEWARK Project No 100(4) Sheet 9 of 46