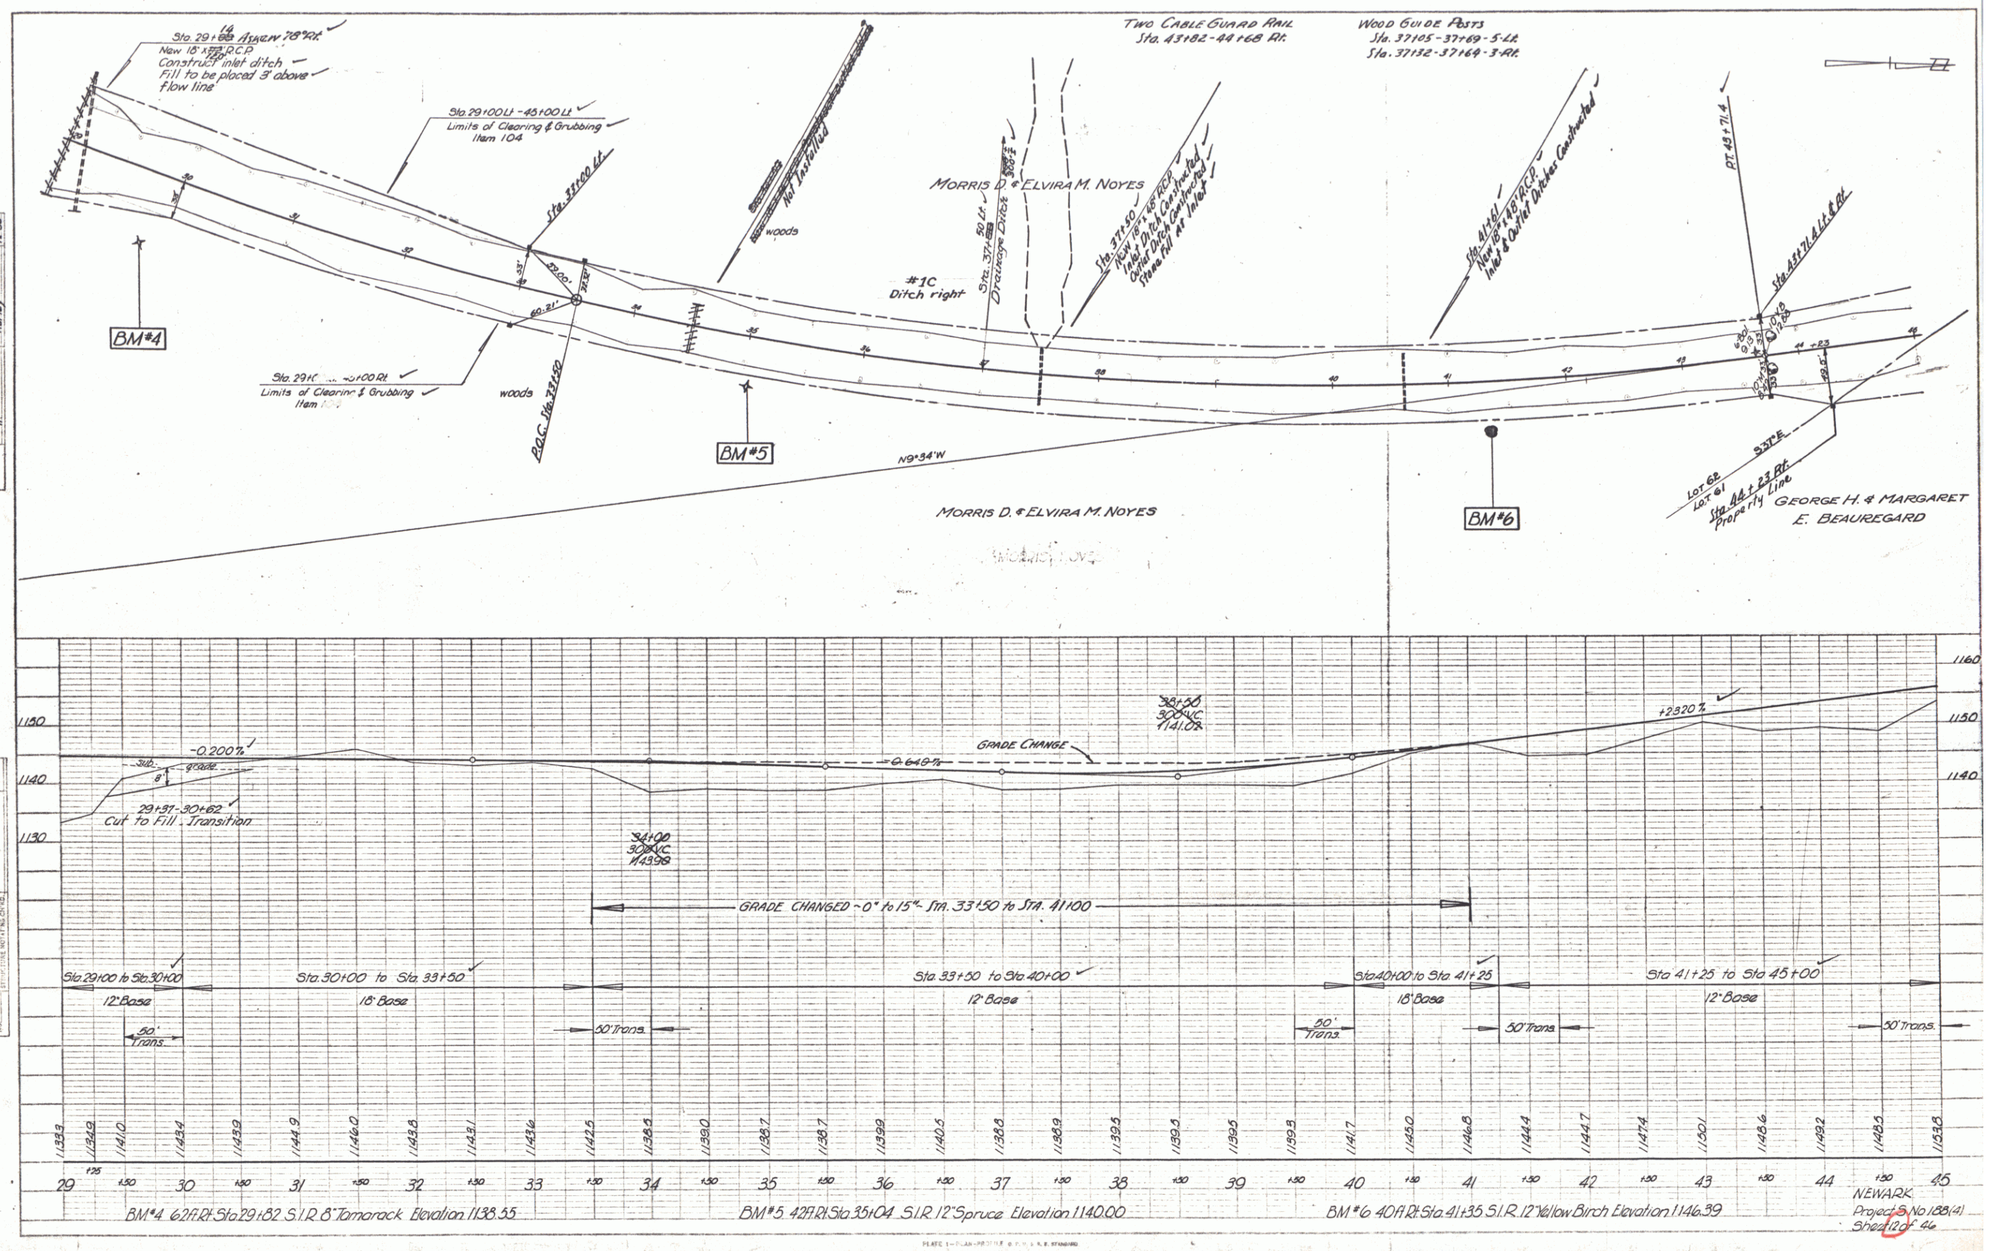

PLAN
SURVEYED
PLOTTED
NOTE BOOK ALIGNMENT CHECKED
NO. BY WHOM PROFILE CHECKED
A. Levin 8-30
Hurley 12-4
Hurley 12-50

PROFILE
SURVEYED
PLOTTED
NOTE BOOK GRADES CHECKED
NO. S. W. NOTES
A. Levin 8-30
Hurley 12-4
Hurley 12-50