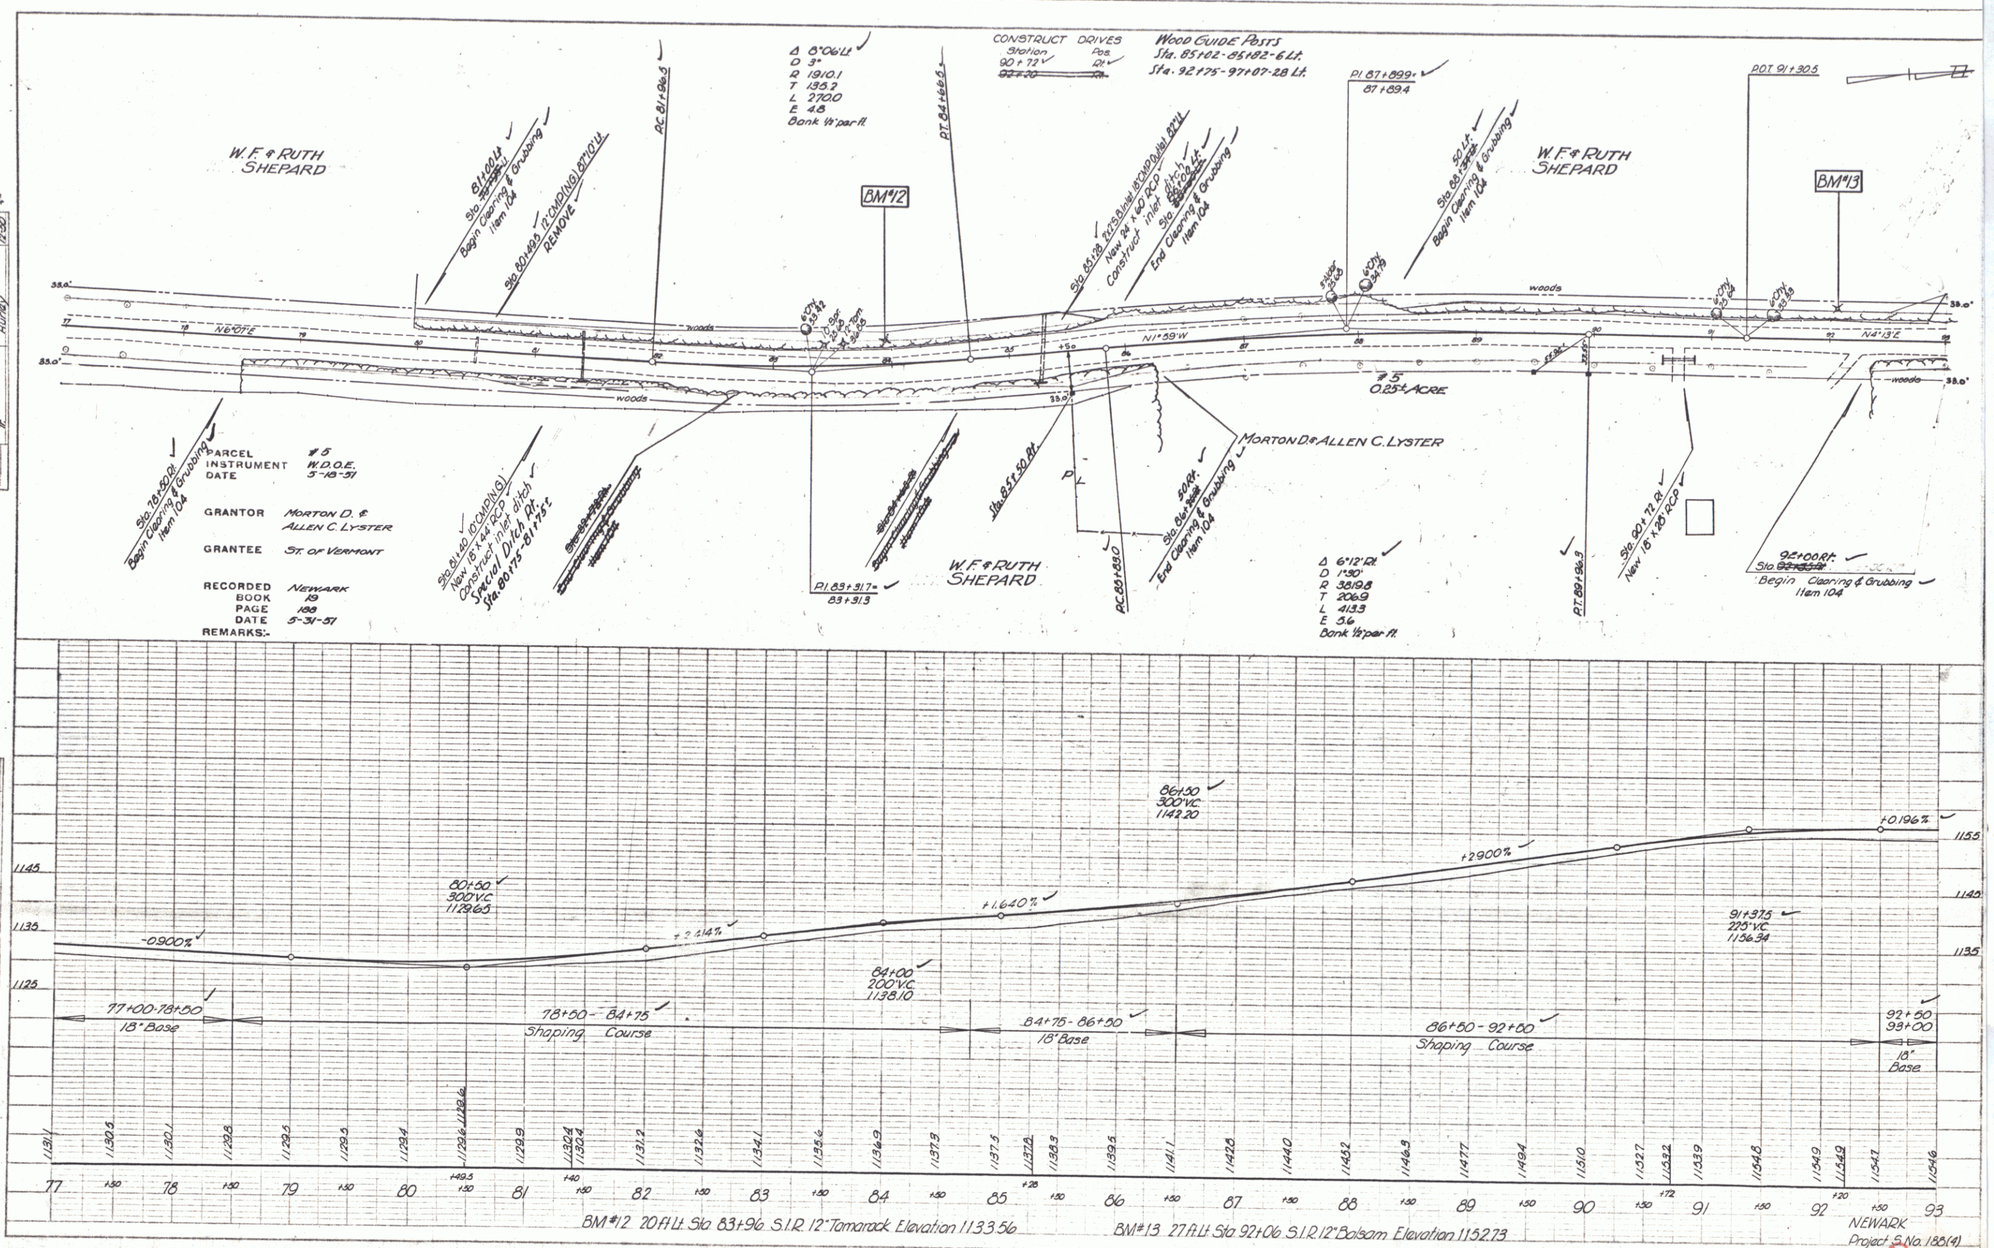


PLAN — Submitted: A. Levin; Plotted: Hurley; Checked: Hurley; Date: 8-29-52; Time: 12:30

C-FILE — Submitted: A. Levin; Plotted: Hurley; Checked: Hurley; Date: 8-29-52; Time: 12:30

PLATE 1 — PLAN-PROFILE U.P.R.R. & R.E. STANDARD

K & E Co. N.Y.

7