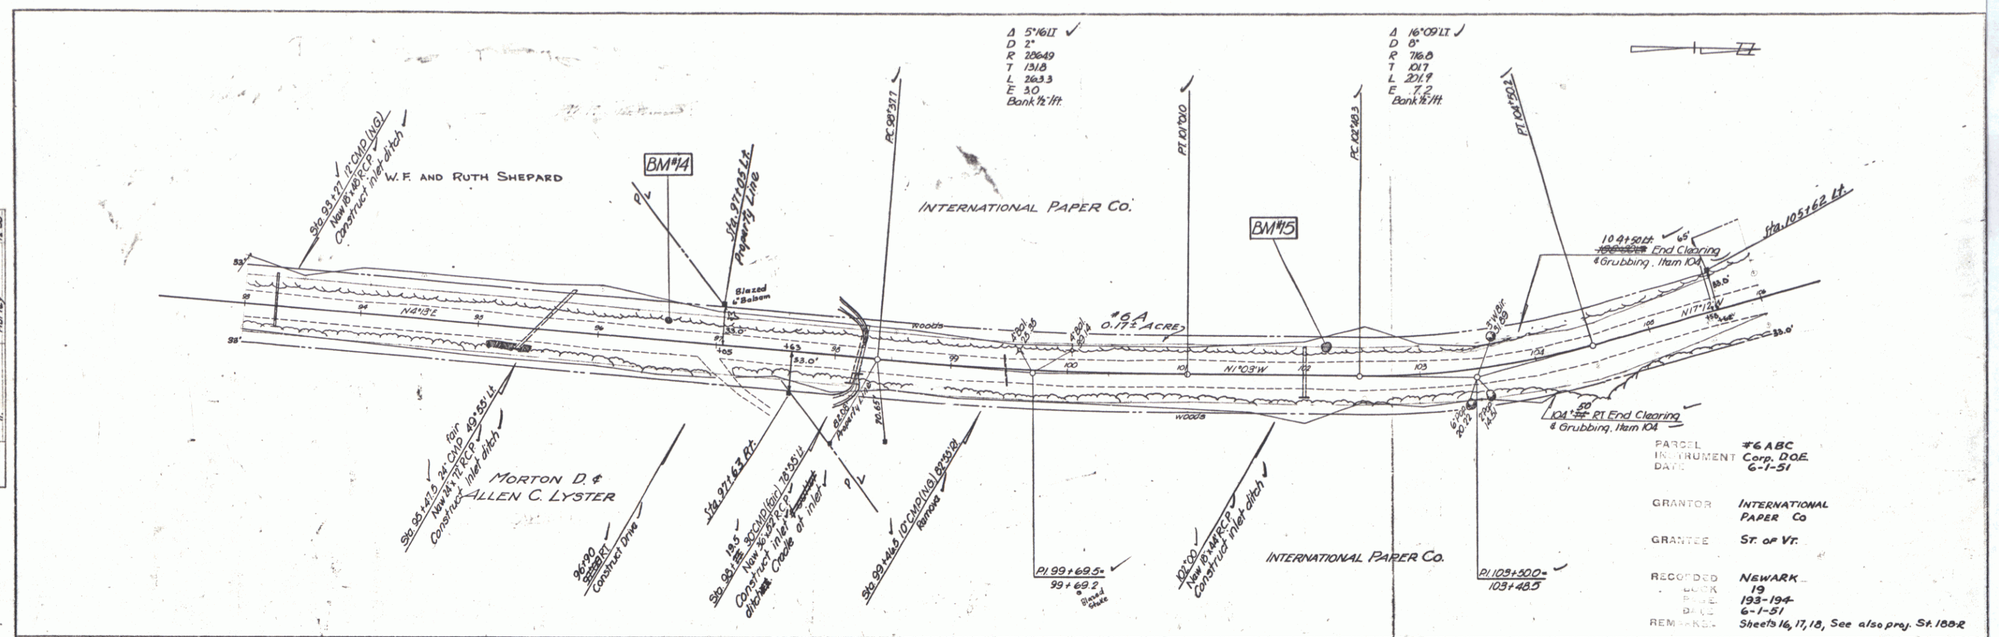

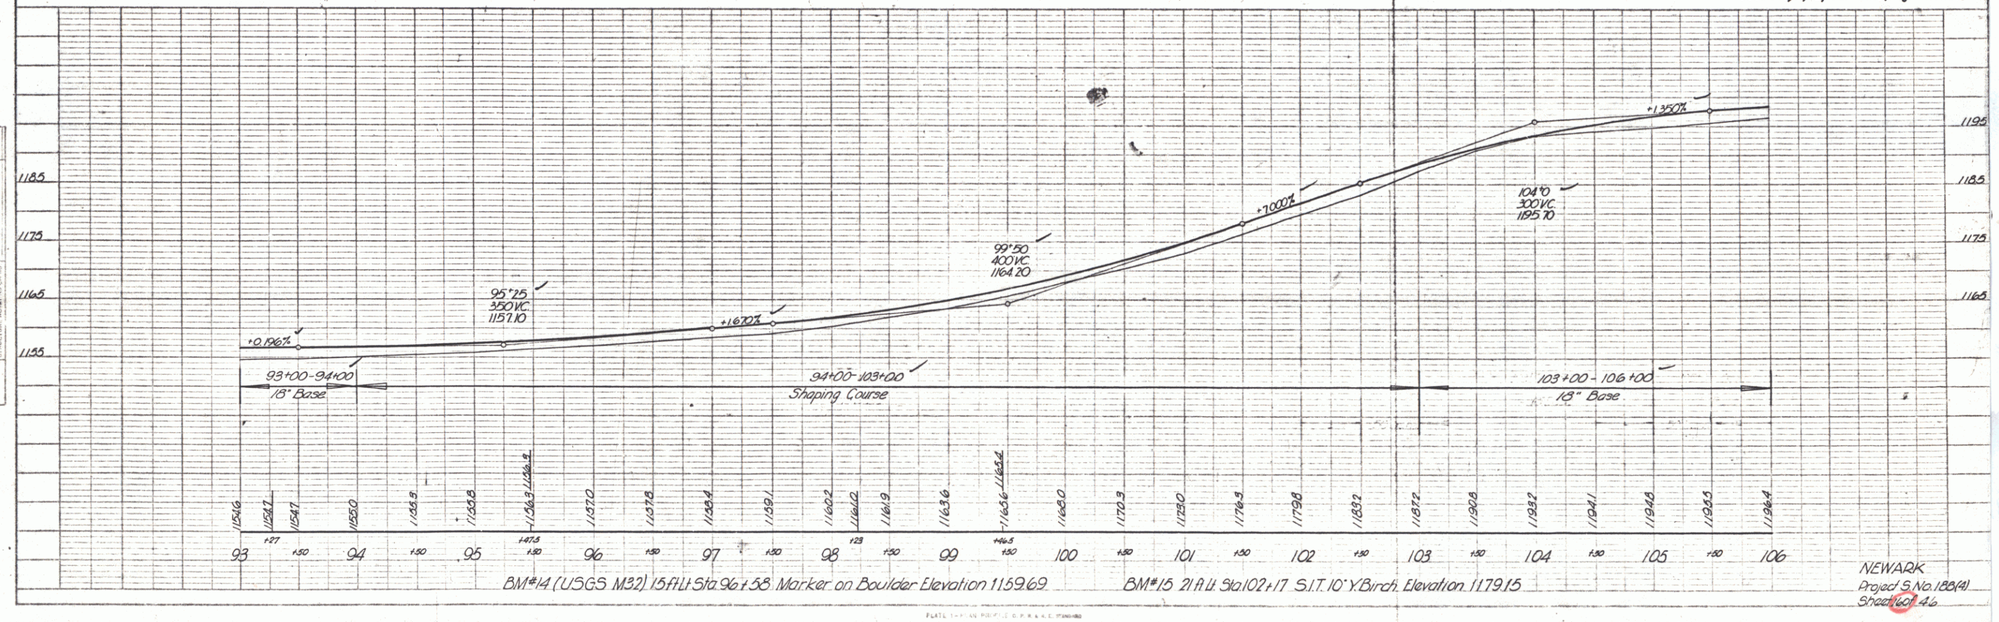

NEWARK
Project S. No. 188(4)
Sheet 16 of 46

8