PARCEL	INSTRUMENT	DATE	GRANTOR	GRANTEE	RECORDED BRIGHTON BOOK	PAGE	DATE	REMARKS

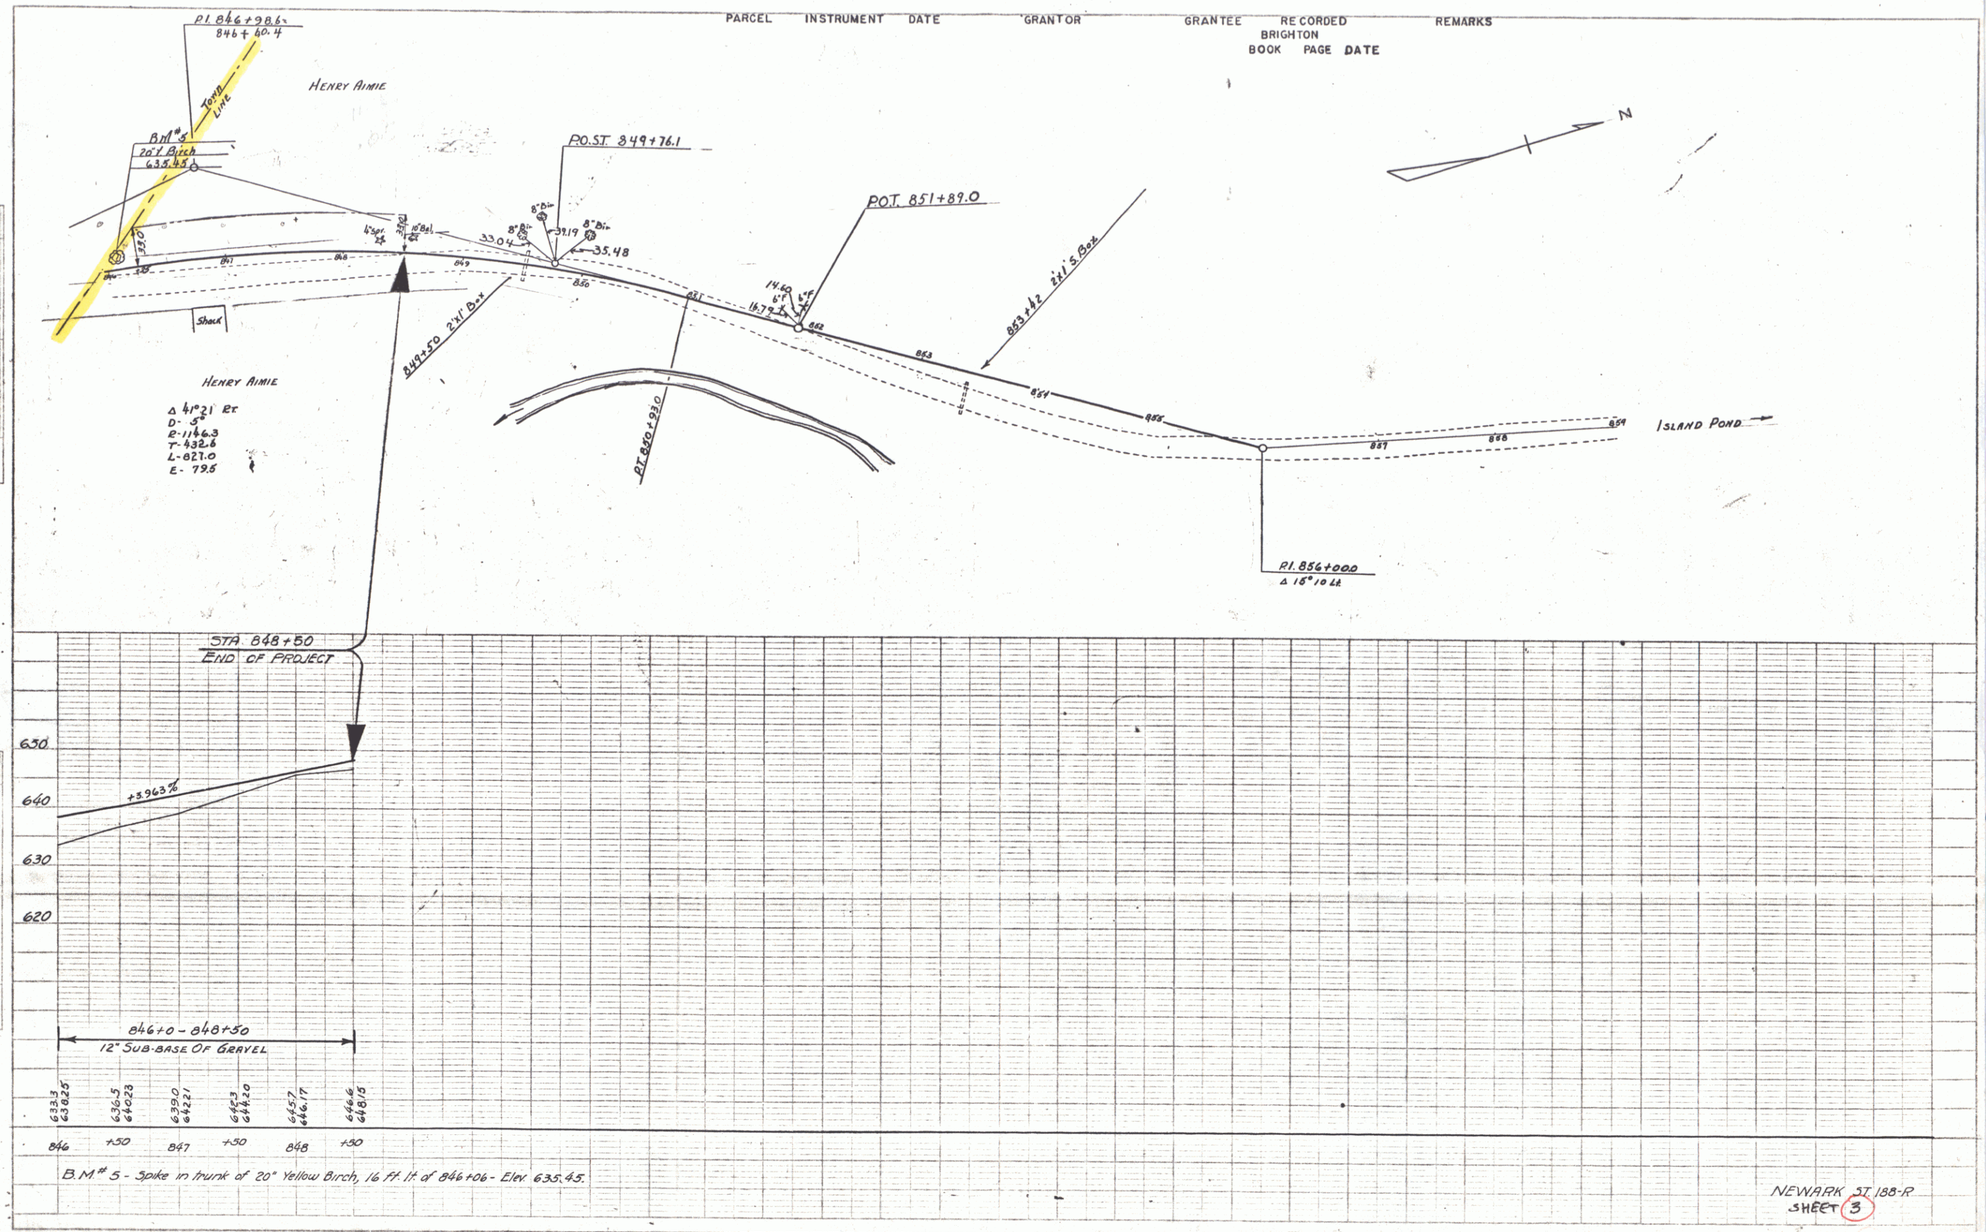

B.M. # 5 - Spike in trunk of 20" Yellow Birch, 16 ft. lt. of 846+06 - Elev. 635.45.

NEWARK ST 188-R
SHEET 3

PLAN
SURVEYED
PLOTTED
NOTE BOOK
NO.
PT. OF BEG. CH. 0+00

PROFILE
PLOTTED
GRADES CHECKED
B.M. NOTED
STRUCTURE DATA
NOTE BOOK
NO.

PLATE 1 - PLAN-PROFILE C.P.R.A.R.C. STANDARD

3