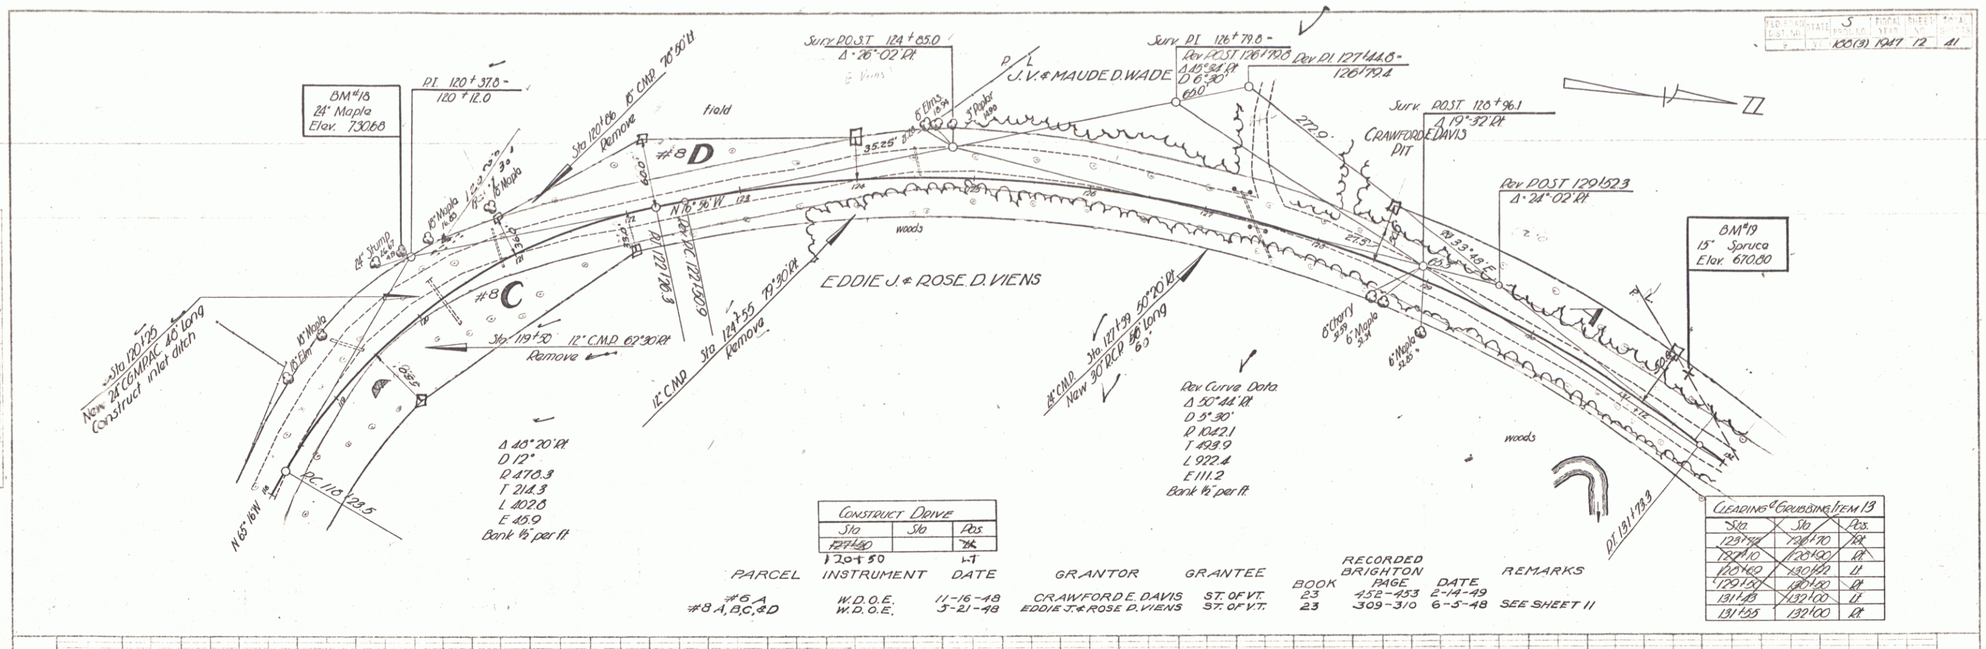

Construct Drive		
Sta	Sta	Pos.
~~127+50~~		~~Rt~~
120+50		LT

Clearing & Grubbing Item 13		
Sta	Sta	Pos.
~~129+70~~	~~129+70~~	~~Rt~~
~~129+70~~	~~129+90~~	~~Rt~~
129+90	130+90	Lt
~~129+90~~	~~130+90~~	~~Rt~~
131+48	132+00	Lt
131+55	132+00	Rt

PARCEL	INSTRUMENT	DATE	GRANTOR	GRANTEE	RECORDED BRIGHTON BOOK	PAGE	DATE	REMARKS
#6 A	W.D.O.E.	11-16-48	CRAWFORD E. DAVIS	ST. OF VT.	23	452-453	2-14-49	
#8 A, B, C, & D	W.D.O.E.	5-21-48	EDDIE J. & ROSE D. VIENS	ST. OF VT.	23	309-310	6-5-48	SEE SHEET 11

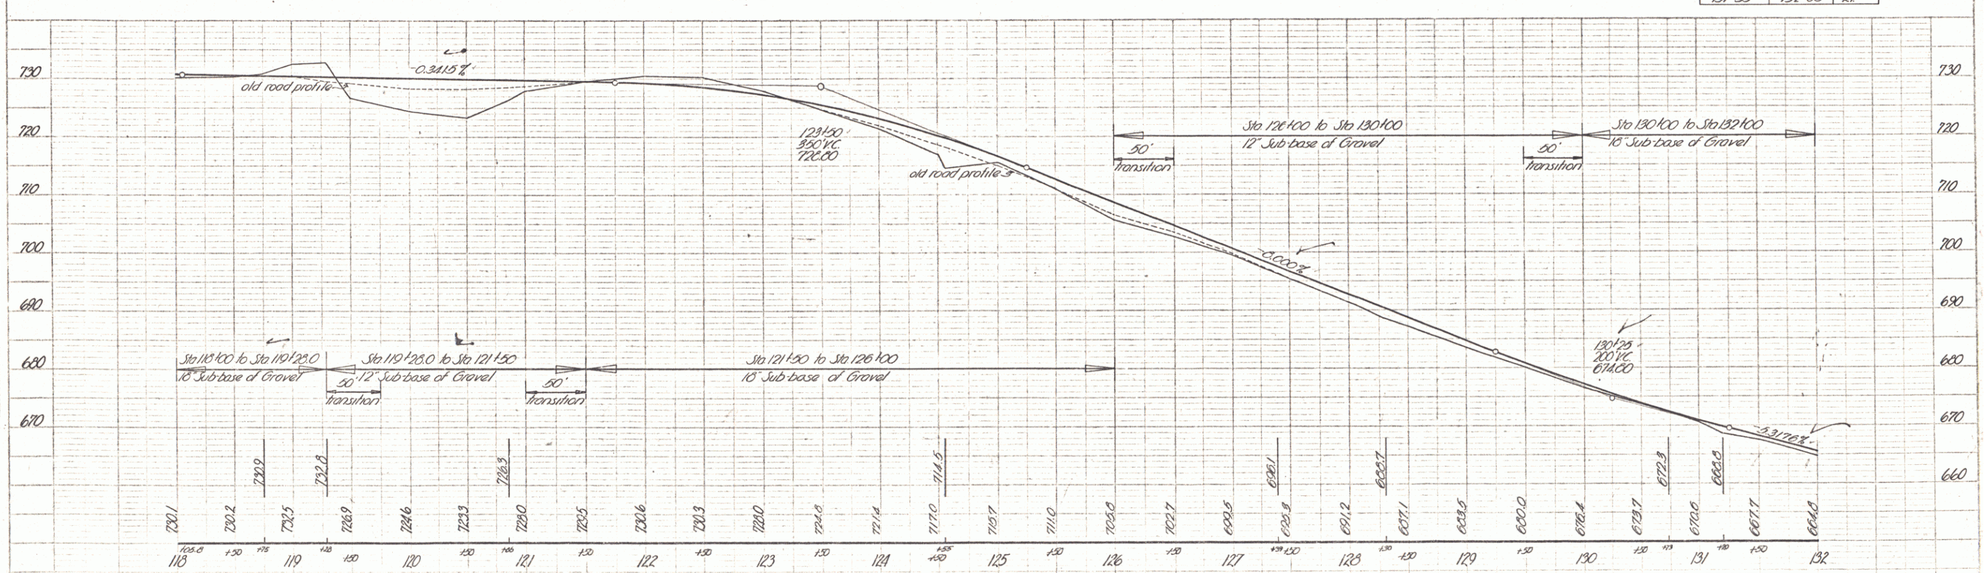

BM #18 Spike in root 24" Maple 49 ft. Rt. Sta. 120+22 Elev. 730.68
BM #19 Spike in root 12" Spruce 42 ft. Lt. Sta. 131+20 Elev. 670.80

BRIGHTON
Series S No 188 (2)
Sheet 12 of 41 Sheets

11