FED. ROAD DIST. NO.	STATE	S PROJ. NO.	FISCAL YEAR	SHEET NO.	TOTAL SHEETS
9	VT.	205(3)		10	48

PARCEL #1 A, B, C, D, E, & F, G.
INSTRUMENT W. D. O. E.
DATE 8-10-49

GRANTOR CLAUDE M. & BLANCHE S. MAXWELL

GRANTEE ST. OF VT.

RECORDED BRIGHTON
BOOK 24
PAGE 12-14
DATE 8-23-49
REMARKS: #1 C & D ON SHEET 11 #1G - CHANNEL RTS.
#1 E & F ON SHEET 12 ON SHEET 12

PLAN		BY	DATE
NOTE BOOK	SURVEYED	A. Lavin	6-48
NO.	PLOTTED	McLeod	7-48
	ALIGNMENT CHECKED		
	RT. OF WAY CHECKED		
	TRACED	Houghton	8-48

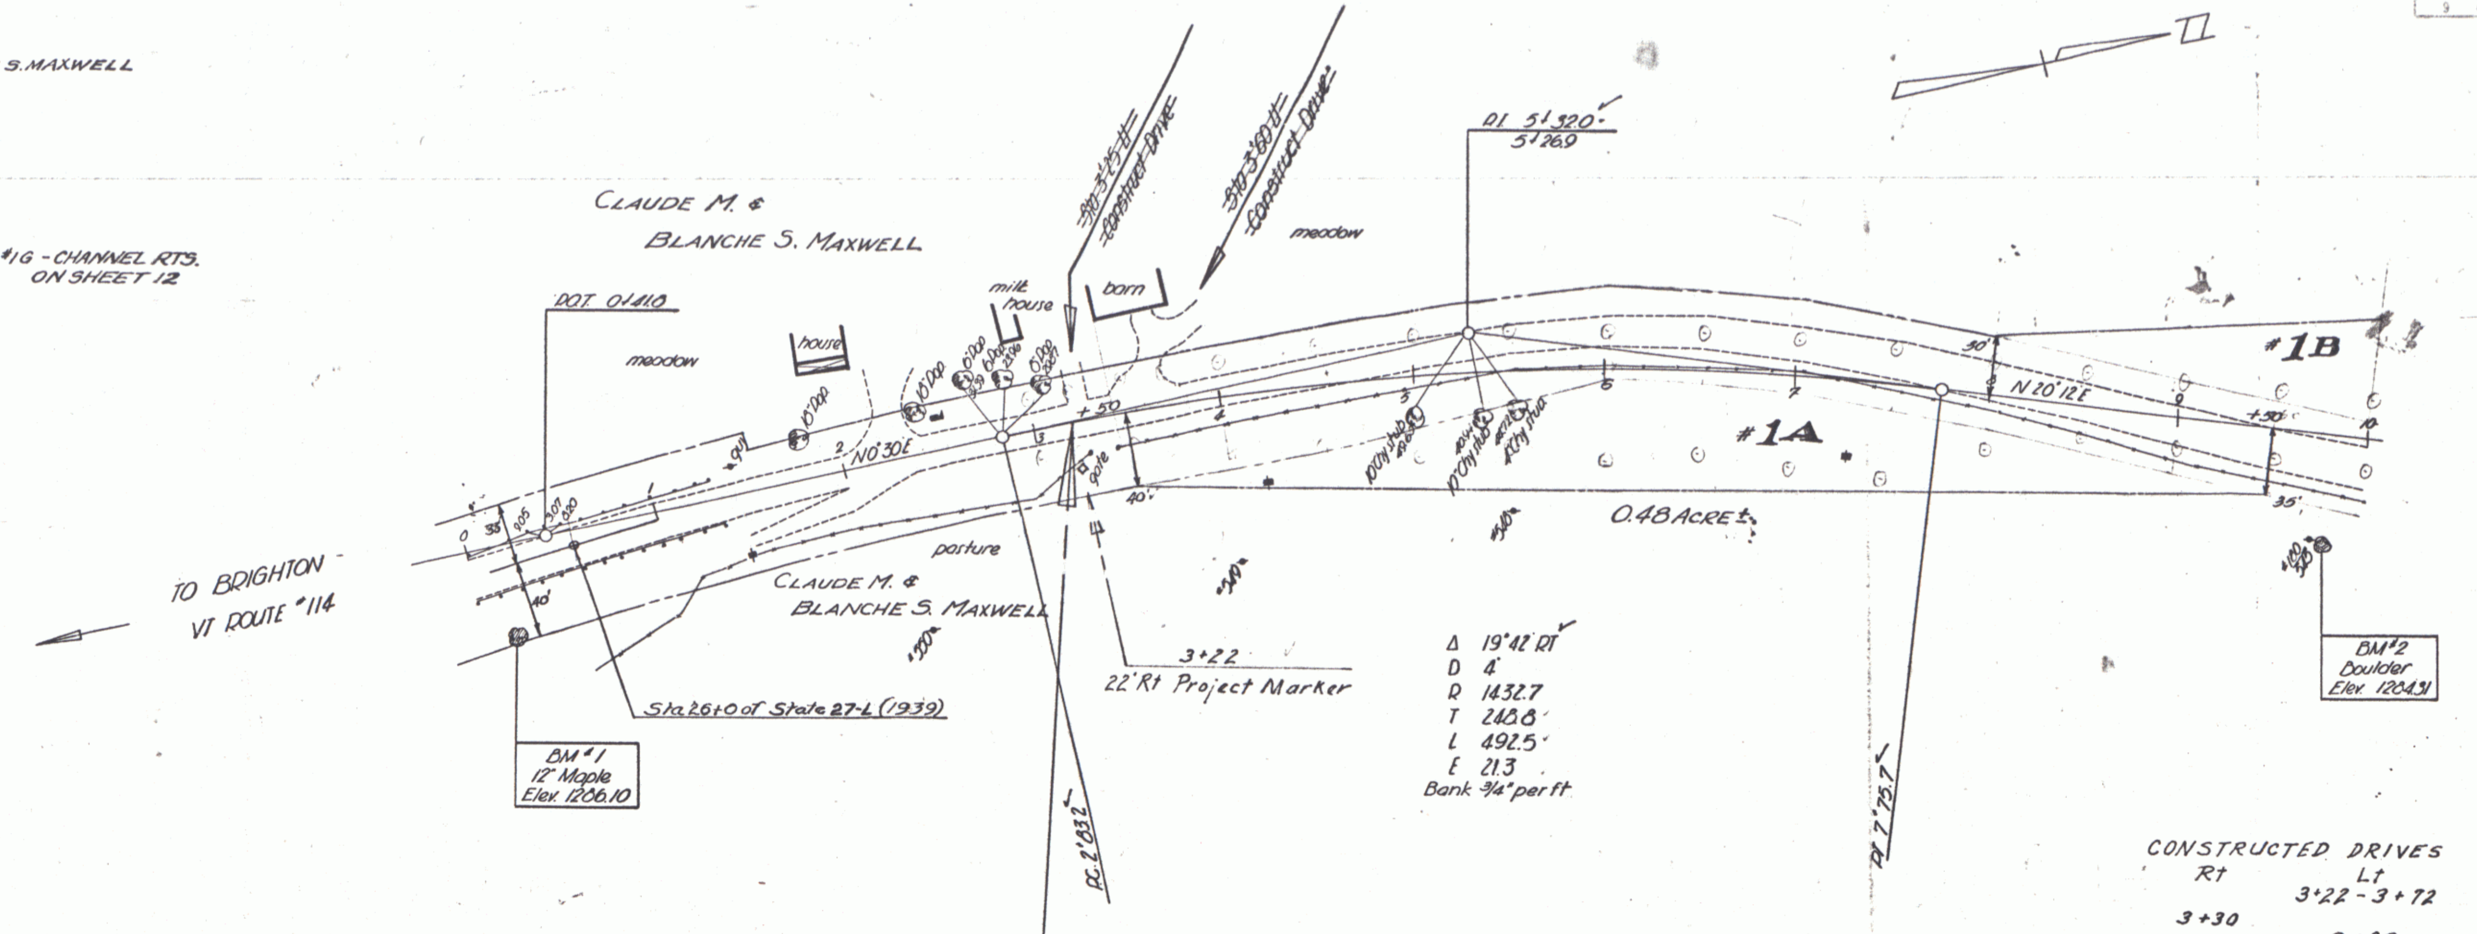
CLAUDE M. &
BLANCHE S. MAXWELL
~~Sta 3+45 Lt Construct Drive~~
~~Sta 3+60 Lt Construct Drive~~
meadow
milk house
barn
house
meadow
P.O.T. 0+41.0
P.I. 5+32.0
5+26.9
NO°30'E
N20°12'E
#1A
#1B
0.48 ACRE±
TO BRIGHTON
VT ROUTE #114
pasture
gate
CLAUDE M. &
BLANCHE S. MAXWELL
3+22
22' Rt Project Marker
Sta 26+0 of State 27-L (1939)
BM #1
12" Maple
Elev. 1286.10
P.C. 2+83.2
P.T. 7+75.7
Δ 19°42' RT
D 4°
R 1432.7
T 248.8
L 492.5
E 21.3
Bank 3/4" per ft
BM #2
Boulder
Elev. 1284.31
15" Pop
10" Pop
6" Pop
10" Chy stub
4" Chy stub
40'
35'
30'
0
1
2
3
4
5
6
7
8
9
10
+50

CONSTRUCTED DRIVES
Rt Lt
3+30 3+22 - 3+72
8+20

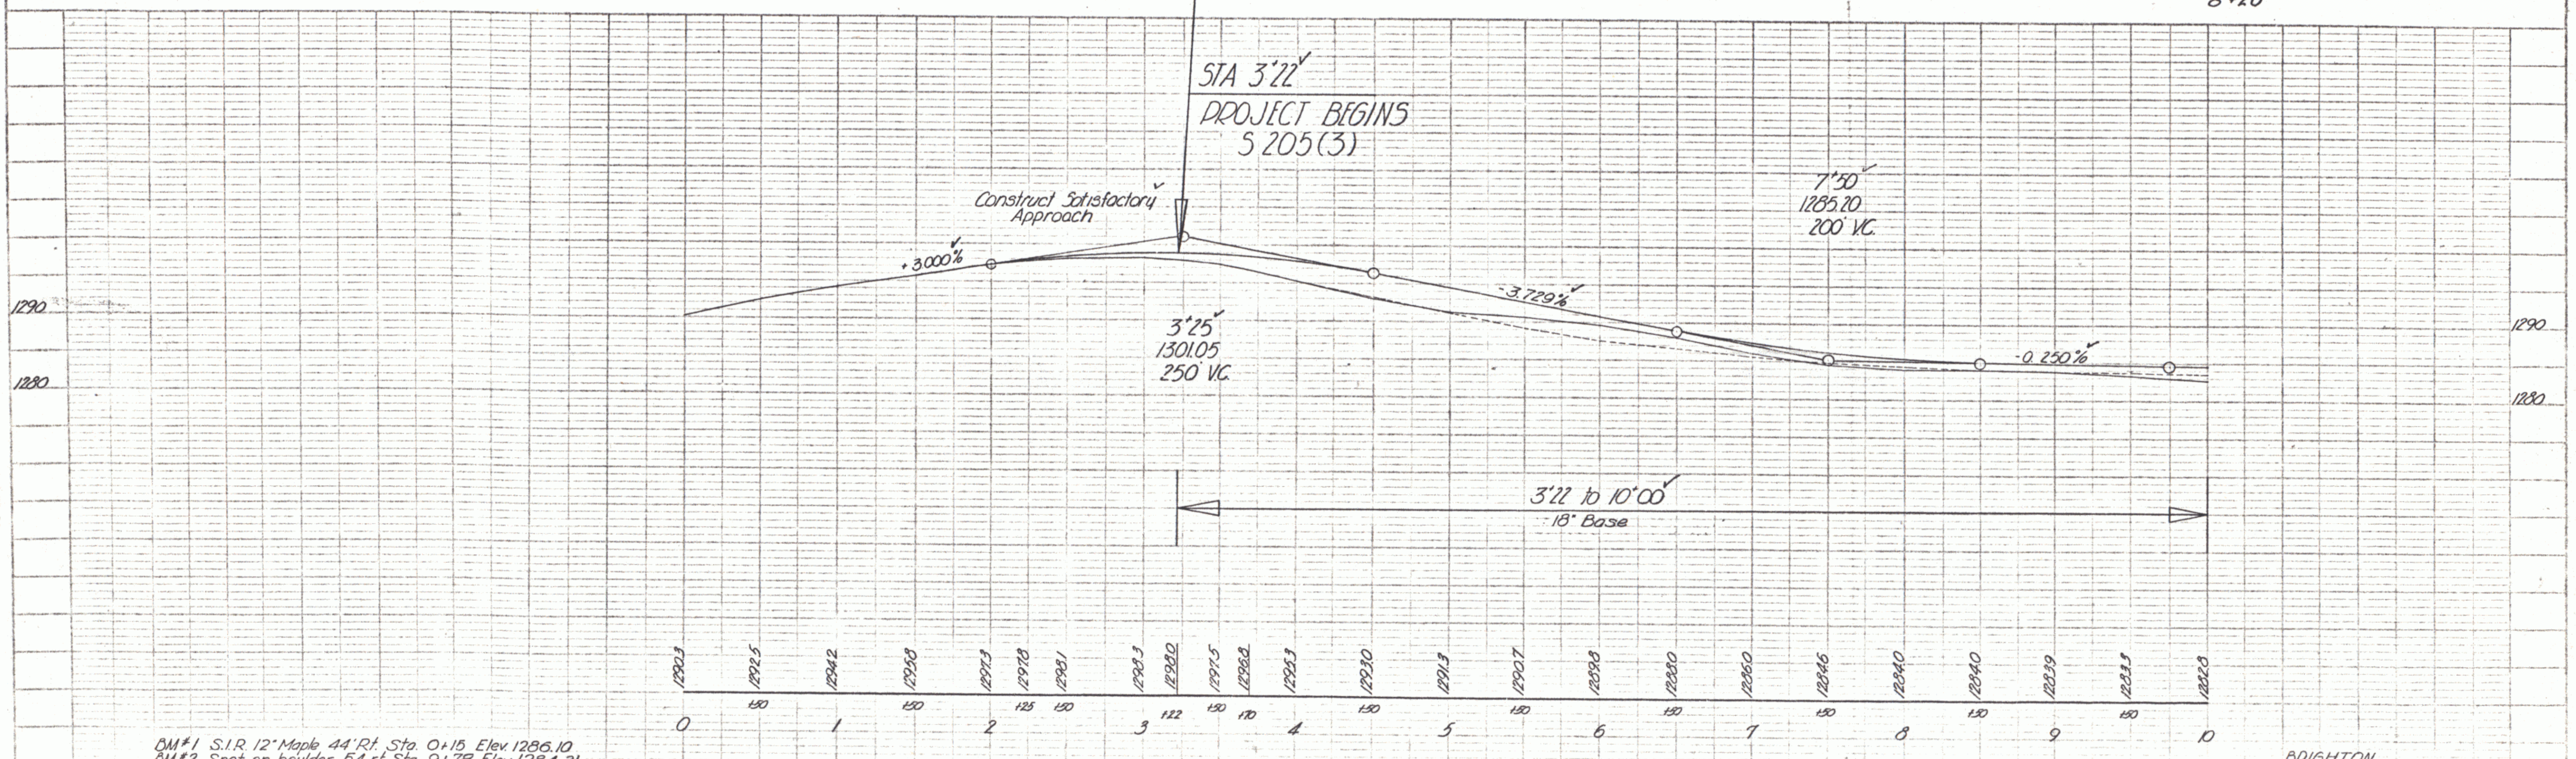

BM #1 S.I.R. 12" Maple 44' Rt. Sta. 0+15 Elev. 1286.10
BM #2 Spot on boulder 54 rt Sta 9+78 Elev. 1284.31

BRIGHTON
Series S No. 205(3)
Sheet ⑩ of 48 Sheets

PLATE 1 – PLAN-PROFILE B. P. R. & R. R. STANDARD
KEUFFEL & ESSER CO., NEW YORK
K & E Co. No. 341-1C

2