

PARCEL #3 41A42C
 INSTRUMENT W.D.O.E. W.D.O.E.
 DATE 8-10-49 8-10-49

GRANTOR HENRY F. GRANT HOWARD, SR. & ALICE STEVENS

GRANTEE 5% OF VT. 5% OF VT.

RECORDED BRIGHTON MORGAN
 BOOK 24 16
 PAGE 10-11 212
 DATE 8-23-49 2-6-50


REMARKS: #1 B ON SHEET 15
 #1 C SLOPE RIGHTS ON SHEET #16


Sta.	Elev.	Spac.	Lt.	Rt.
56+0	53+76	16	12	
SIDE LINE				
0+25	1+22	Variable	19	
0+72	1+04		5	

0+25-1+05
 Shaded area shown to have Double
 Tack Coat of Refined Tar, Item 312A
 For Details of Intersection
 See Sheet 36 of 76

FED. ROAD STATE DIST. NO. 270 FISCAL YEAR 1950 SHEET TOTAL 1576
 POST WAR SECONDARY

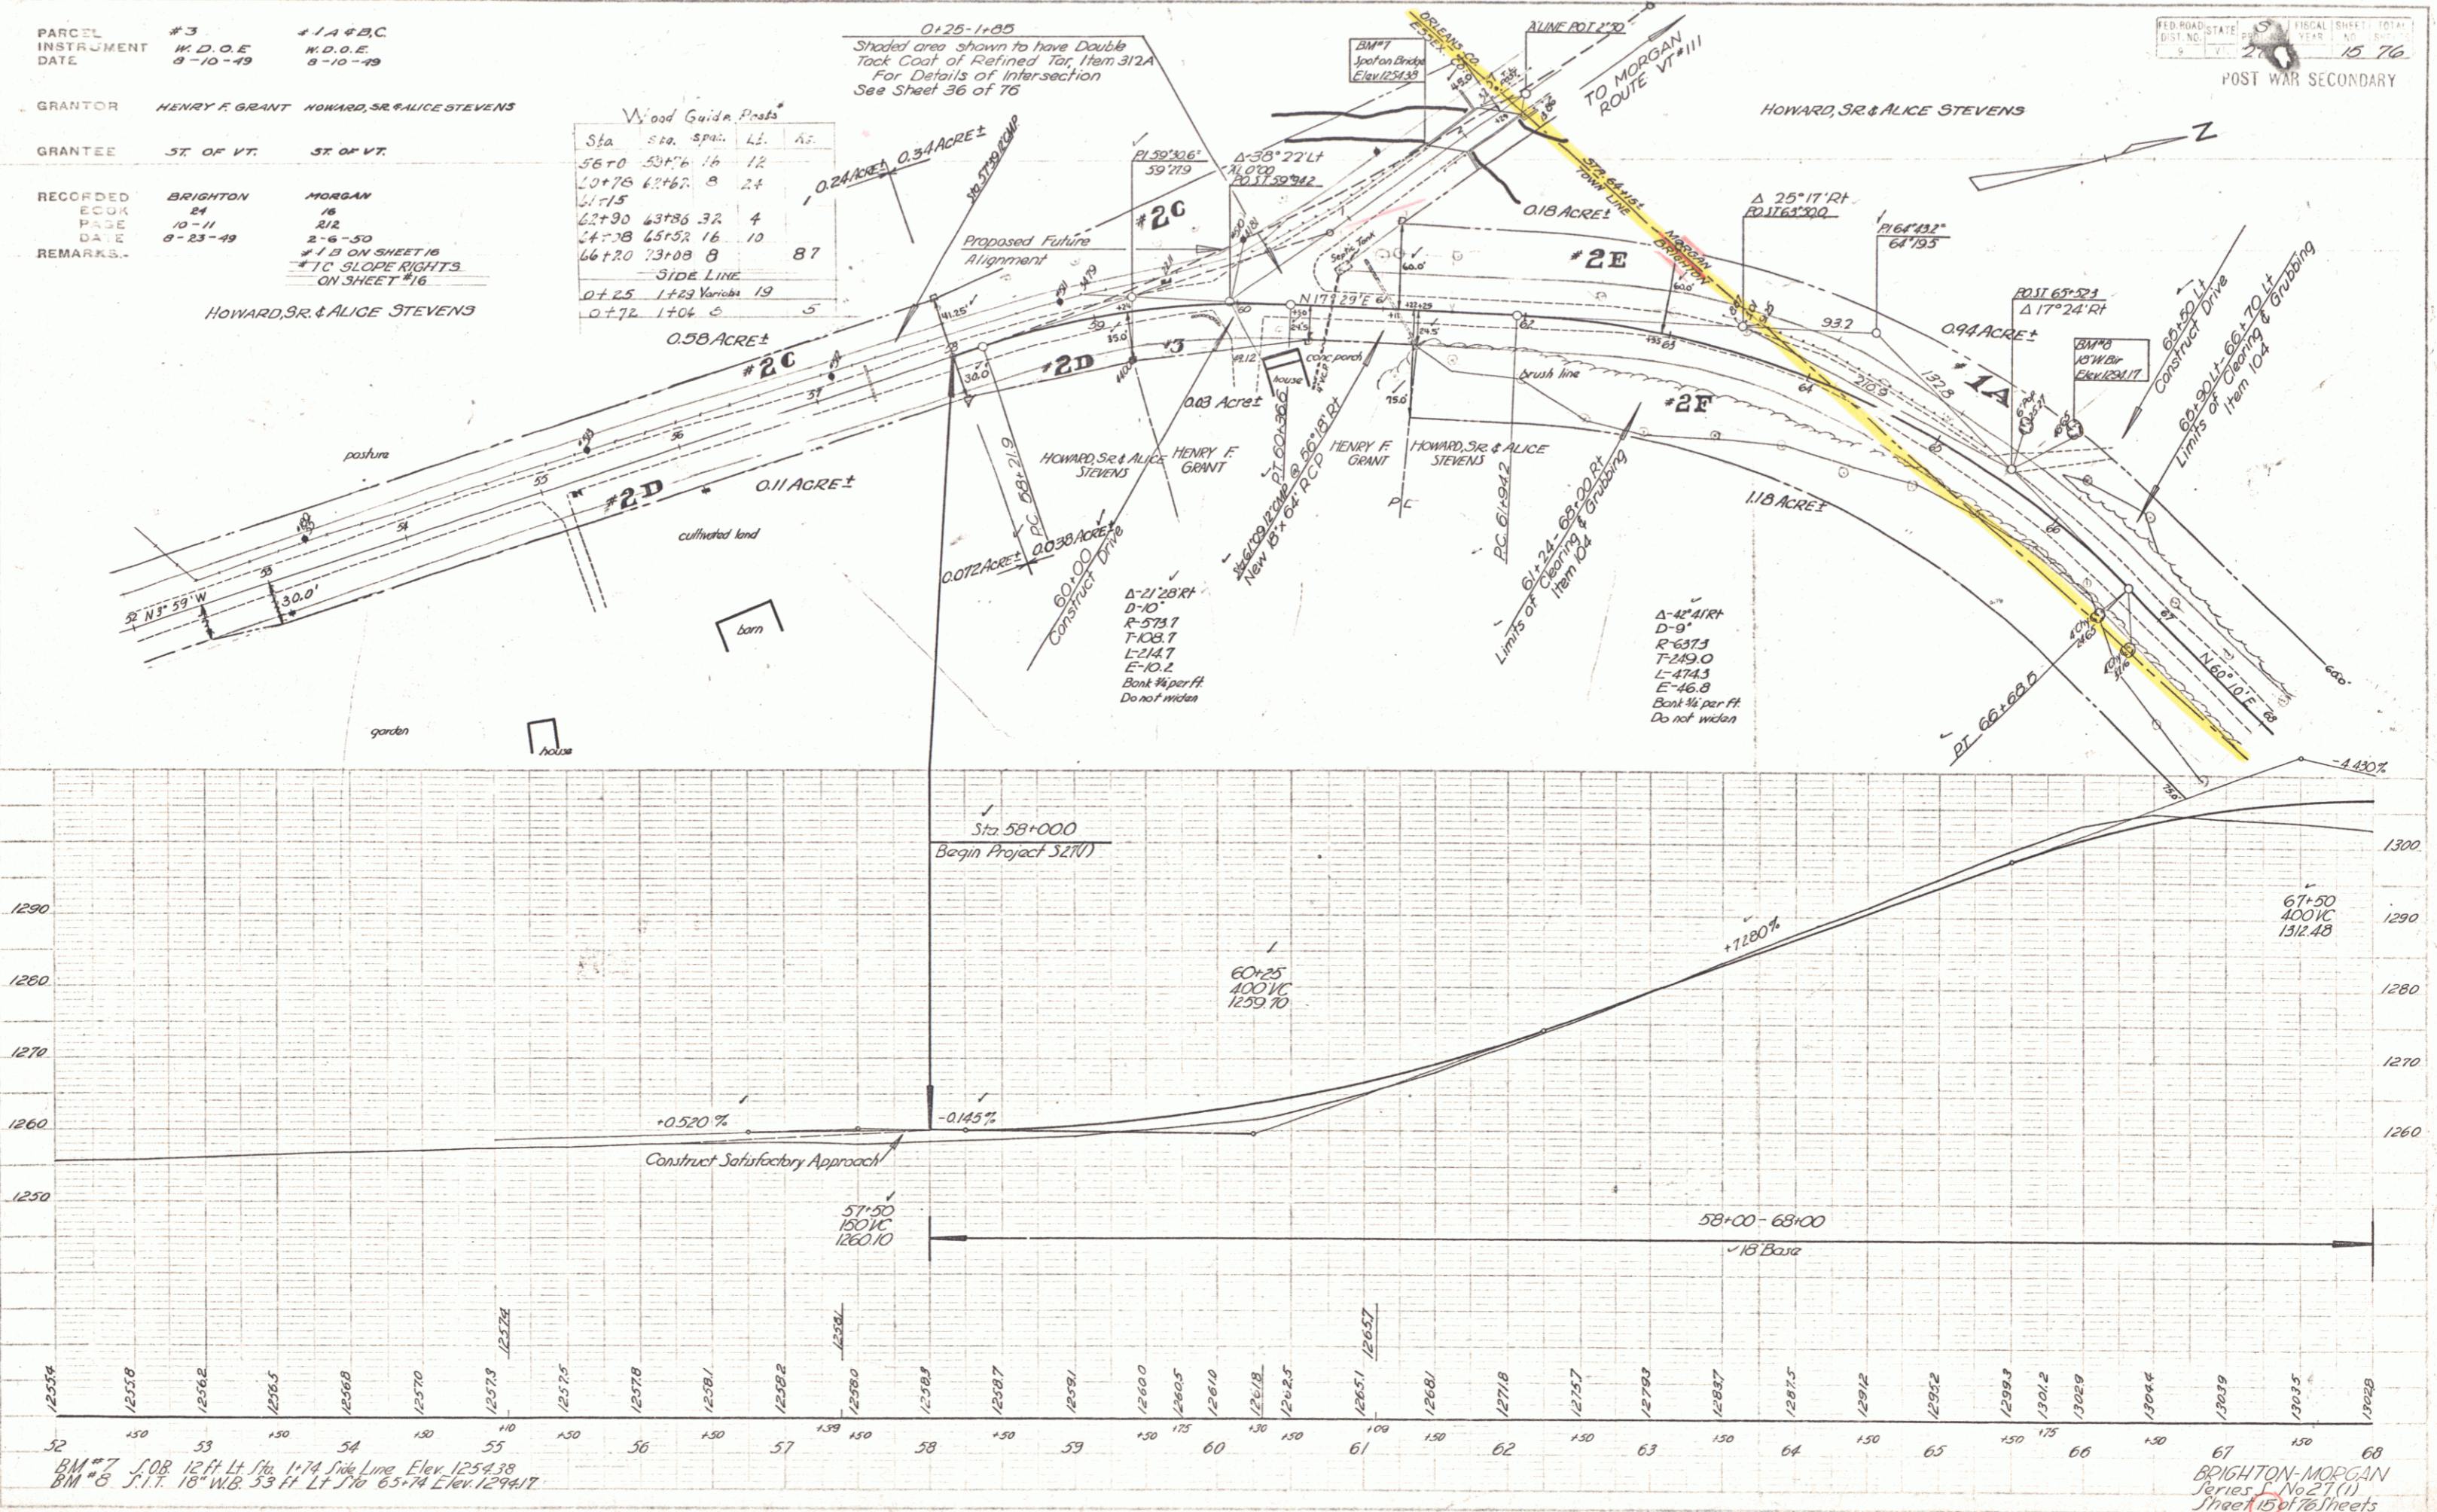

FILED
 DATE
 TIME
 BY
 TRACED
 N.L.T. Jr.

4-18
 4-19
 4-20
 4-21
 4-22

B.M. #7 I.O.B. 12 FT. LT. 176 1+74 Side Line Elev. 1254.38
 B.M. #6 J.I.T. 18" W.B. 33 FT. LT. 176 65+74 Elev. 1294.17

BRIGHTON-MORGAN
 Series No. 27(1)
 Sheet 15 of 76 Sheets