FED. ROAD DIST. NO.	STATE	PROJ. NO.	FISCAL YEAR	SHEET NO.	TOTAL SHEETS
3	VT.	2710		23	76

POST WAR SECONDARY

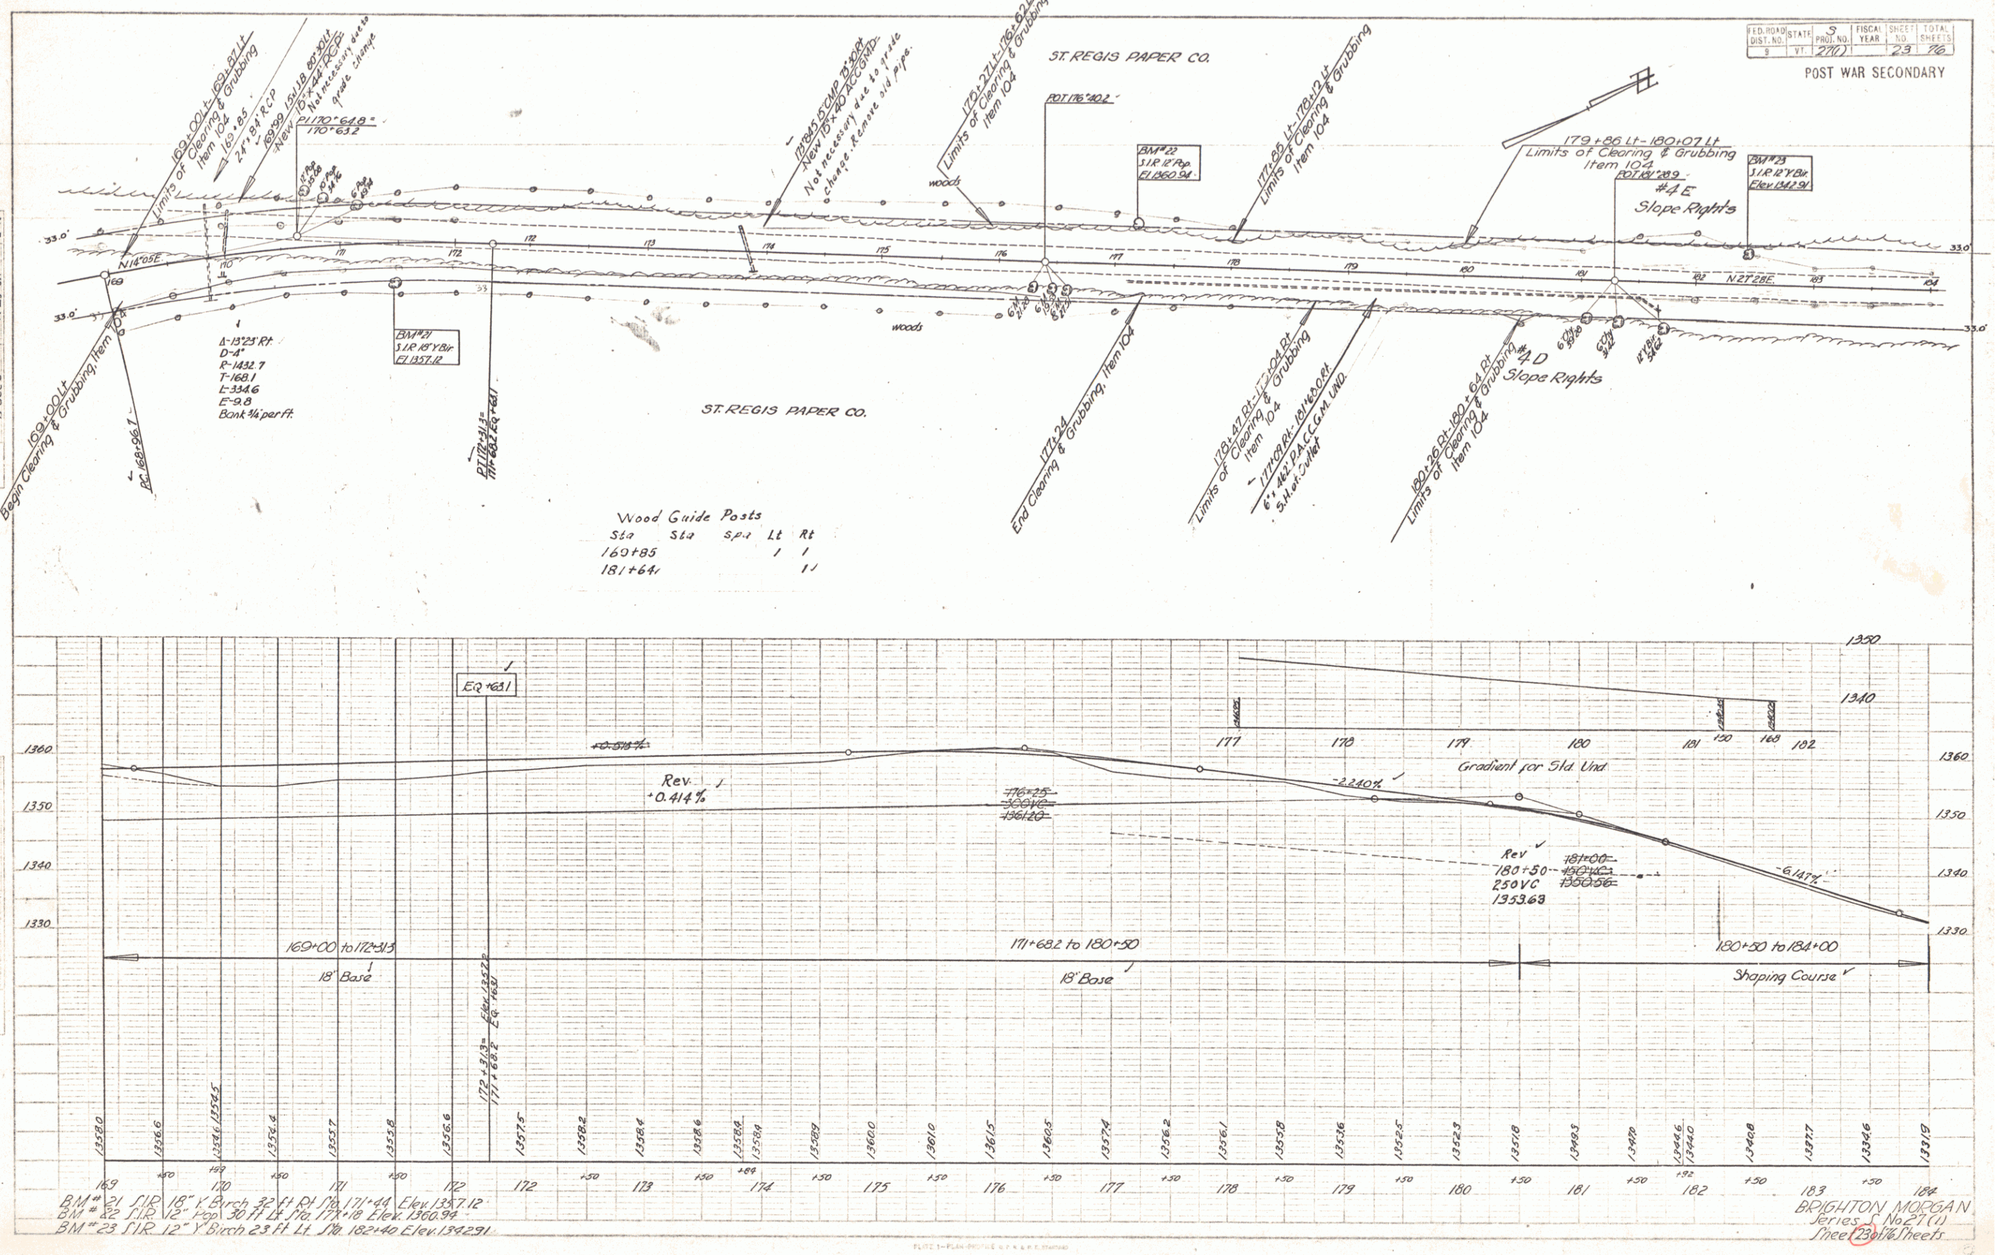

BM # 21 3 I.R. 18" K Birch 32 ft Rt Sta. 171+44 Elev. 1357.12
BM # 22 3 I.R. 12" Rop 30 ft Lt Sta. 177+18 Elev. 1360.94
BM # 23 3 I.R. 12" Y Birch 23 ft Lt Sta. 182+40 Elev. 1342.91

BRIGHTON MORGAN
Series C No. 27(1)
Sheet 23 of 76 Sheets

10