INDEX OF SHEETS

SHEET NO. 1 TITLE PAGE
" " 2 TYPICAL CROSS-SECTION OF IMPROVEMENT
" " 3 BANKING AND WIDENING TABLES
" " 4 PLAN AND PROFILE

ROAD T. NO.	STATE	FED. AID PROJ. NO.	FISCAL YEAR	SHEET NO.	TOTAL SHEETS
9	VT.				

STATE OF VERMONT
STATE HIGHWAY DEPARTMENT

PLAN AND PROFILE OF PROPOSED
STATE HIGHWAY

FEDERAL AID PROJECT

TOWNS OF ESSEX-JERICHO-RICHMOND

VT 117

Project # FAP 240A(1)
Pin # 00R488
Route VT117
Date 1/1/1941

RIGHT-OF-WAY DIVISION
TOWN FILE
PERPETUAL
Pte ~~Town~~ of VT 117
(To Be Returned To R.O.W. Division)

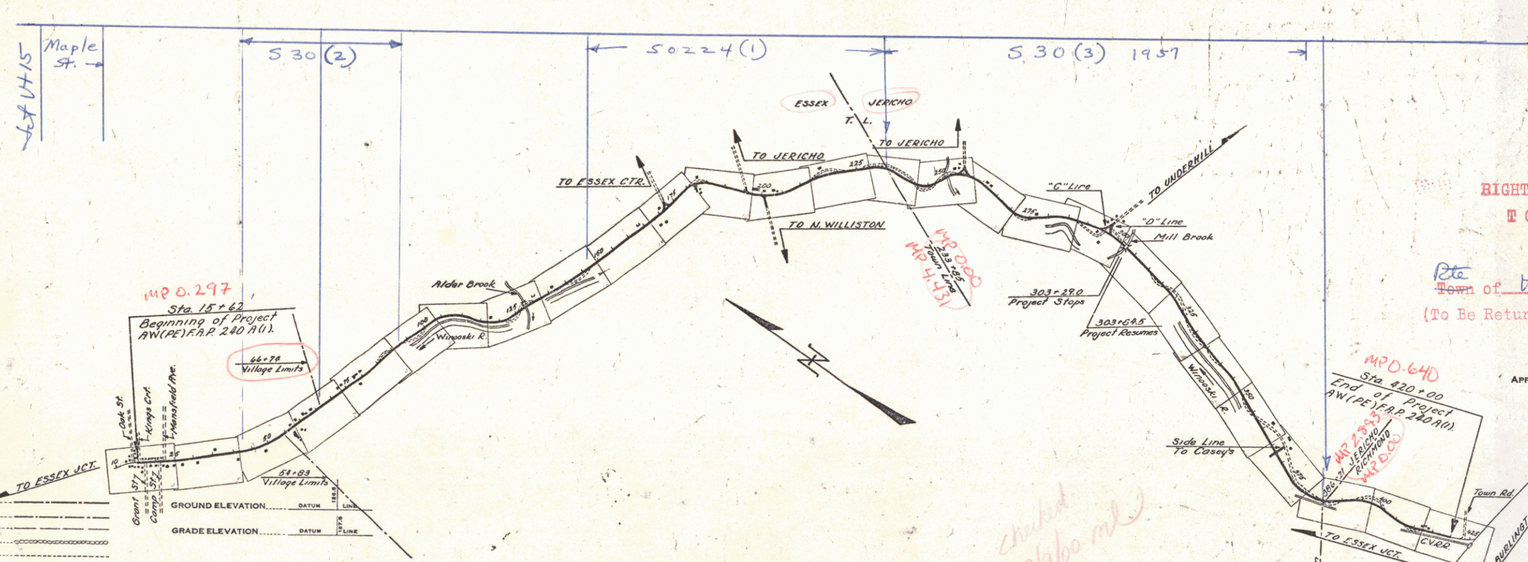

COUNTY LINE
TOWN LINE
FENCE LINE
STONE WALL
UNFENCED PROPERTY
GUARD RAIL
TRAVELED WAY
RAILROAD
CENTER LINE
SURVEY LINE
CULVERT
DROP INLET
POWER POLE
TELEPHONE POLE
TREES
HEDGE

CURVE DATA

DEFLECTION ANGLE ..... Δ
DEGREE OF CURVE ..... D.
RADIUS OF CURVE ..... R.
TANGENT DISTANCE ..... T.
LENGTH OF CURVE ..... L.
EXTERNAL DISTANCE ..... E.
POINT OF INTERSECTION ..... P. I.
POINT OF CURVE ..... P. C.
POINT OF TANGENT ..... P. T.
POINT ON TANGENT ..... P. O. T.

SCALES

TITLE
TYPICAL
PLAN
PROFILE HORIZONTAL
VERTICAL
CROSS SECTIONS

THESE PLANS ARE SUBJECT TO SUCH REVISIONS AS MAY BE REQUIRED BY THE PUBLIC ROADS ADMINISTRATION OR THE COMMISSIONER OF HIGHWAYS.

CONSTRUCTION IS TO BE CARRIED ON IN ACCORDANCE WITH THE PLANS AND THE STANDARD ROAD AND BRIDGE SPECIFICATIONS OF 1936, AS APPROVED DECEMBER 29TH, 1936 BY THE PUBLIC ROADS ADMINISTRATION, INCLUDING ALL SUBSEQUENT APPROVED REVISIONS AND SUCH REVISED SPECIFICATIONS AND SPECIAL PROVISIONS AS ARE SUBMITTED WITH THE PLANS.

APPROVED:
COMMISSIONER OF HIGHWAYS
SUBMITTED BY ORDER OF THE STATE HIGHWAY BOARD

RECOMMENDED FOR APPROVAL
DIVISION ENGINEER
PUBLIC ROADS ADMINISTRATION
FEDERAL WORKS AGENCY

APPROVED
CHIEF ENGINEER
PUBLIC ROADS ADMINISTRATION
FEDERAL WORKS AGENCY

APPROVED	APPROVED	SERIES F NO. 240A FILED
ROAD ENGINEER	DISTRICT HIGHWAY COMMISSIONER	SHEET 1 OF