| F.A.D. ROAD DIST. NO. | STATE | FED. AID PROJ. NO. | FISCAL YEAR | SHEET NO. | TOTAL SHEETS |
|---|---|---|---|---|---|
| 9 | VT. | | | | |

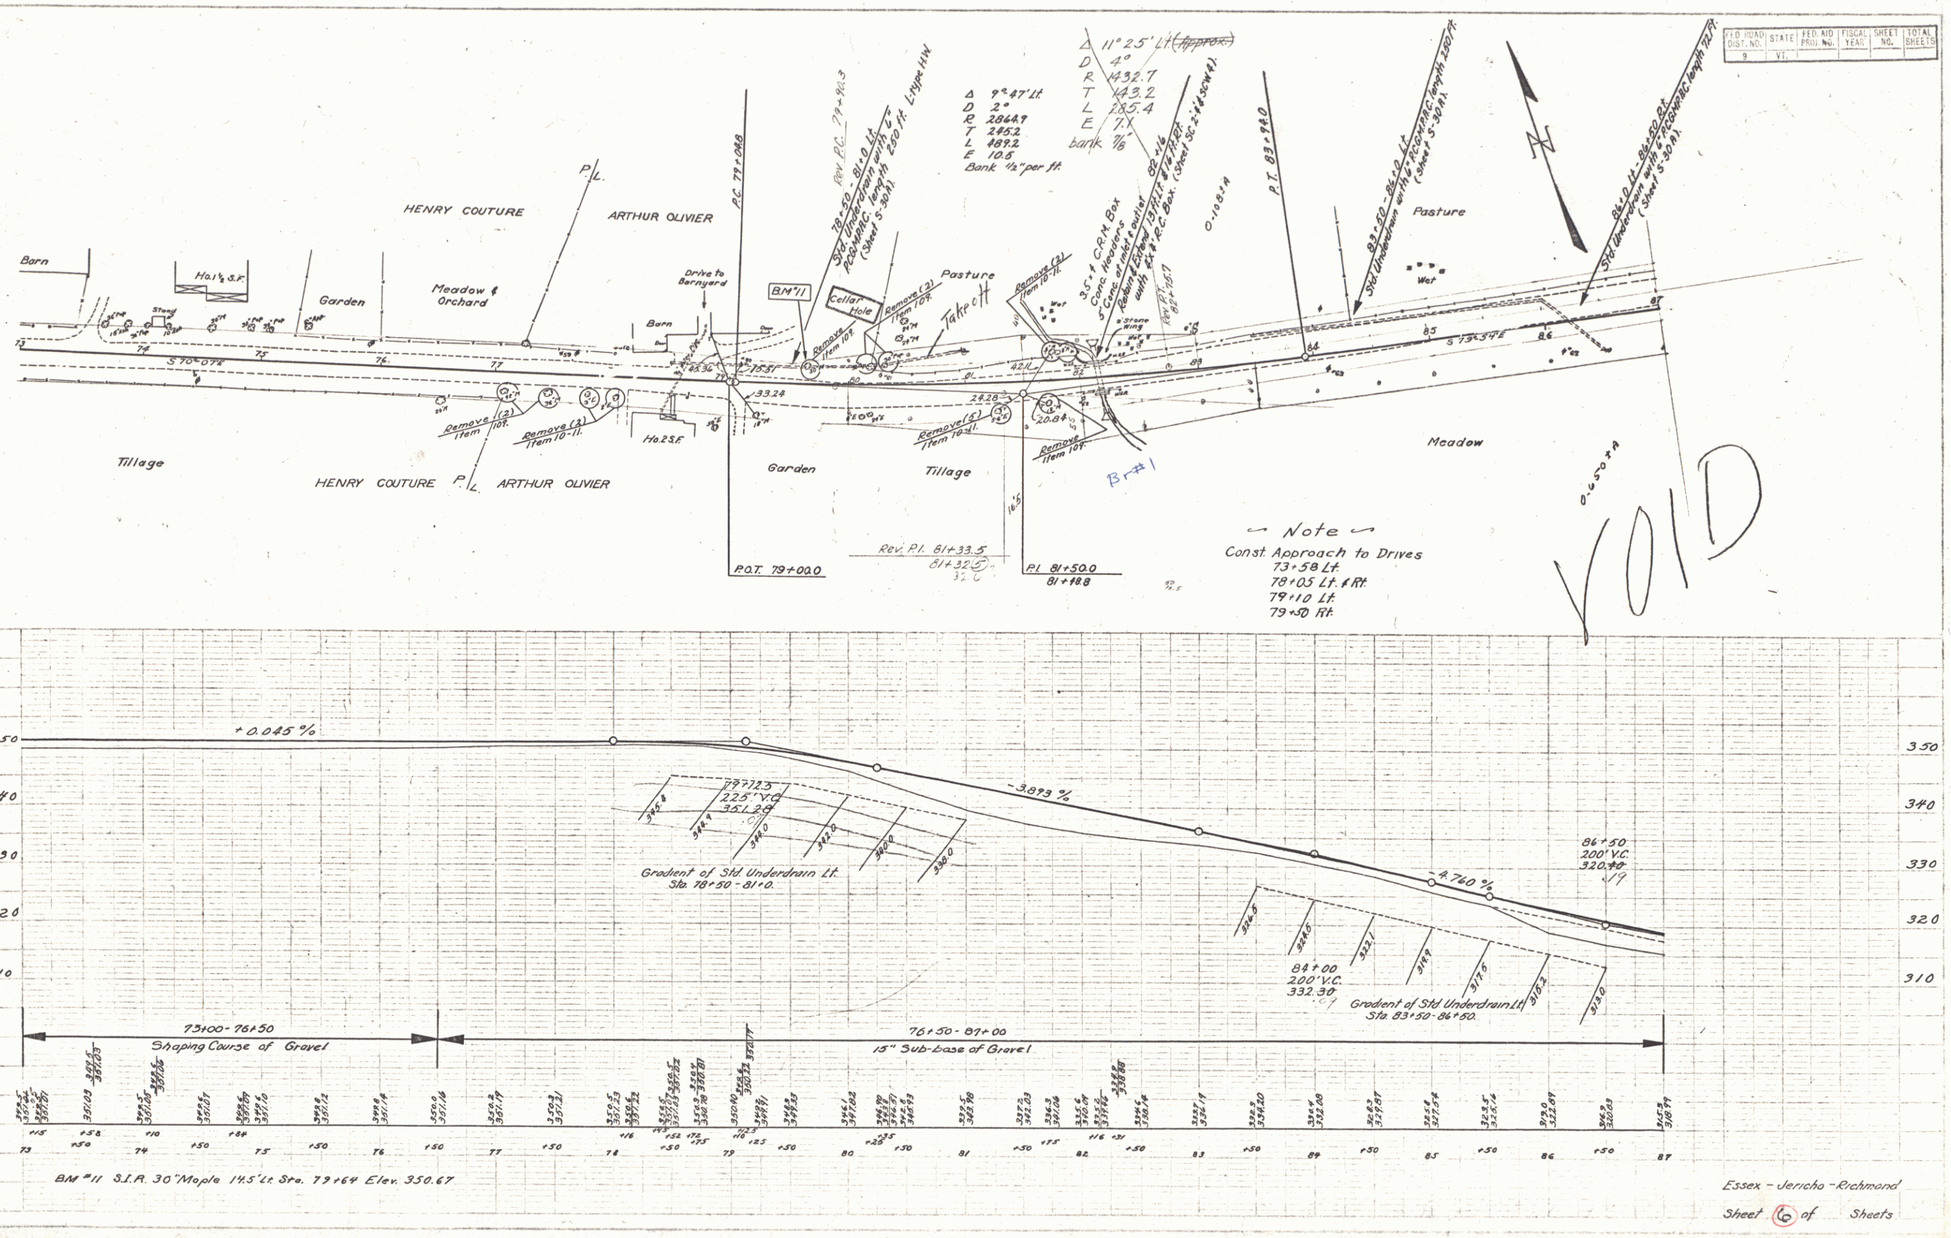


Essex - Jericho - Richmond

Sheet 6 of Sheets

6