FED. ROAD DIST. NO.	STATE	FED. AID PROJ. NO.	FISCAL YEAR	SHEET NO.	TOTAL SHEETS
3	VT.				

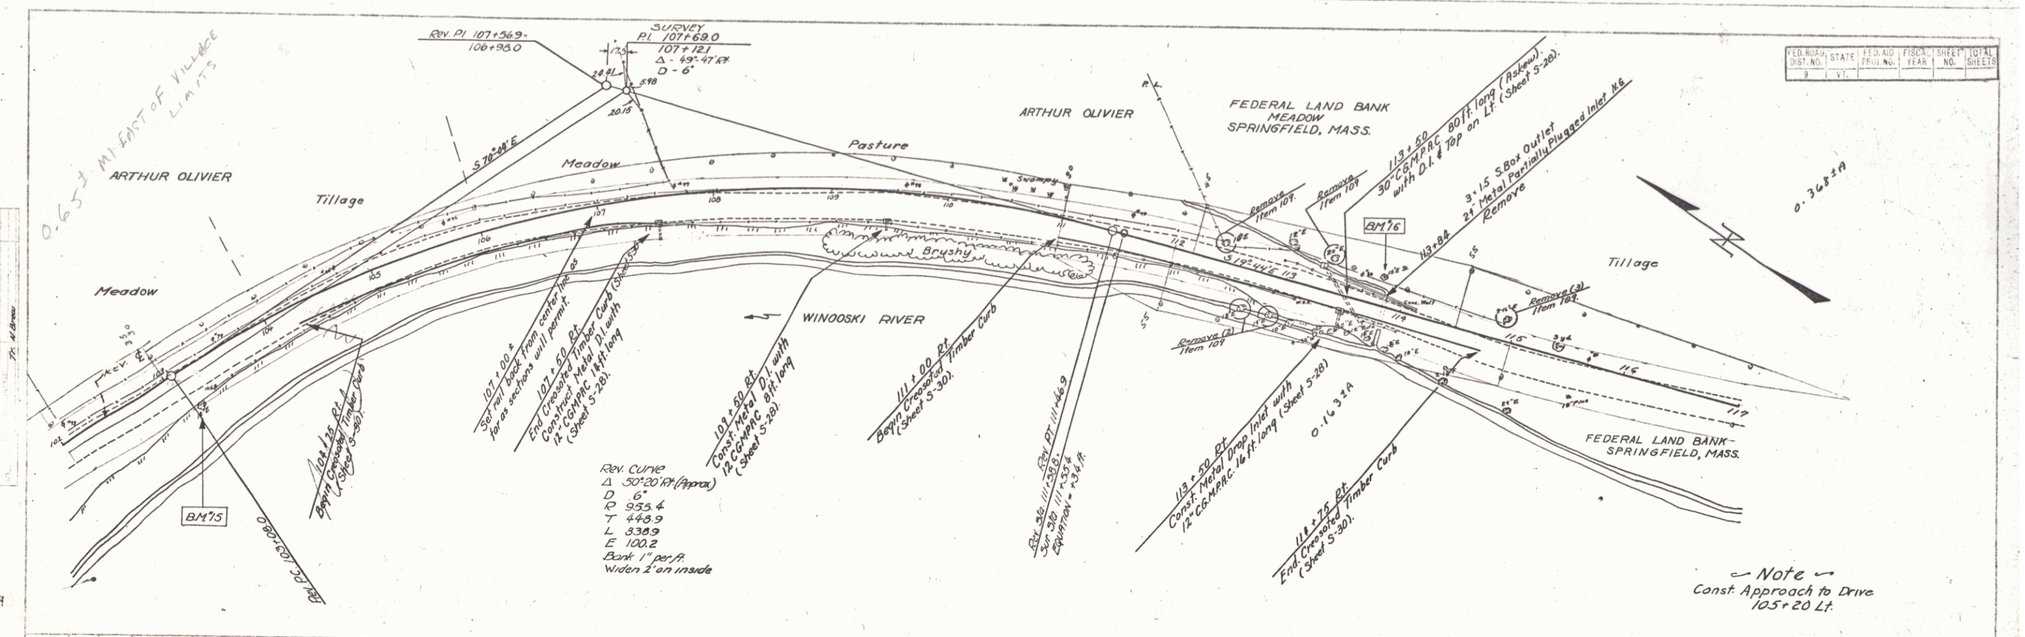

Essex - Jericho - Richmond

Sheet 7 of Sheets

7