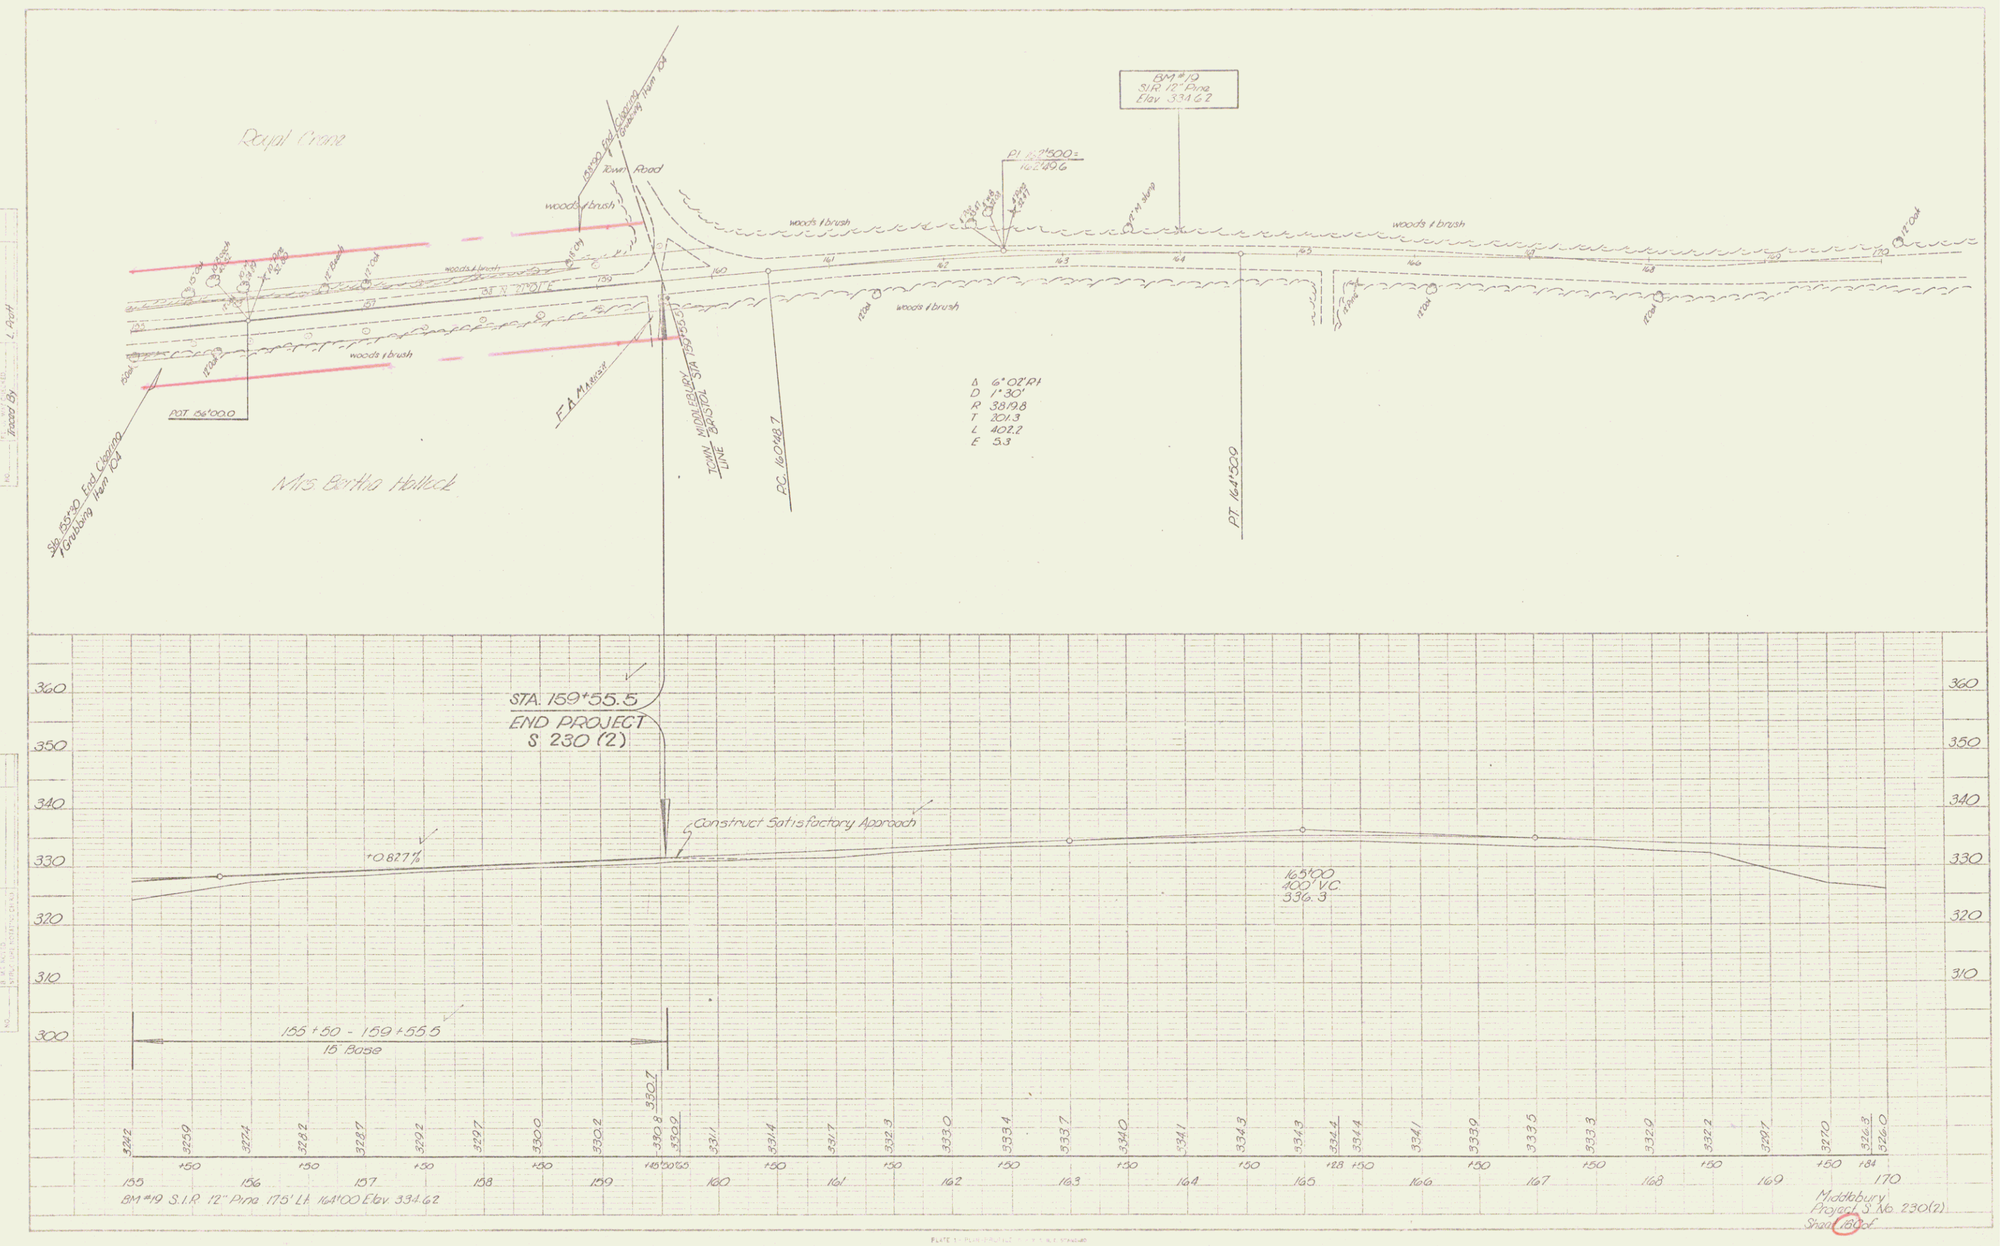
Rapt Crane
Mrs Bertha Hallock
Town Road
woods & brush
BM #19
S.I.R. 12" Pine
Elev. 334.62
PC 160+48.7
TOWN MIDDLEBURY
LINE
F.A. Marker
Grubbing Item 104
Sta. 159+00 Begin Clearing
Grubbing Item 104
POT 156+00.0
Δ 6°02'21
D 1°30'
R 3819.8
T 201.3
L 402.2
E 5.3
STA. 159+55.5
END PROJECT
S 230 (2)
Construct Satisfactory Approach
+0.827%
165+00
400' VC
336.3
155+50 - 159+55.5
15' Base
330.7
BM #19 S.I.R. 12" Pine 175' Lt. 164+00 Elev. 334.62
Middlebury
Project S. No. 230(2)
Sheet 18 of

10