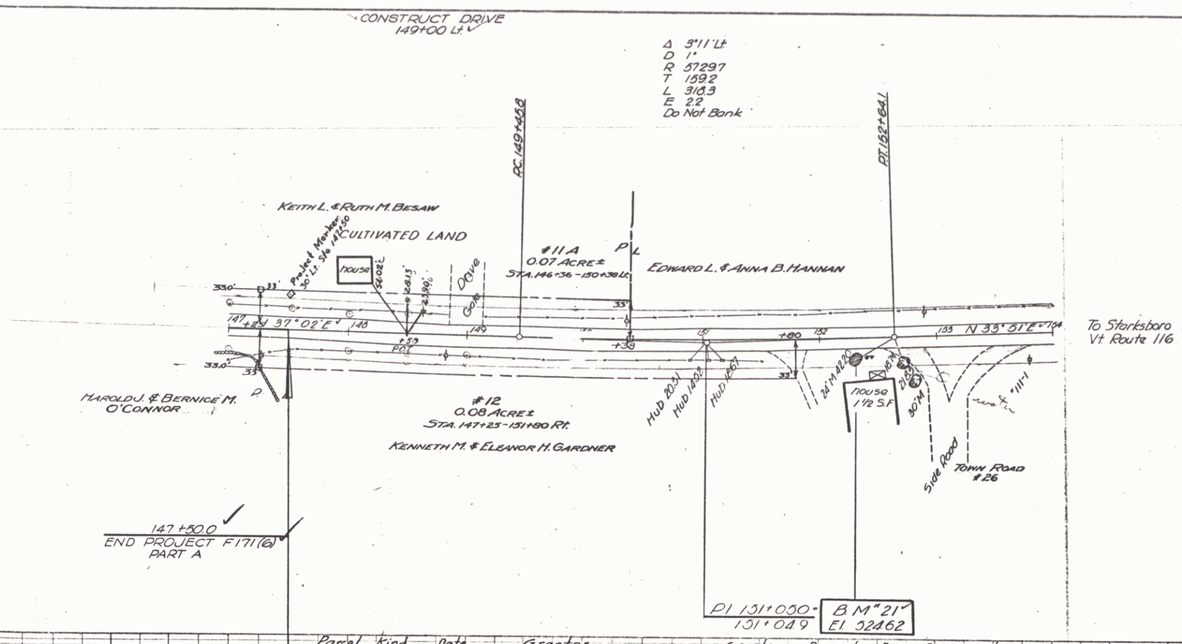

Parcel	Kind	Date	Grantor	Grantee	Record	Book	Page	Date	Remarks
#12	W.D.O.E.	3-10-54	Kenneth M. & Eleanor H. Gardner	St. of Vt.	Starksboro	22	497	3-30-54	

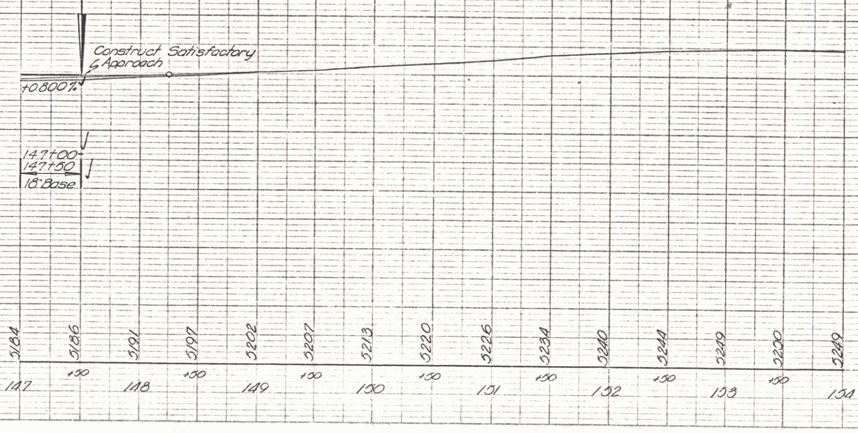

B.M. "21" 18.5' Ft. Rt. Sta. 152+25 S.I.P. 24" Maple El. 524.62

PART A
BRISTOL - STARKSBORO
Project F No. 171(6)
Sheet 20 of 110

12