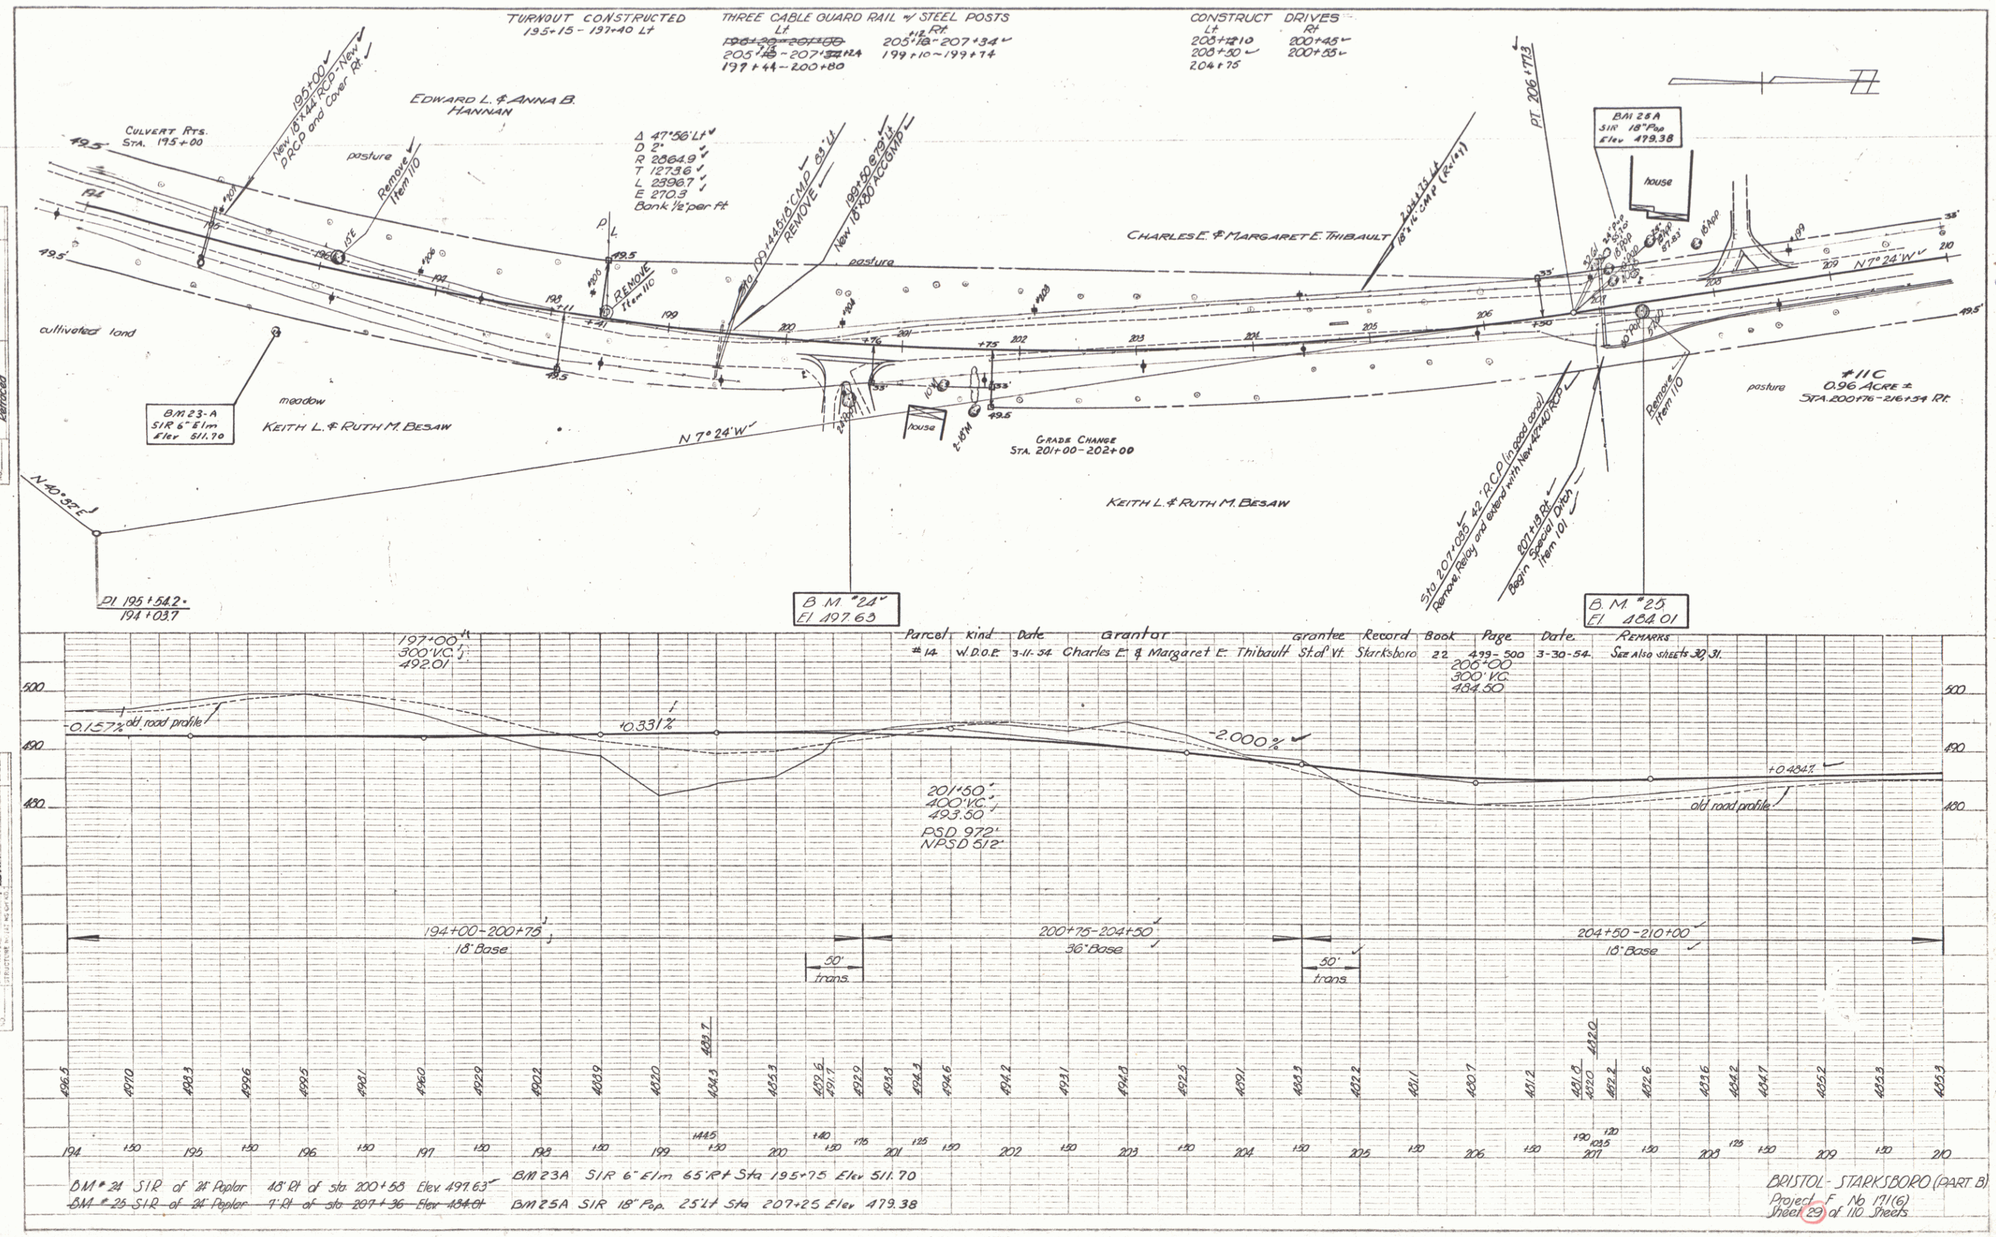

Parcel	Kind	Date	Grantor	Grantee	Record Book	Page	Date	Remarks
#14	W.D.O.E.	3-11-54	Charles E. & Margaret E. Thibault	St. of Vt.	Starksboro 22	439-500	3-30-54	See Also sheets 30, 31.

BM #24 SIR of 24" Poplar 48' Rt of sta 200+58 Elev 497.63

~~BM #25 SIR of 24" Poplar 7' Rt of sta 207+36 Elev 484.01~~

BM 23A SIR 6" Elm 65' Rt Sta 195+75 Elev 511.70

BM 25A SIR 18" Pop. 25' Lt Sta 207+25 Elev 479.38

BRISTOL - STARKSBORO (PART B)
Project F No 191(6)
Sheet 29 of 110 Sheets

PLATE 1 - PLAN-PROFILE O.P.R.&.R.E. STANDARD
PRINTED BY ALBERT & LEDER CO., NEW YORK
P.&E. CO. NO. 3A6-1 1-1-52

15