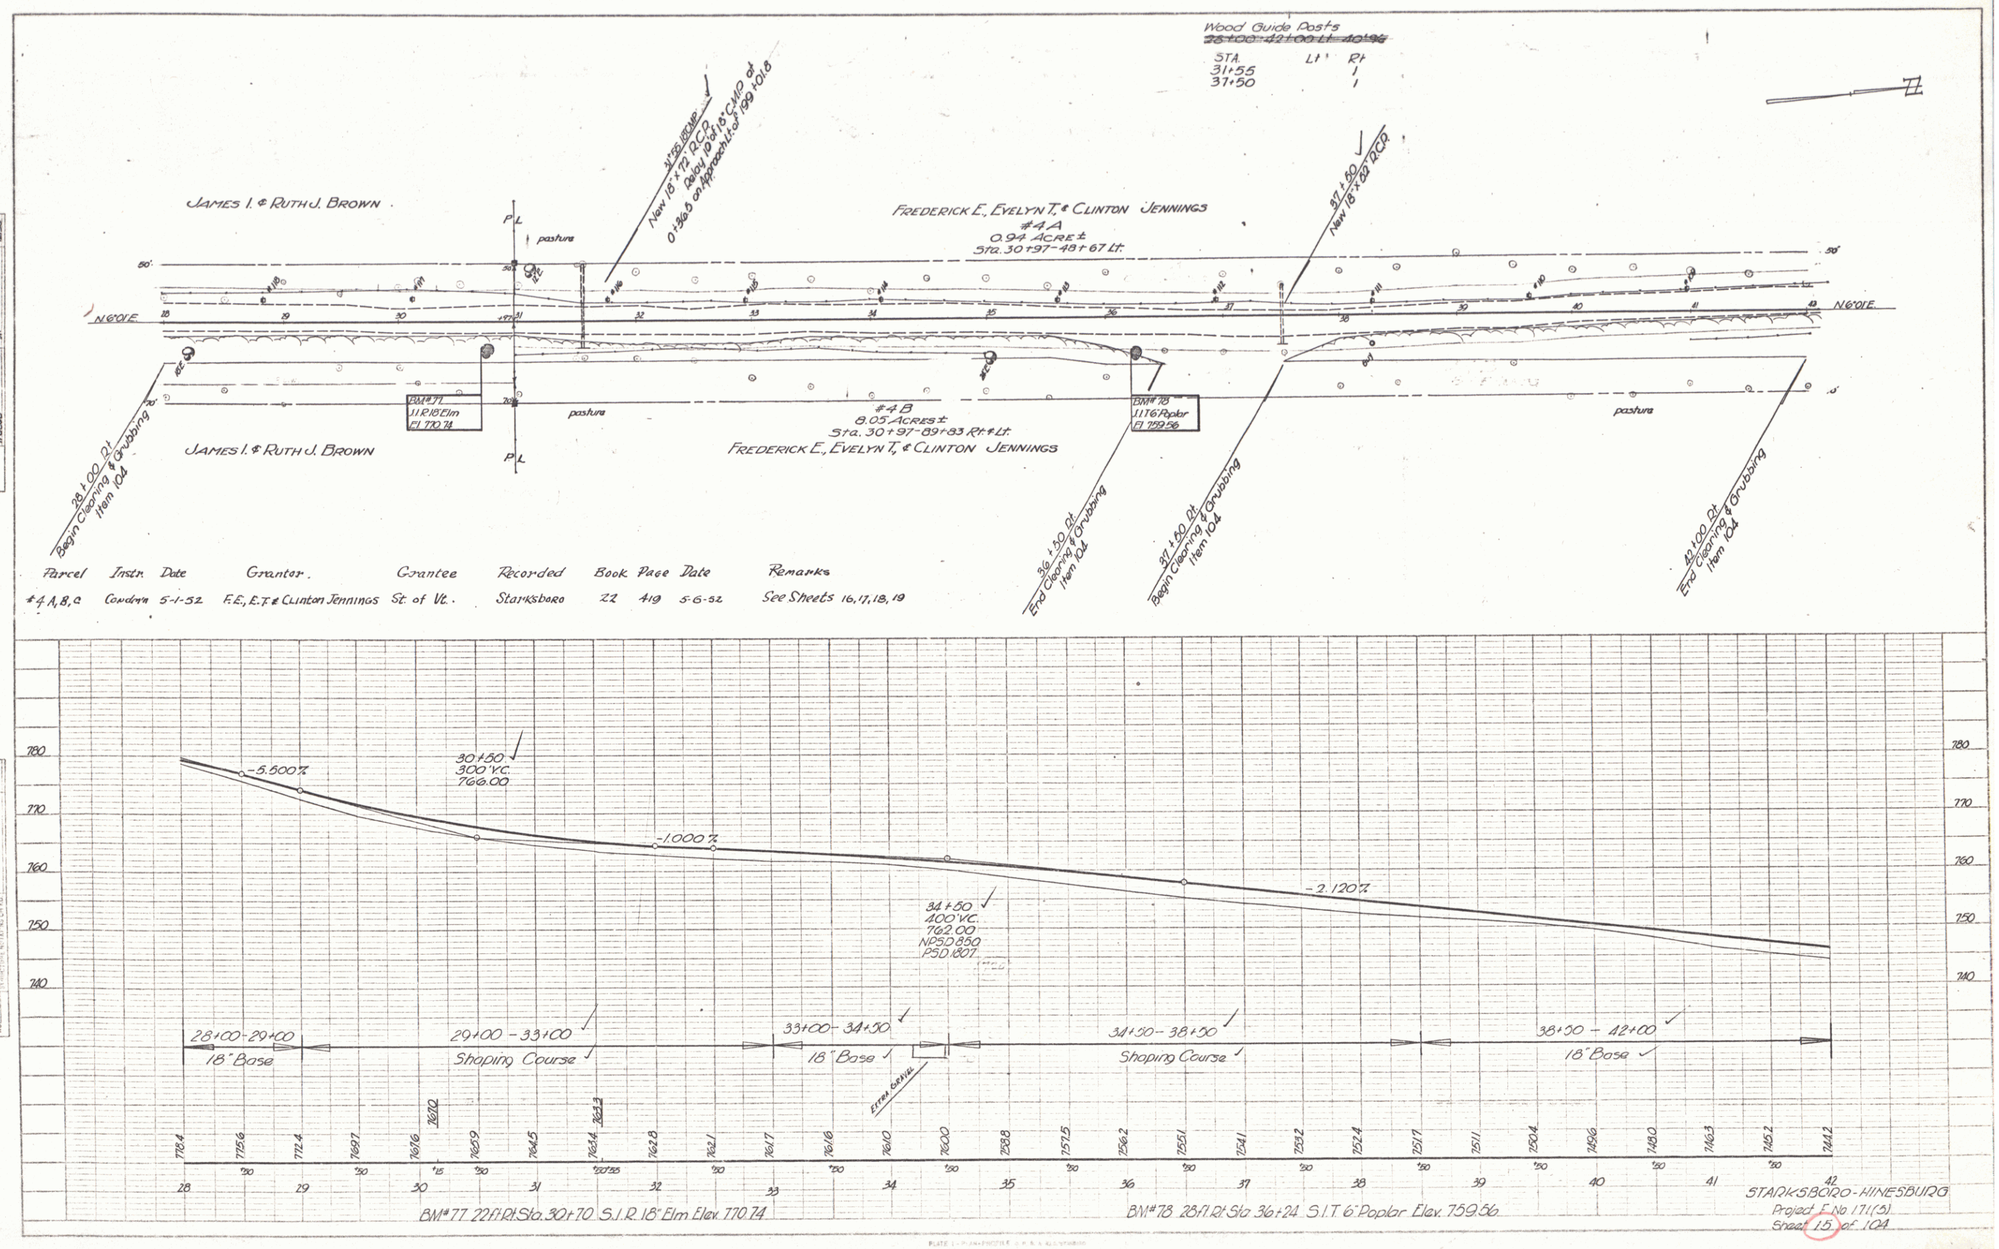

Parcel	Instr.	Date	Grantor	Grantee	Recorded	Book	Page	Date	Remarks
#4 A, B, C	Condem	5-1-52	F.E., E.T. & Clinton Jennings	St. of Vt.	Starksboro	22	419	5-6-52	See Sheets 16, 17, 18, 19

STARKSBORO - HINESBURG
Project F No 171(5)
Sheet 15 of 104

PLAN	
PRINTED	
PLOTTED	
NOTE BOOK	
ELEVATION CHECKED	
NO.	CHECKED

PROFILE	
PRINTED	
NOTE BOOK	
ELEVATIONS CHECKED	
NO.	