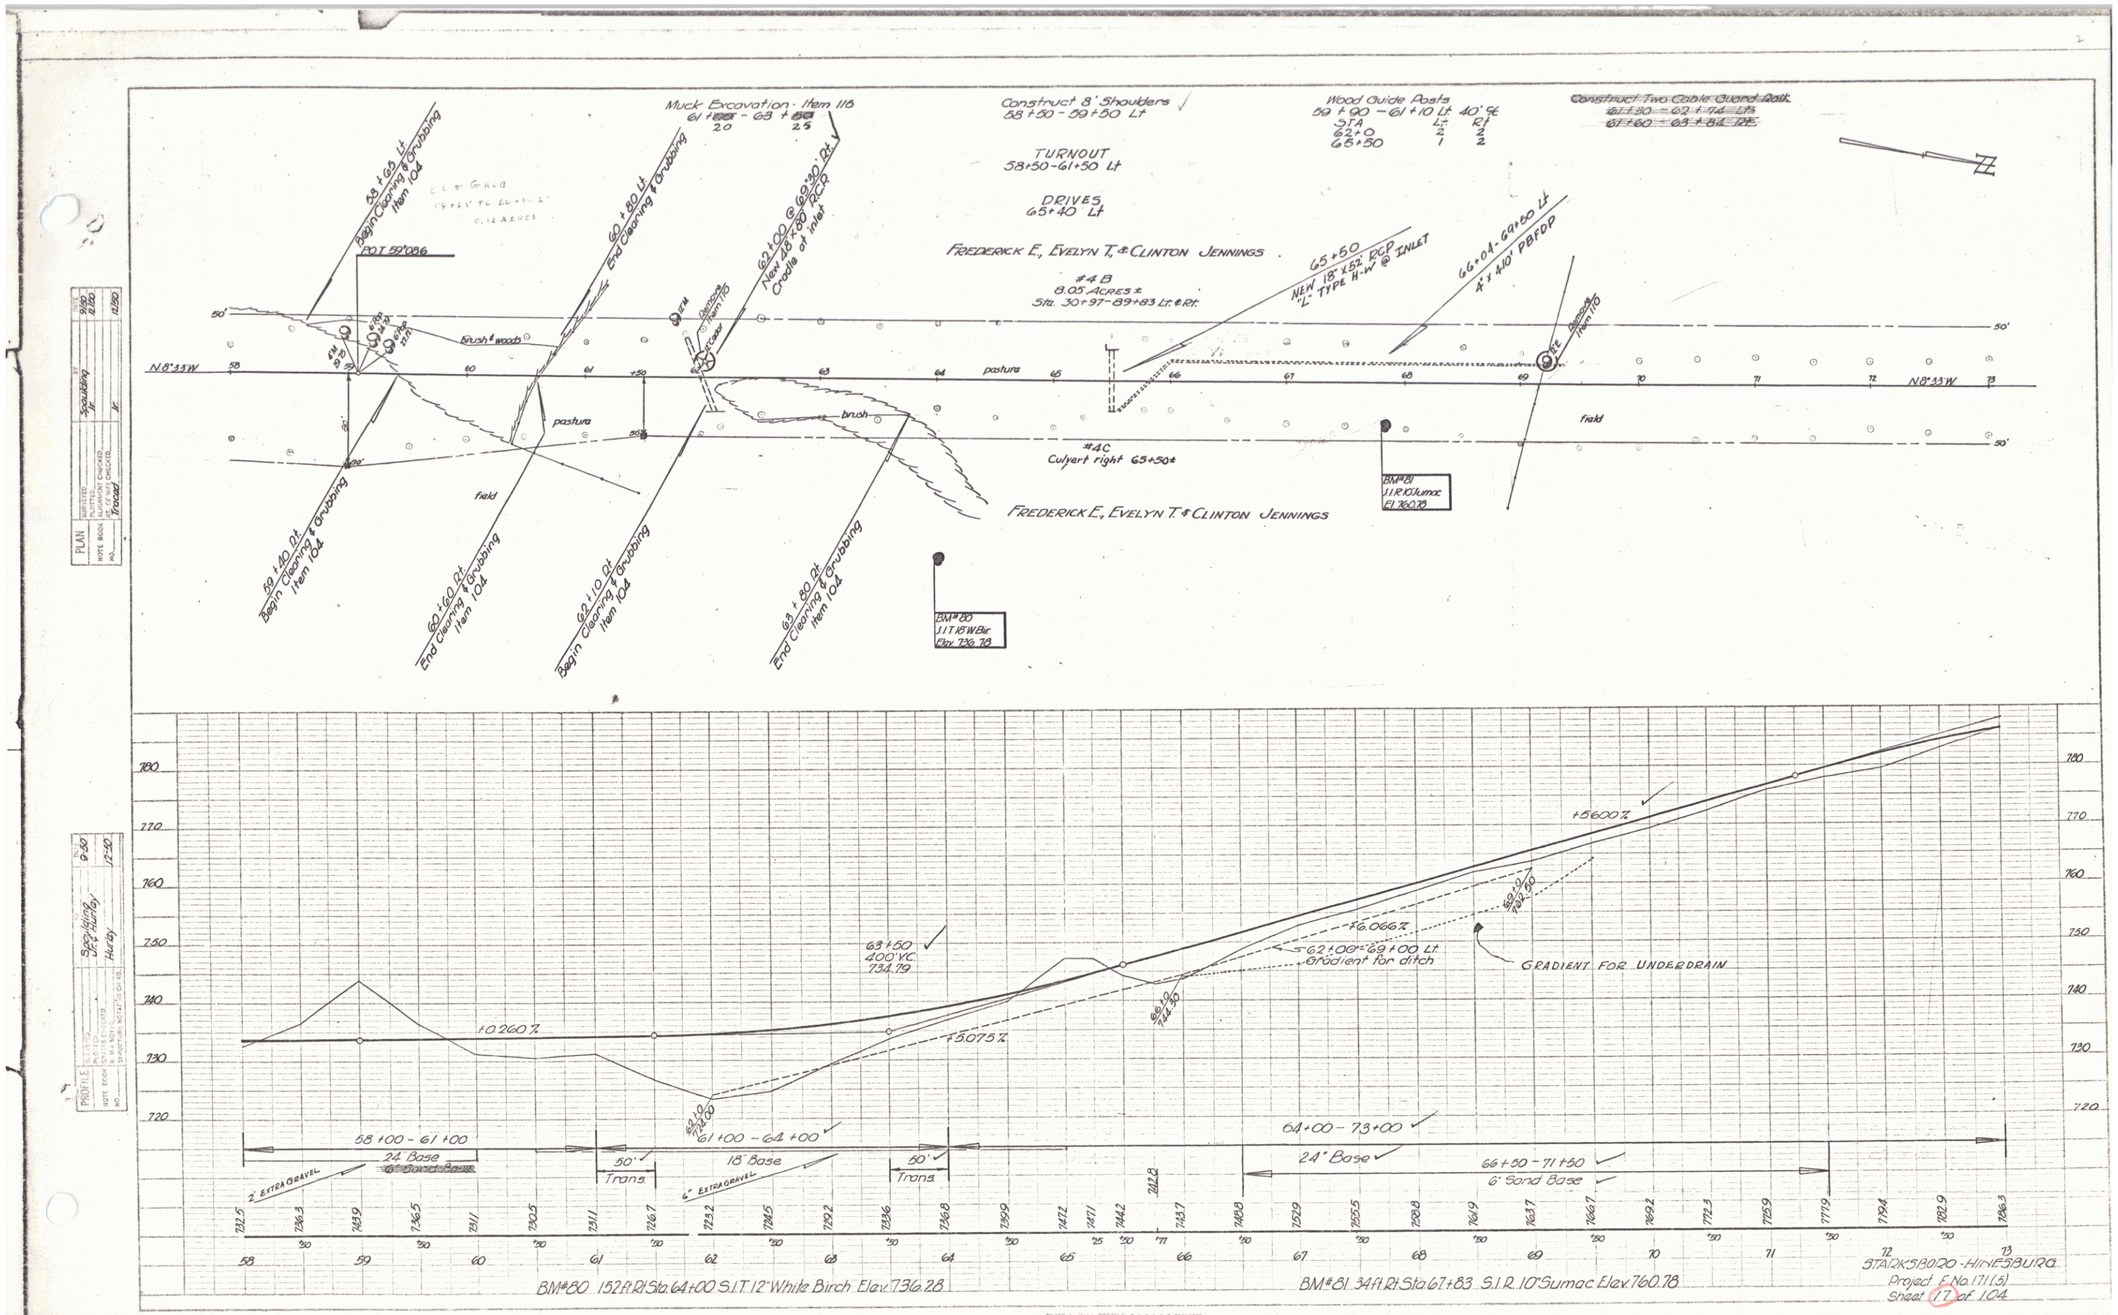
Muck Excavation - Item 116
61+00 - 63+00
20 25
Construct 8' Shoulders
58+50 - 59+50 Lt
Wood Guide Posts
59+90 - 61+10 Lt 40' Sp
STA Lt Rt
62+0 2 2
65+50 1 2
Construct Two Cable Guard Rail
61+30 - 62+74 Lt
61+60 - 63+84 Rt
TURNOUT
58+50 - 61+50 Lt
DRIVES
65+40 Lt
FREDERICK E, EVELYN T. & CLINTON JENNINGS
#4B
8.05 ACRES ±
Sta. 30+97 - 89+83 Lt. & Rt.
58+63 Lt
Begin Cleaning & Grubbing
Item 104
60+80 Lt
End Cleaning & Grubbing
62+00 @ 62+30 Rt
New 18" x 80' RCP
Cradle at Inlet
65+50
NEW 18" x 52' RCP
"L" TYPE H.W. @ INLET
66+04 - 66+50 Lt
4' x 40' PBFDP
P.O.T. 59'006
brush & woods
pastura
field
brush
#4C
Culvert right 65+50 ±
BM#81
S.I.R. 10" Sumac
El. 760.78
BM#80
S.I.T. 18" W. Bir
Elev. 736.28
59+40 Rt
Begin Cleaning & Grubbing
Item 104
60+60 Rt
End Cleaning & Grubbing
Item 104
60+10 Rt
Begin Cleaning & Grubbing
Item 104
63+80 Rt
End Cleaning & Grubbing
Item 104
N 8°33' W
50'
PLAN
Scribing
Hurley
Traced
9/30
8/30
1/30

+5600%
+6.066%
+5075%
+0.260%
63+50
400' V.C.
734.79
62+00 = 69+00 Lt
Gradient for ditch
GRADIENT FOR UNDERDRAIN
58+00 - 61+00
24" Base
6" Sand Base
2" EXTRA GRAVEL
50'
Trans
61+00 - 64+00
18" Base
6" EXTRA GRAVEL
64+00 - 73+00
24" Base
66+50 - 71+50
6" Sand Base
BM#80 152 ft. Rt. Sta. 64+00 S.I.T. 12" White Birch Elev. 736.28
BM#81 34 ft. Rt. Sta. 67+83 S.I.R. 10" Sumac Elev. 760.78
STARKSBORO - HINESBURG
Project F. No. 171 (5)
Sheet 17 of 104
PROFILE
Scribing
Hurley
9/30
1/30