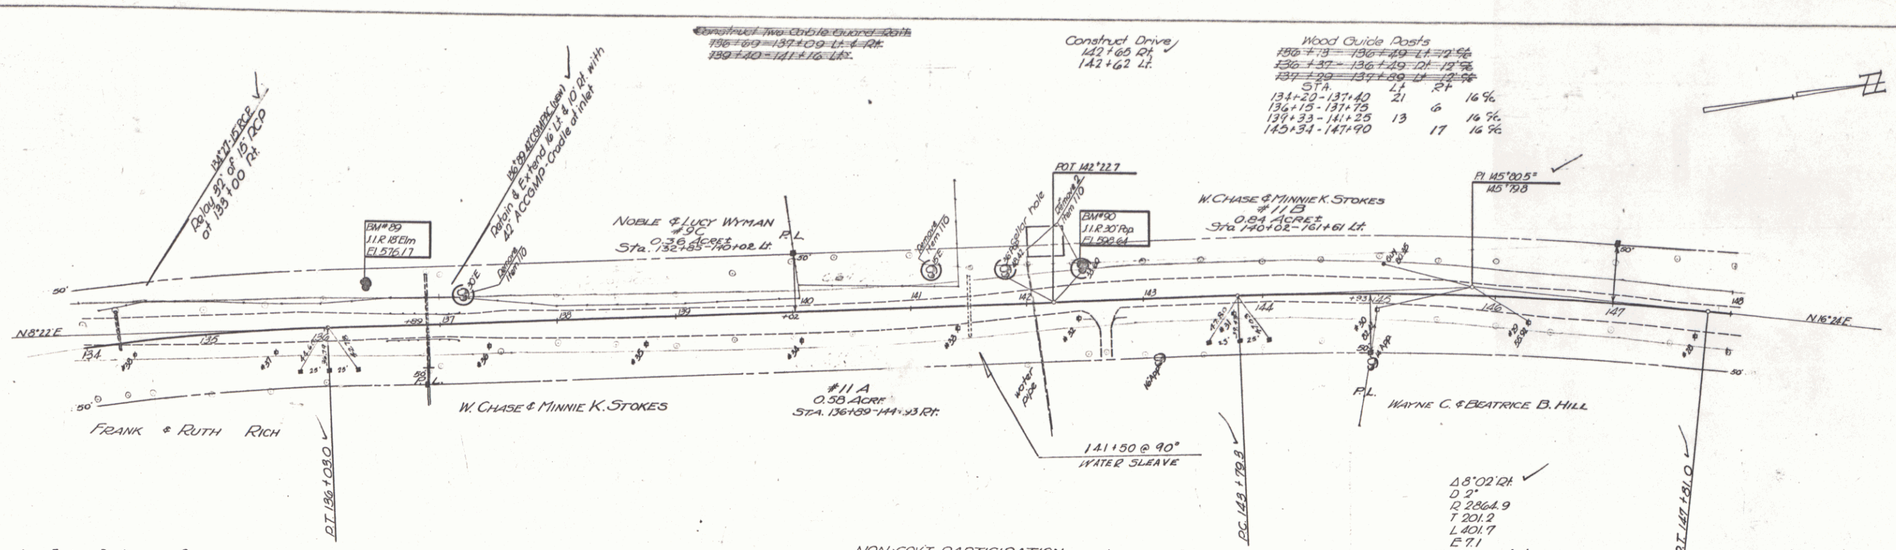

Parcel	Instr.	Date	Grantor	Grantee	Recorded	Book	Page	Date	Remarks
#11A,B.	W.D.O.E.	6-16-52	W. Chase & M. K. Stokes	St. of Vt.	Starksboro	22	446	6-20-52	See Sheet 23

NON-GOV'T. PARTICIPATION
Sta 142+05 Install sleeve for water pipe across roadway, Item 108. Non. Gov't.
Sleeve to be furnished by property owner.

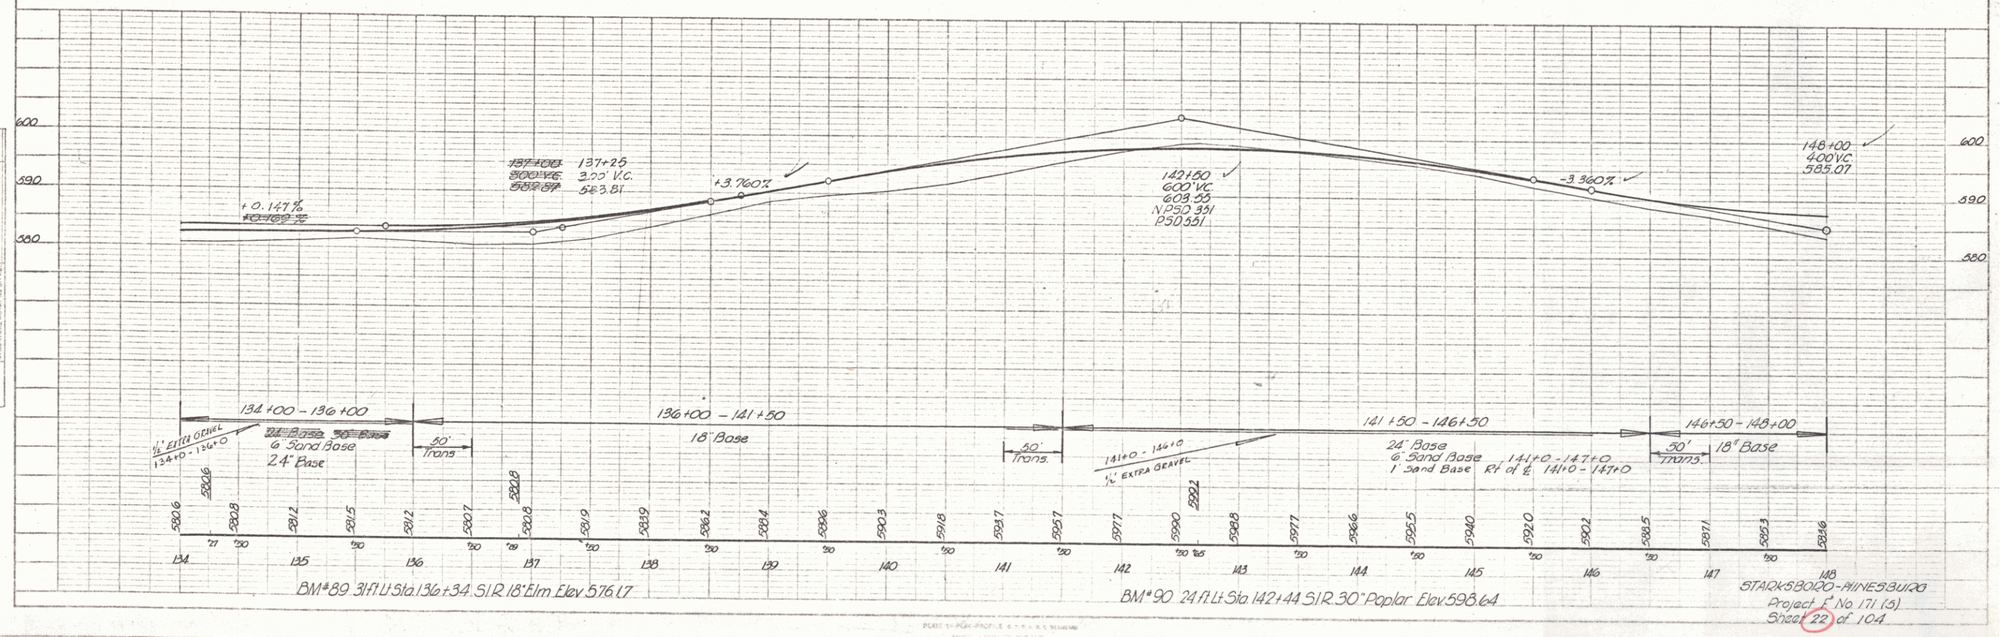

STARKSBORO-HINESBURG
Project F No. 171 (5)
Sheet 22 of 104

12