FED. ROAD DIST. NO. 1 | STATE VERMONT | PROJECT F 171(3) | FISCAL YEAR 1968 | PART II | SHEET NO. 5
POST WAR F.A. PRIMARY

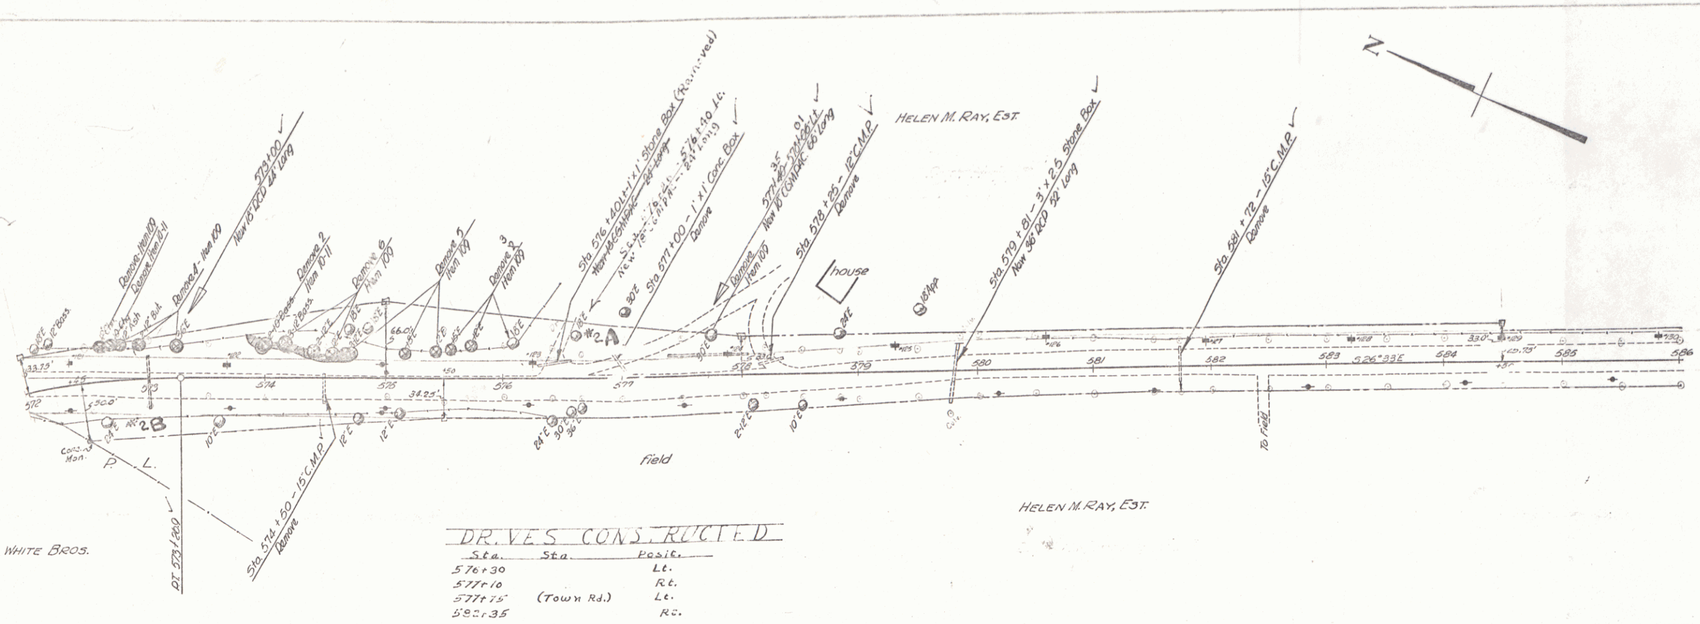

DRIVES CONSTRUCTED

Sta.	Sta.	Posit.
576+30		Lt.
577+10		Rt.
577+75	(Town Rd.)	Lt.
582+35		Rt.

PARCEL #2ABCD
INSTRUMENT Admin. Deed
DATE 8-18-50

GRANTOR Helen M. Ray, Est.

GRANTEE State of Vermont

RECORDED Hinesburg
BOOK 29
PAGE 59
DATE 8-21-50
REMARKS:- #2Cons.Sheet 6-#2Cons.Sheet 7

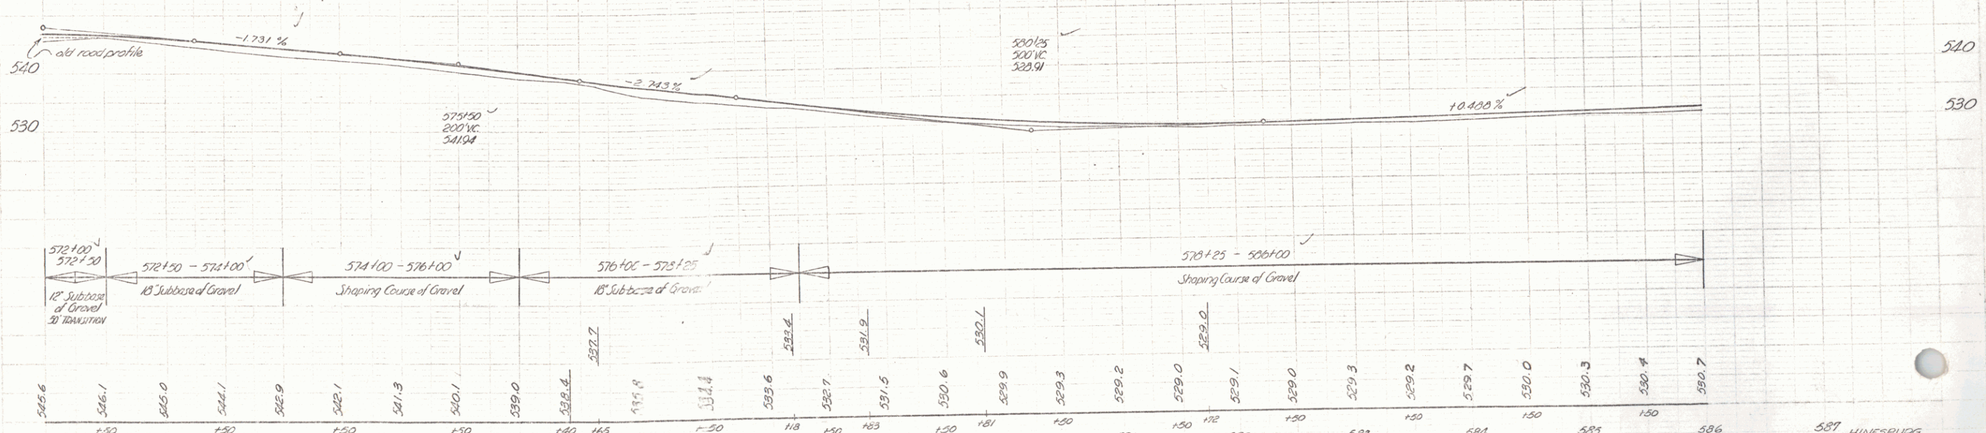

B.M. #84 - S.I.R. 15" Elm 57' Lt. of sta. 587+74 Elev. 531.26

HINESBURG
Series F no. 171(3)
Sheet 5 of 88 Sheets