F
171(3) 15 68
POST WAR F.A. PRIMARY

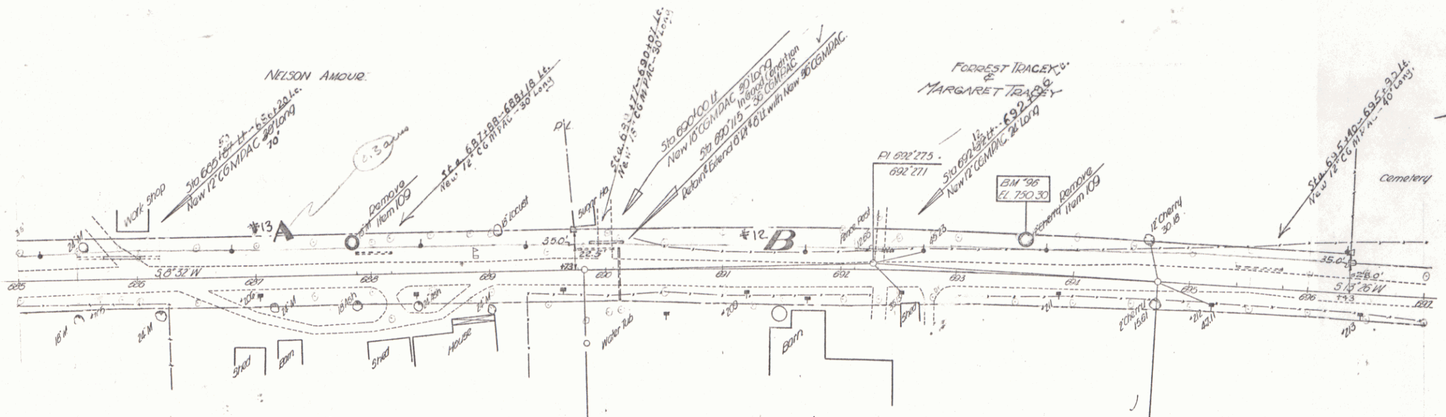

DRIVES CONSTRUCTED

Sta.	Sta.	Position
685+50	— 686+20	Lt.
685+90		Rt.
686+70		Rt.
688+00		Lt.
688+15		Rt.
688+75		Rt.
690+00		Lt.
691+25		Lt. & Rt.
692+75		Rt.
695+50	— 697+00	Lt.

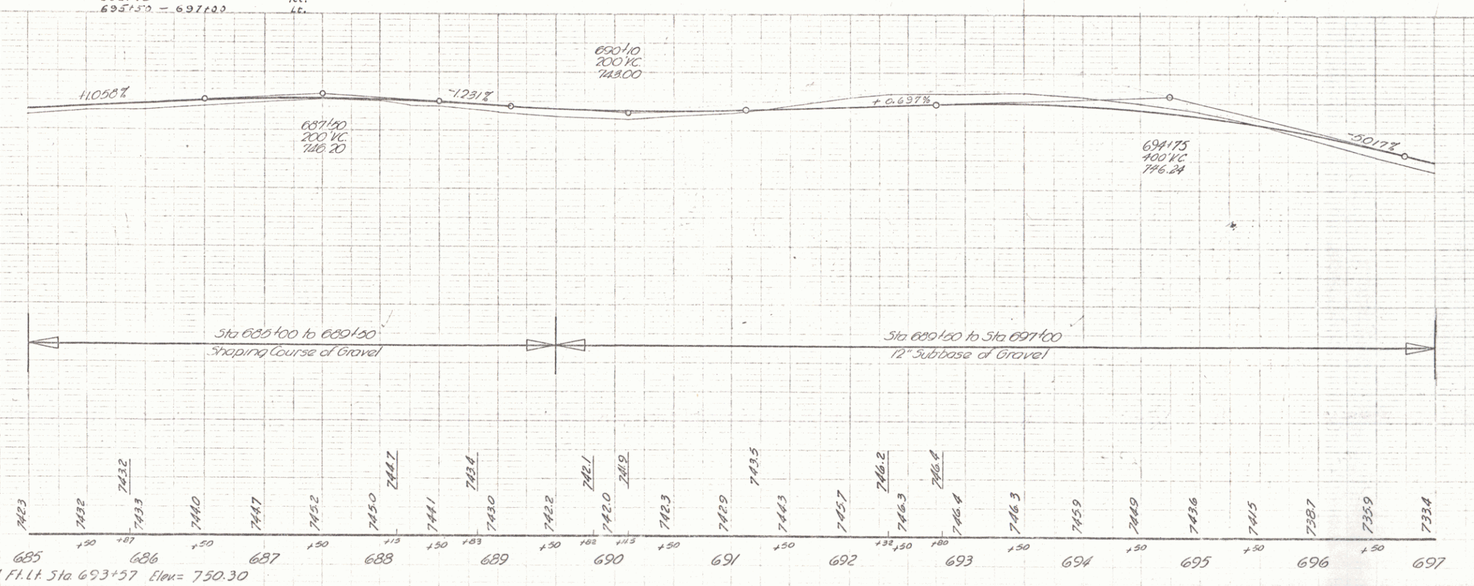

B.M #96 S.I.T. 10" Chy. 24 Ft. Lt. Sta. 693+57 Elev.= 750.30

HINESBURG
Series F no 171(3)
Sheet 15 of 28 sheets

12