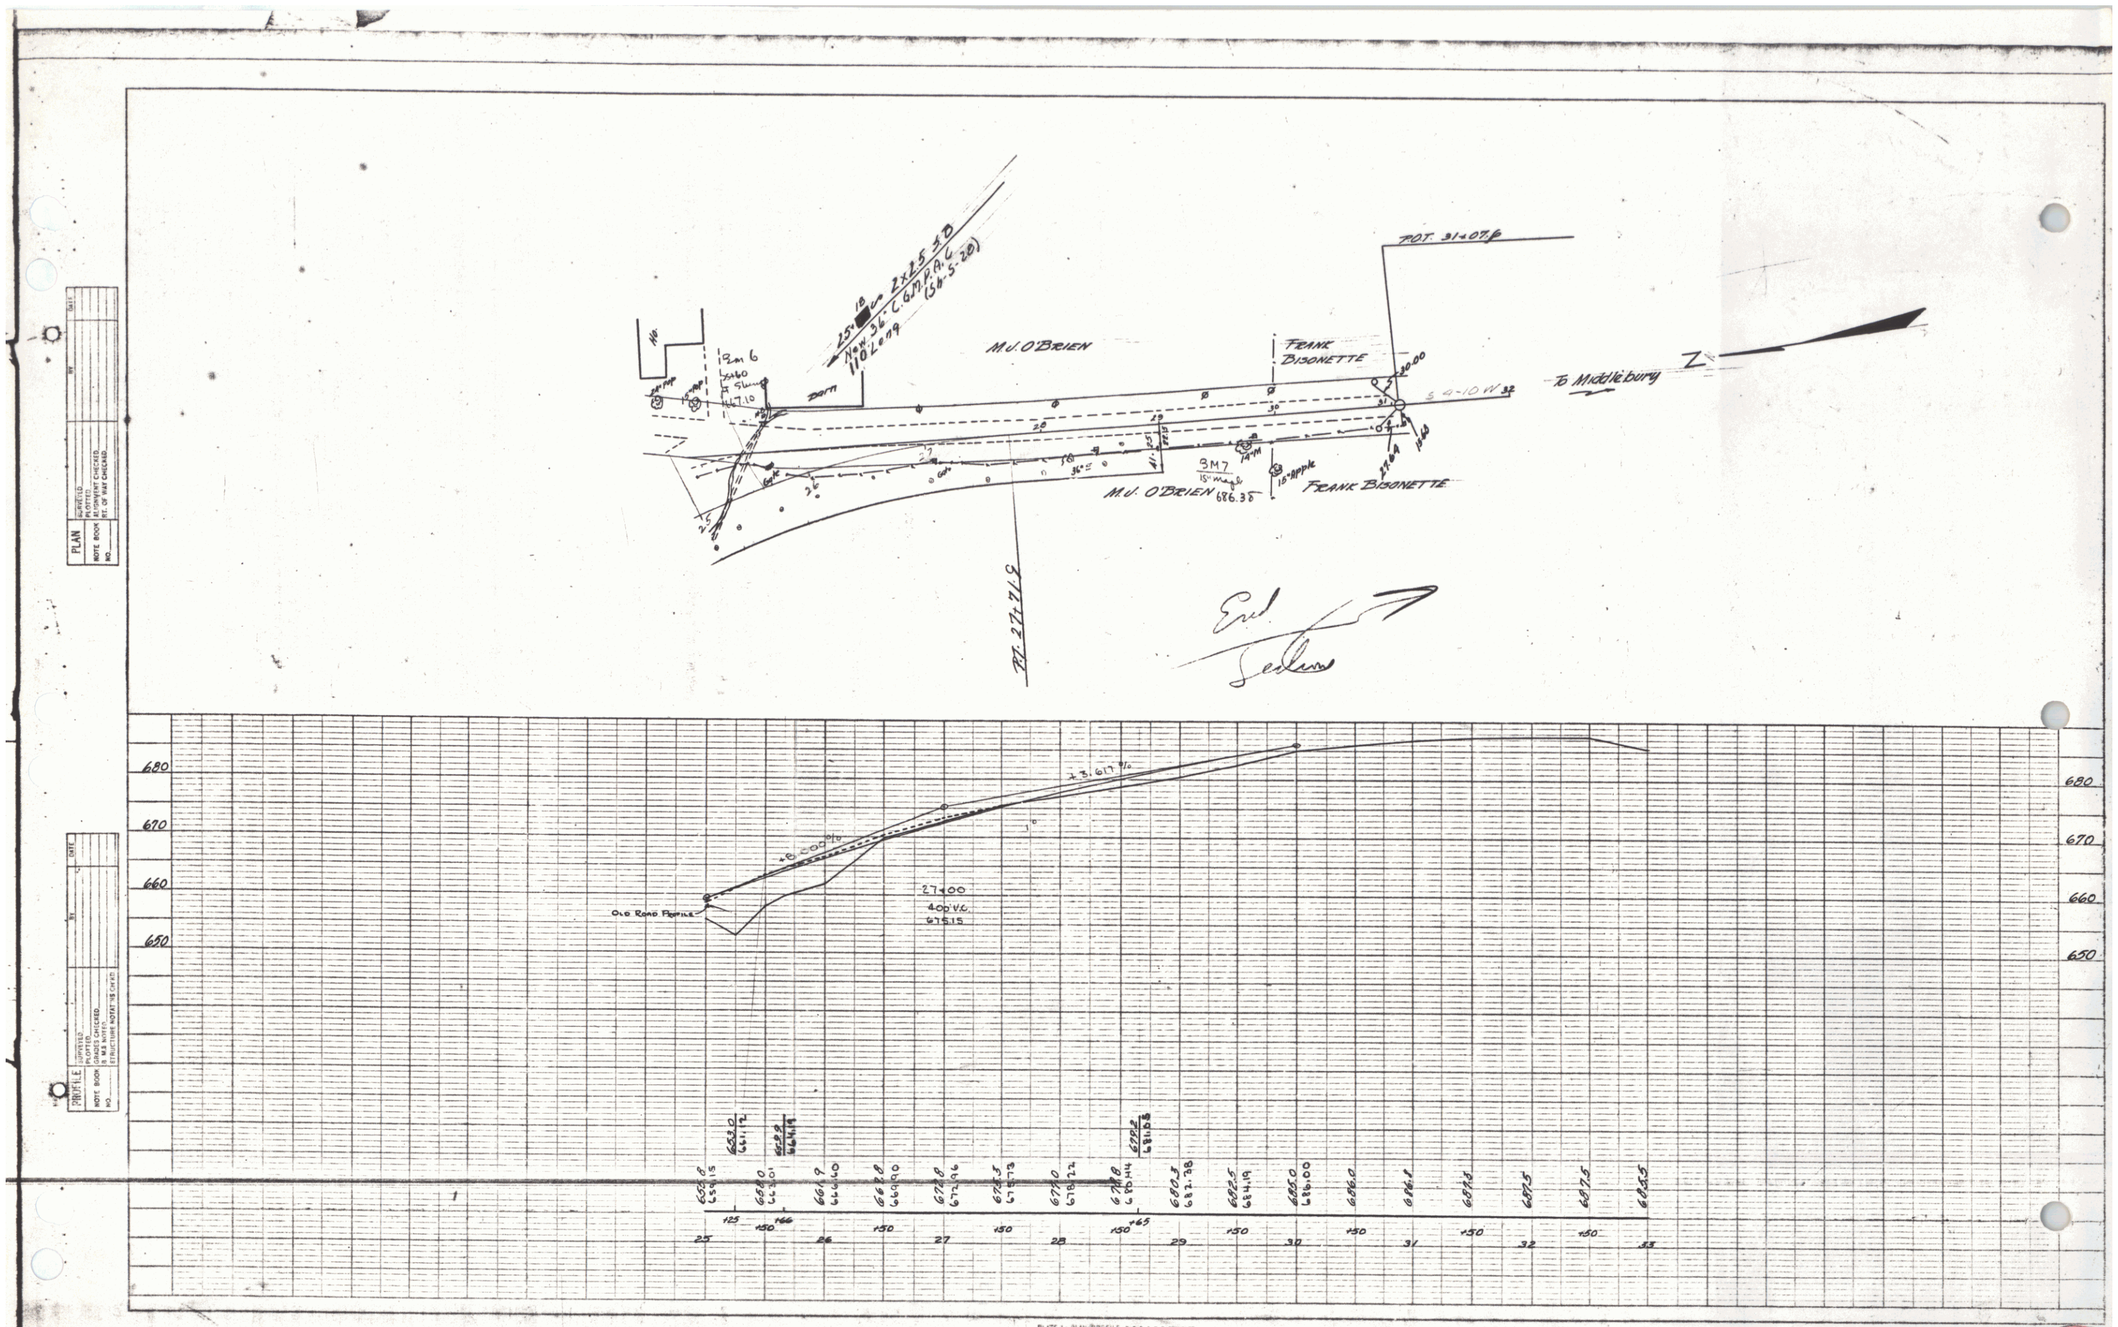

PLAN
PROFILE
NOTE BOOK
NO.
DRAWN
TRACED
CHECKED
PLOTTED
GRADES CHECKED
STRUCTURE NOTES
DATE

PLATE 1 - PLAN-PROFILE O.P.R.R. & H.E. STANDARD
KEUFFEL & ESSER CO., NEW YORK.

Hinesburg SHEET 4

13.