PARCEL	INSTRUMENT	DATE	GRANTOR	GRANTEE	RECORDED HINESBURG BOOK	PAGE	DATE	REMARKS
A	W.D.DE	8-5-40	EVERETTE P STYGLES	ST. OF VT.	27	77	8-23-40	
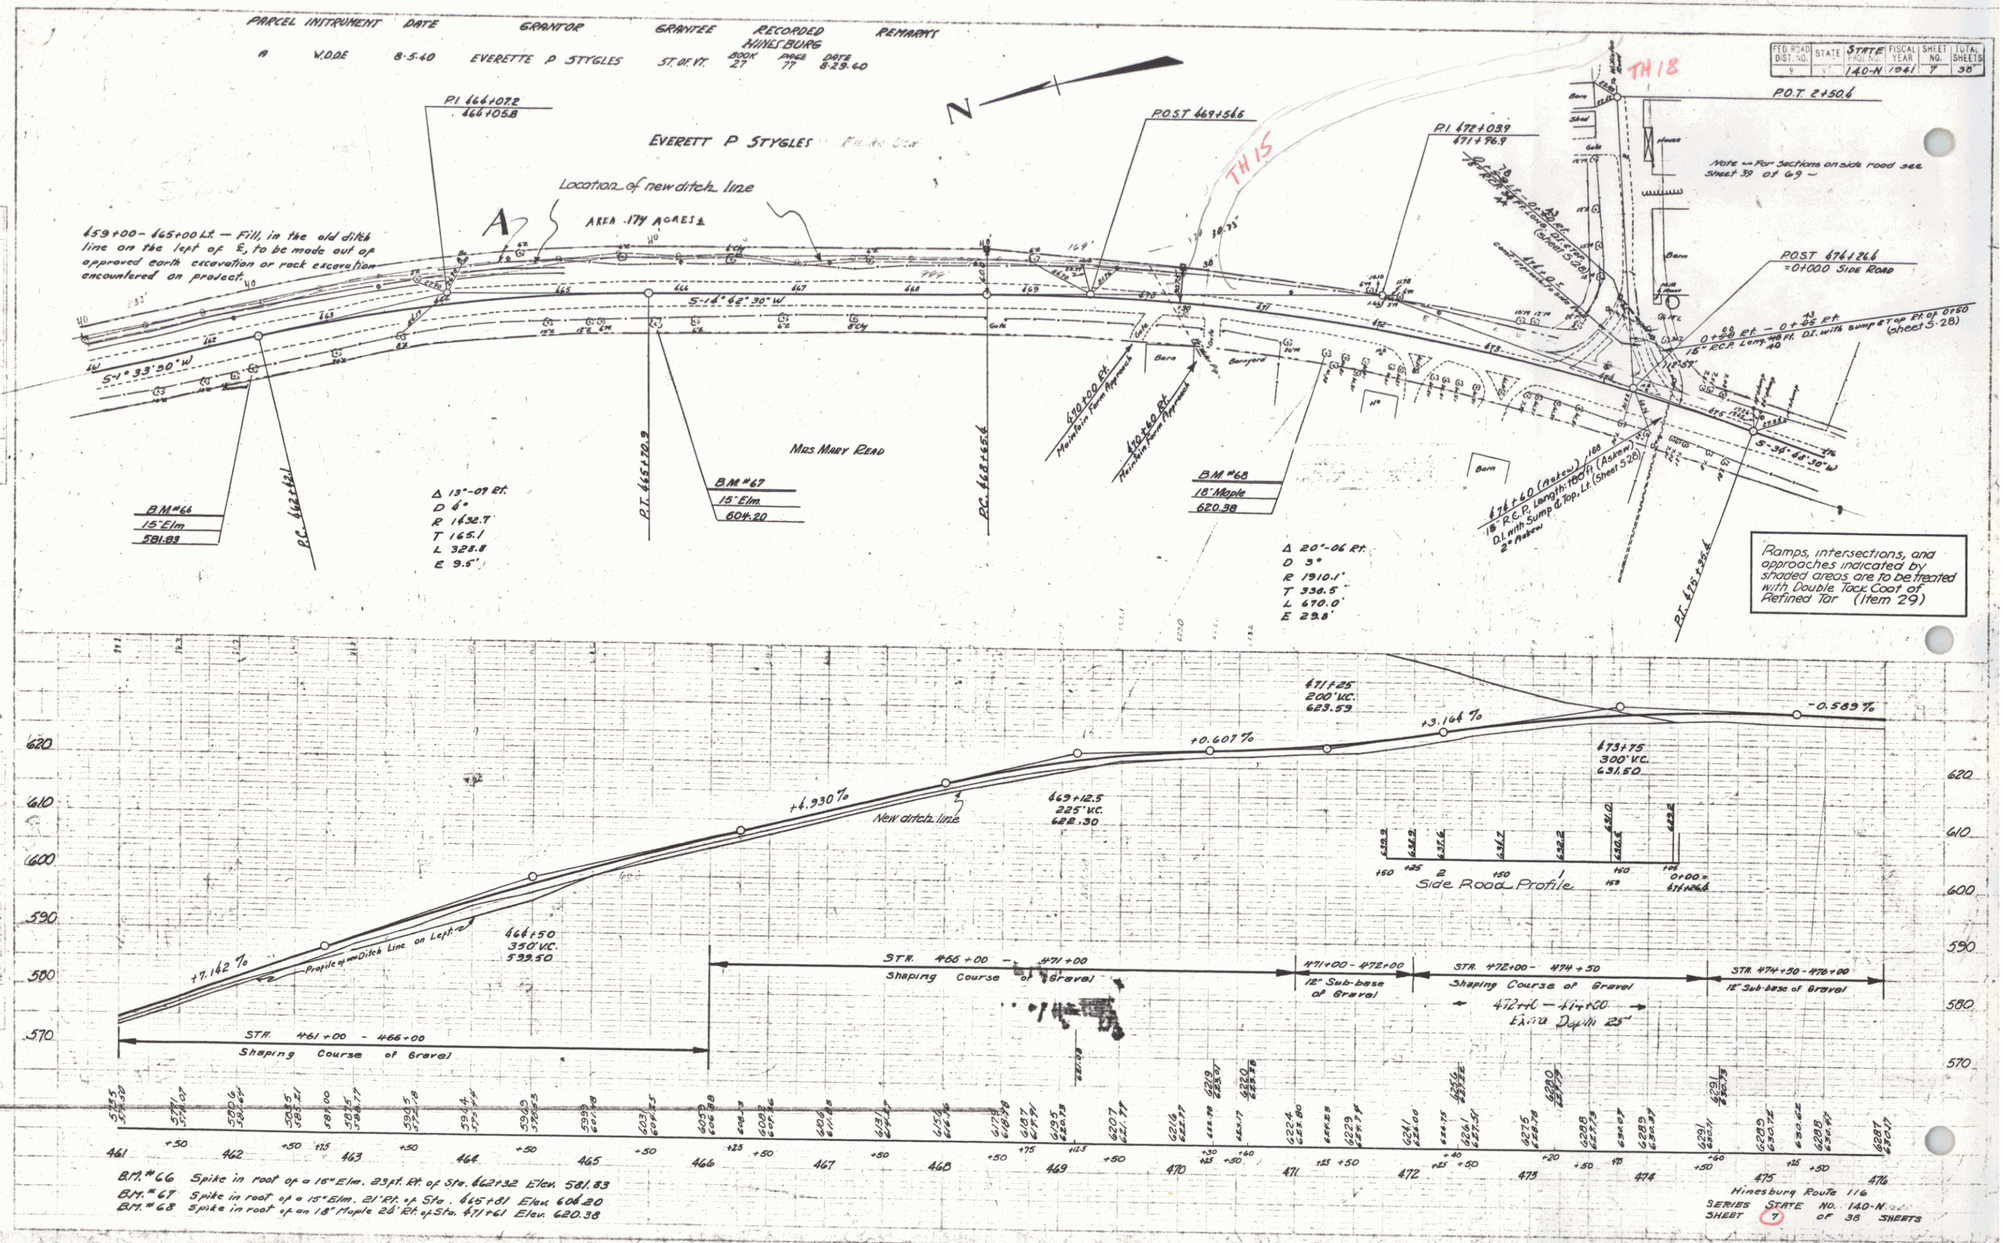
FED. ROAD DIST. NO.	STATE	STATE PROJ. NO.	FISCAL YEAR	SHEET NO.	TOTAL SHEETS
9	VT.	140-N	1941	7	38