FED. ROAD DIST. NO.	STATE	EXTENSION State PROJ. NO.	FISCAL YEAR	SHEET NO.	TOTAL SHEETS
5	VT.	IAO-N	1941	5	29

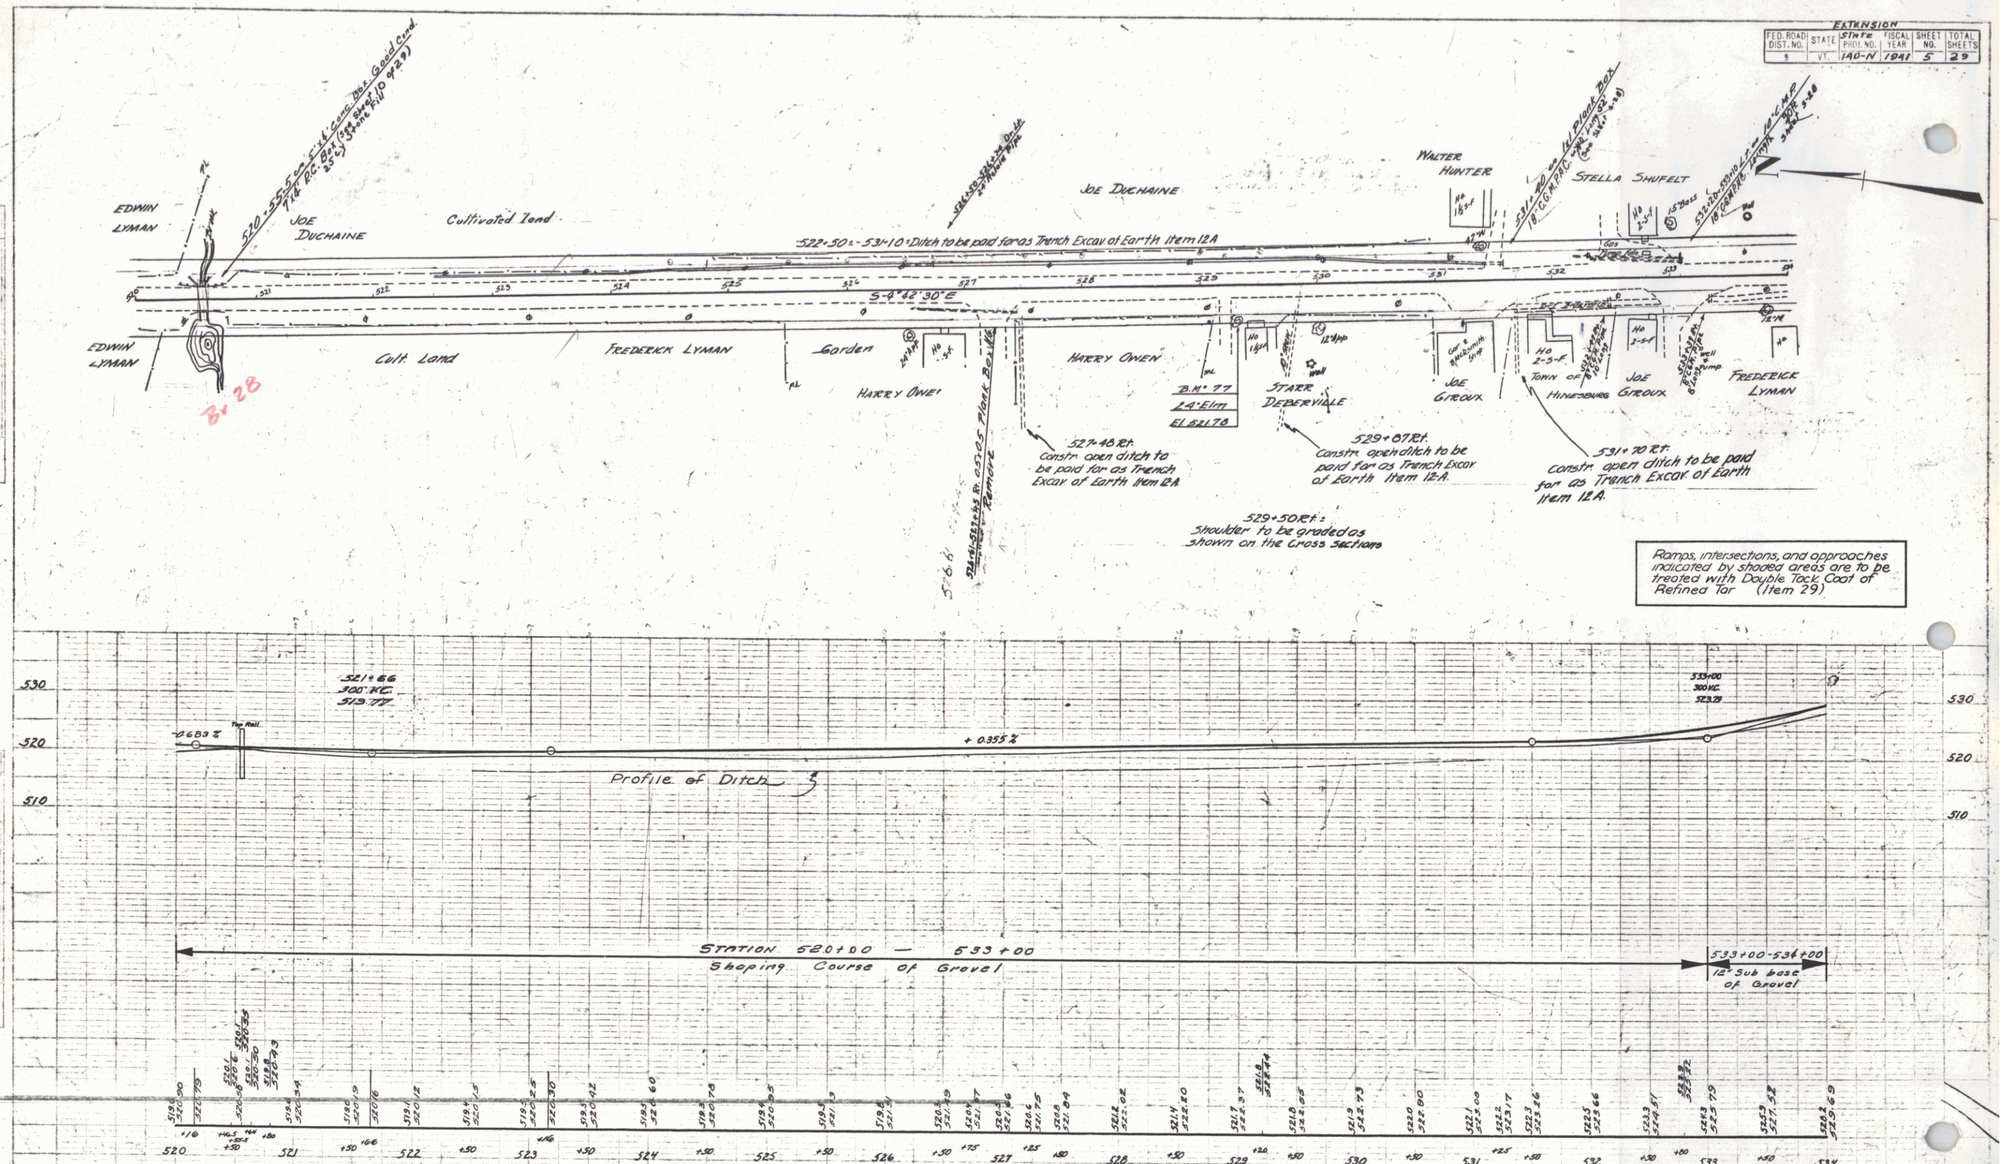

Hinesburg Route 116
SERIES EXTENSION STATE IAO-N
SHEET 5 OF 29 SHEETS