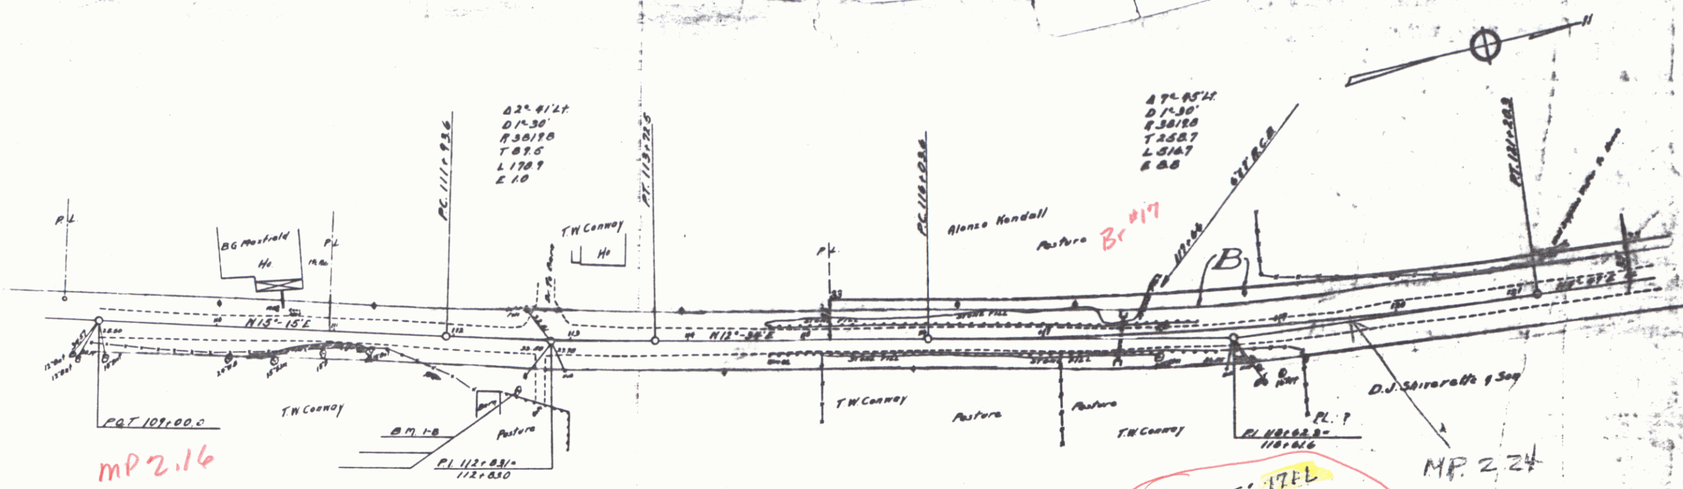
PL
B.G. Mosfield
Ho
N13°-15'E
PC 111+93.6
Δ 2°-41'Lt.
D 1°-30'
R 3818.8
T 87.6
L 170.9
E 1.0
T.W. Conway
Ho
PC 113+72.5
N12°-34'E
Alonzo Kendall
Pasture
Δ 7°-45'Lt.
D 1°-30'
R 3818.8
T 258.7
L 516.7
E 8.8
(B)
D.J. Sciarretta & Son
PGT 109+00.0
T.W. Conway
BM 1-8
Pasture
PI 112+03.1=
112+63.0
T.W. Conway
Pasture
Pasture
T.W. Conway
PL ?
PI 118+02.8=
118+62.6
mP 2.16
MP 2.24
PROJECT: 171L
Date 01/01/1936
TOWN: STARKSBORO
Pin: 00R501
Route: VT 116
MP 2.16-3.92
STARKSBORO Proj 171-L
SHEET 19