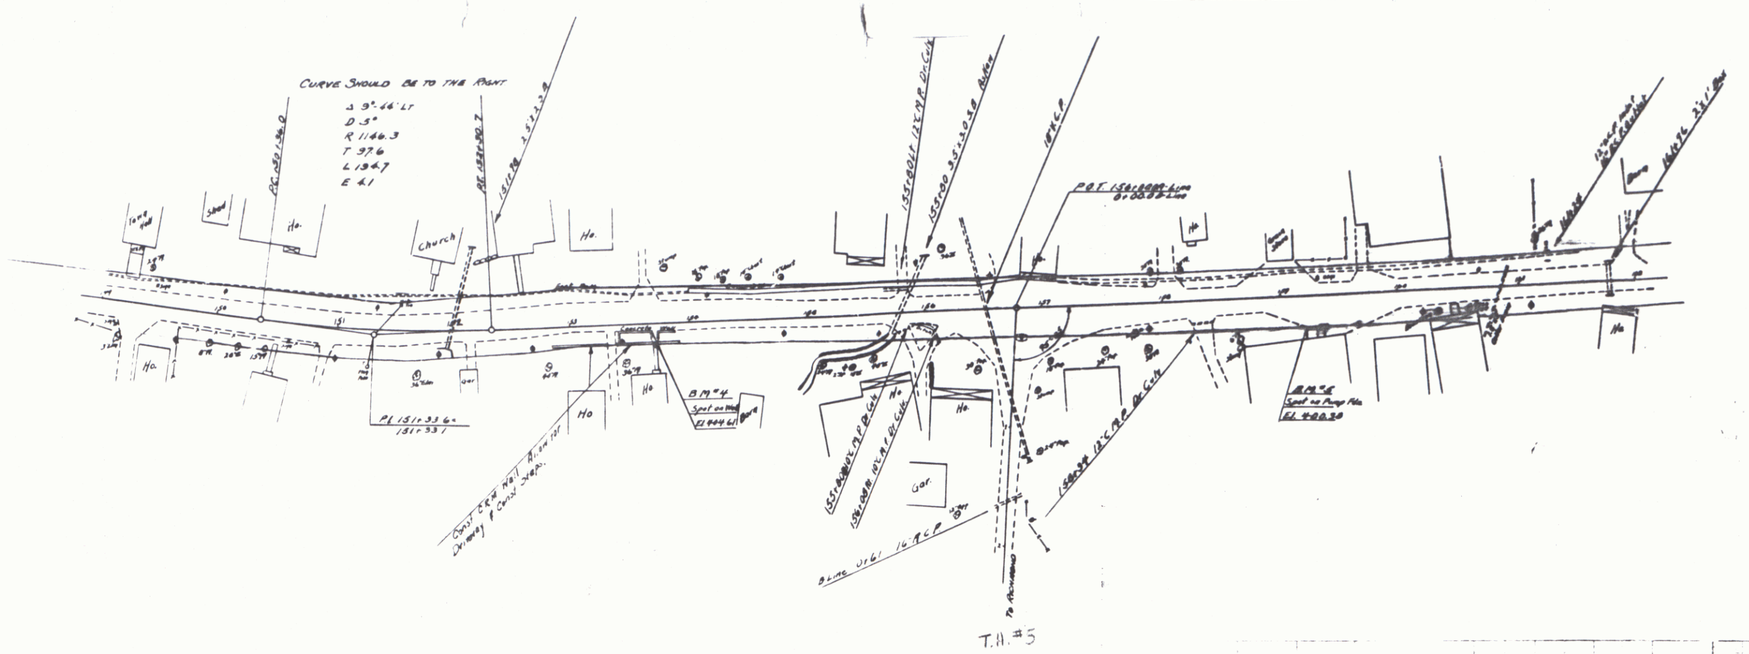

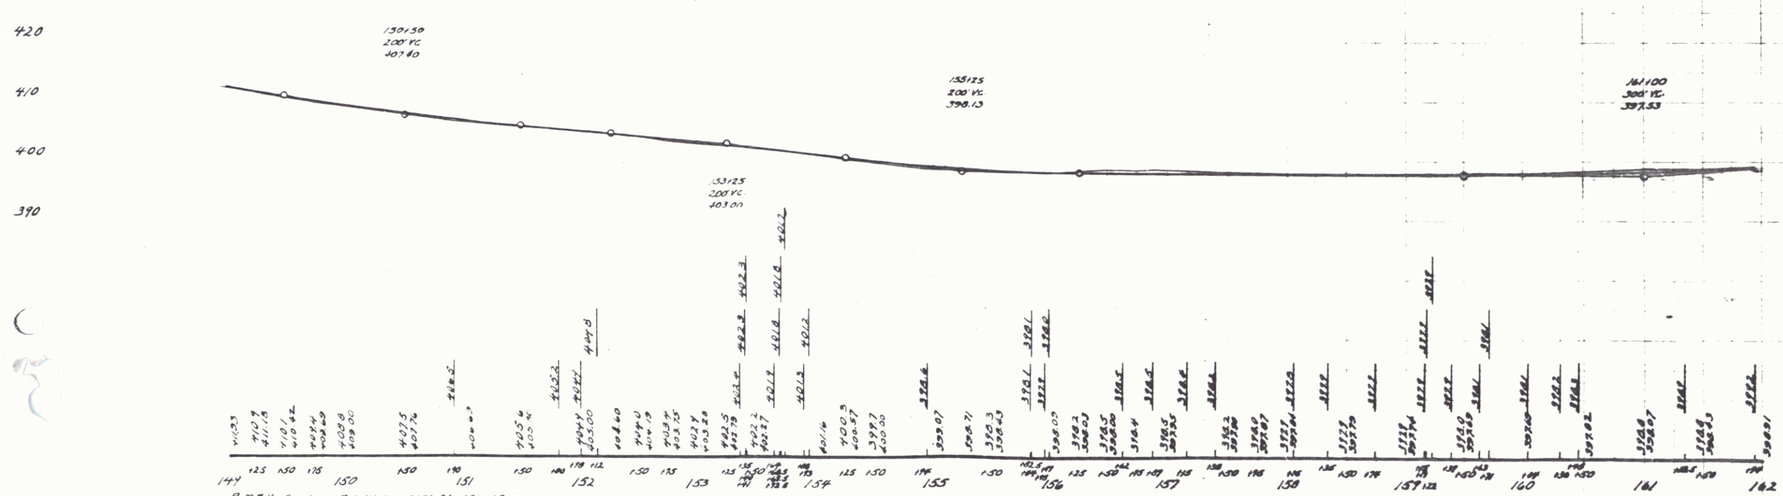

BM #4 Spot on Pet Well 6.5 ft. Sta 153+68 El 404.61
BM #5 Spot on Gas Pump Fdn 1.5 ft. Sta 157+38 El 400.30

STATE HIGHWAY
STATE 171-L

SHEET 4

4