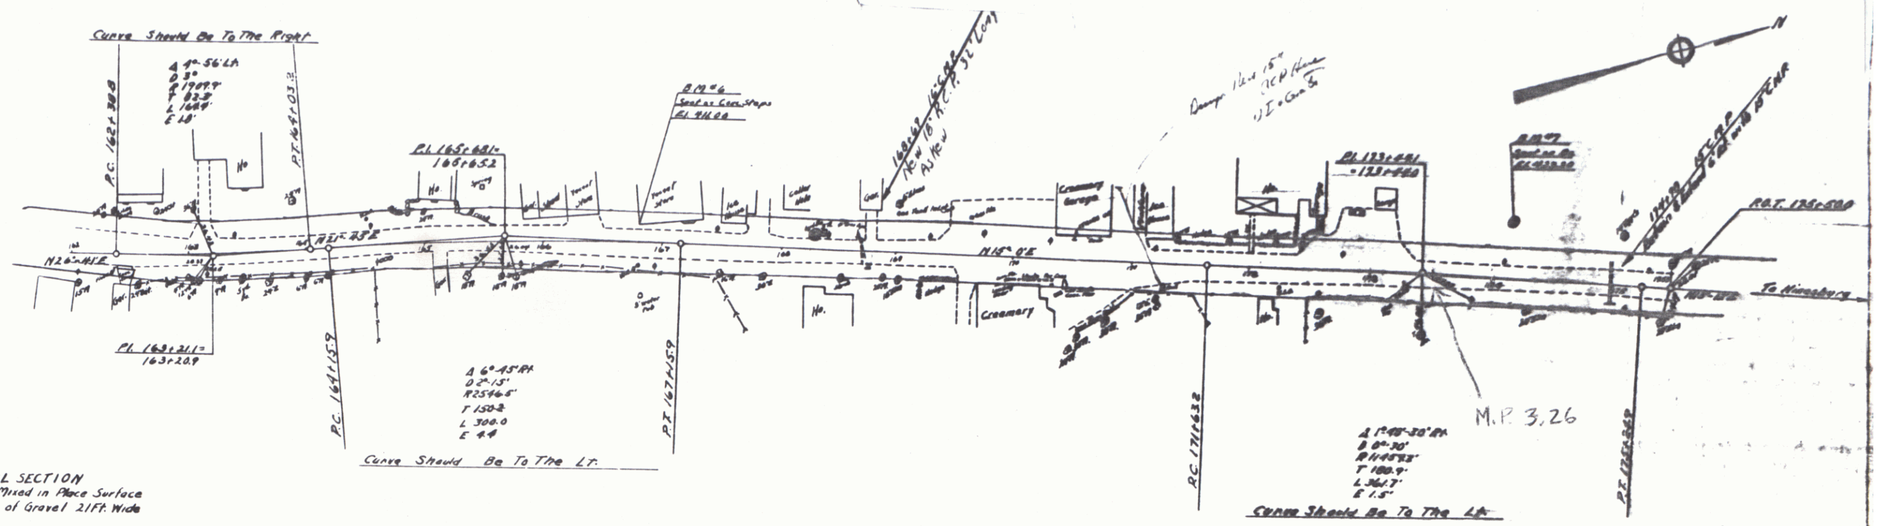

TYPICAL SECTION
20 Ft - 2½" Mixed in Place Surface
12" Sub-base of Gravel 21 Ft. Wide

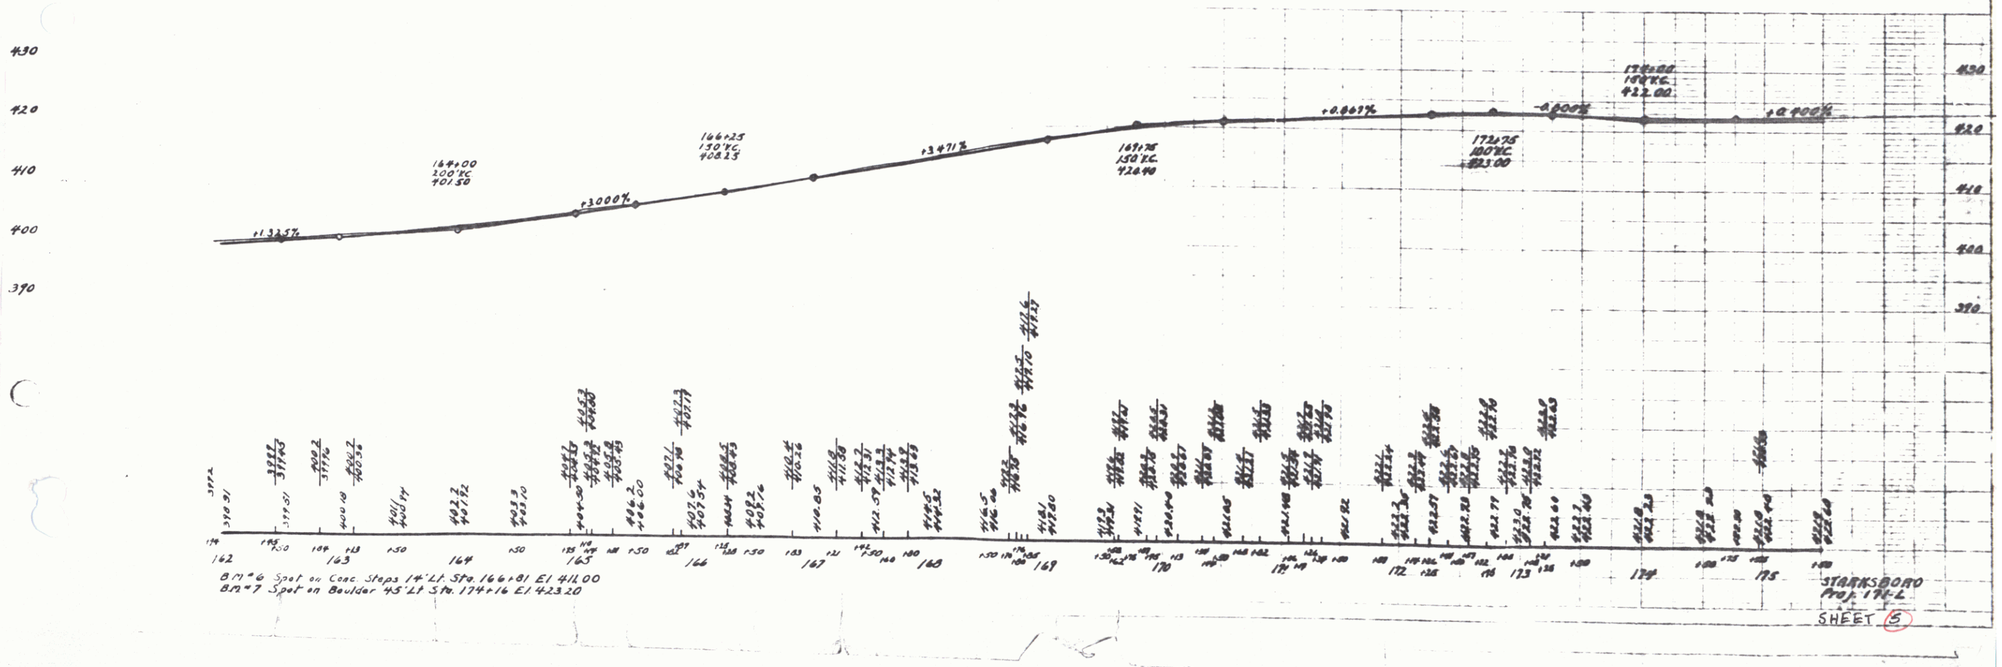

STARKSBORO
Proj. 174-L
SHEET 5